



H:\JDF\08\08\04\02\02\Addison\AS BUILT.DWG, 9/22/09 4:01:20 PM, JDIR ENGINEERS & CONSULTANTS, INC. - SAS

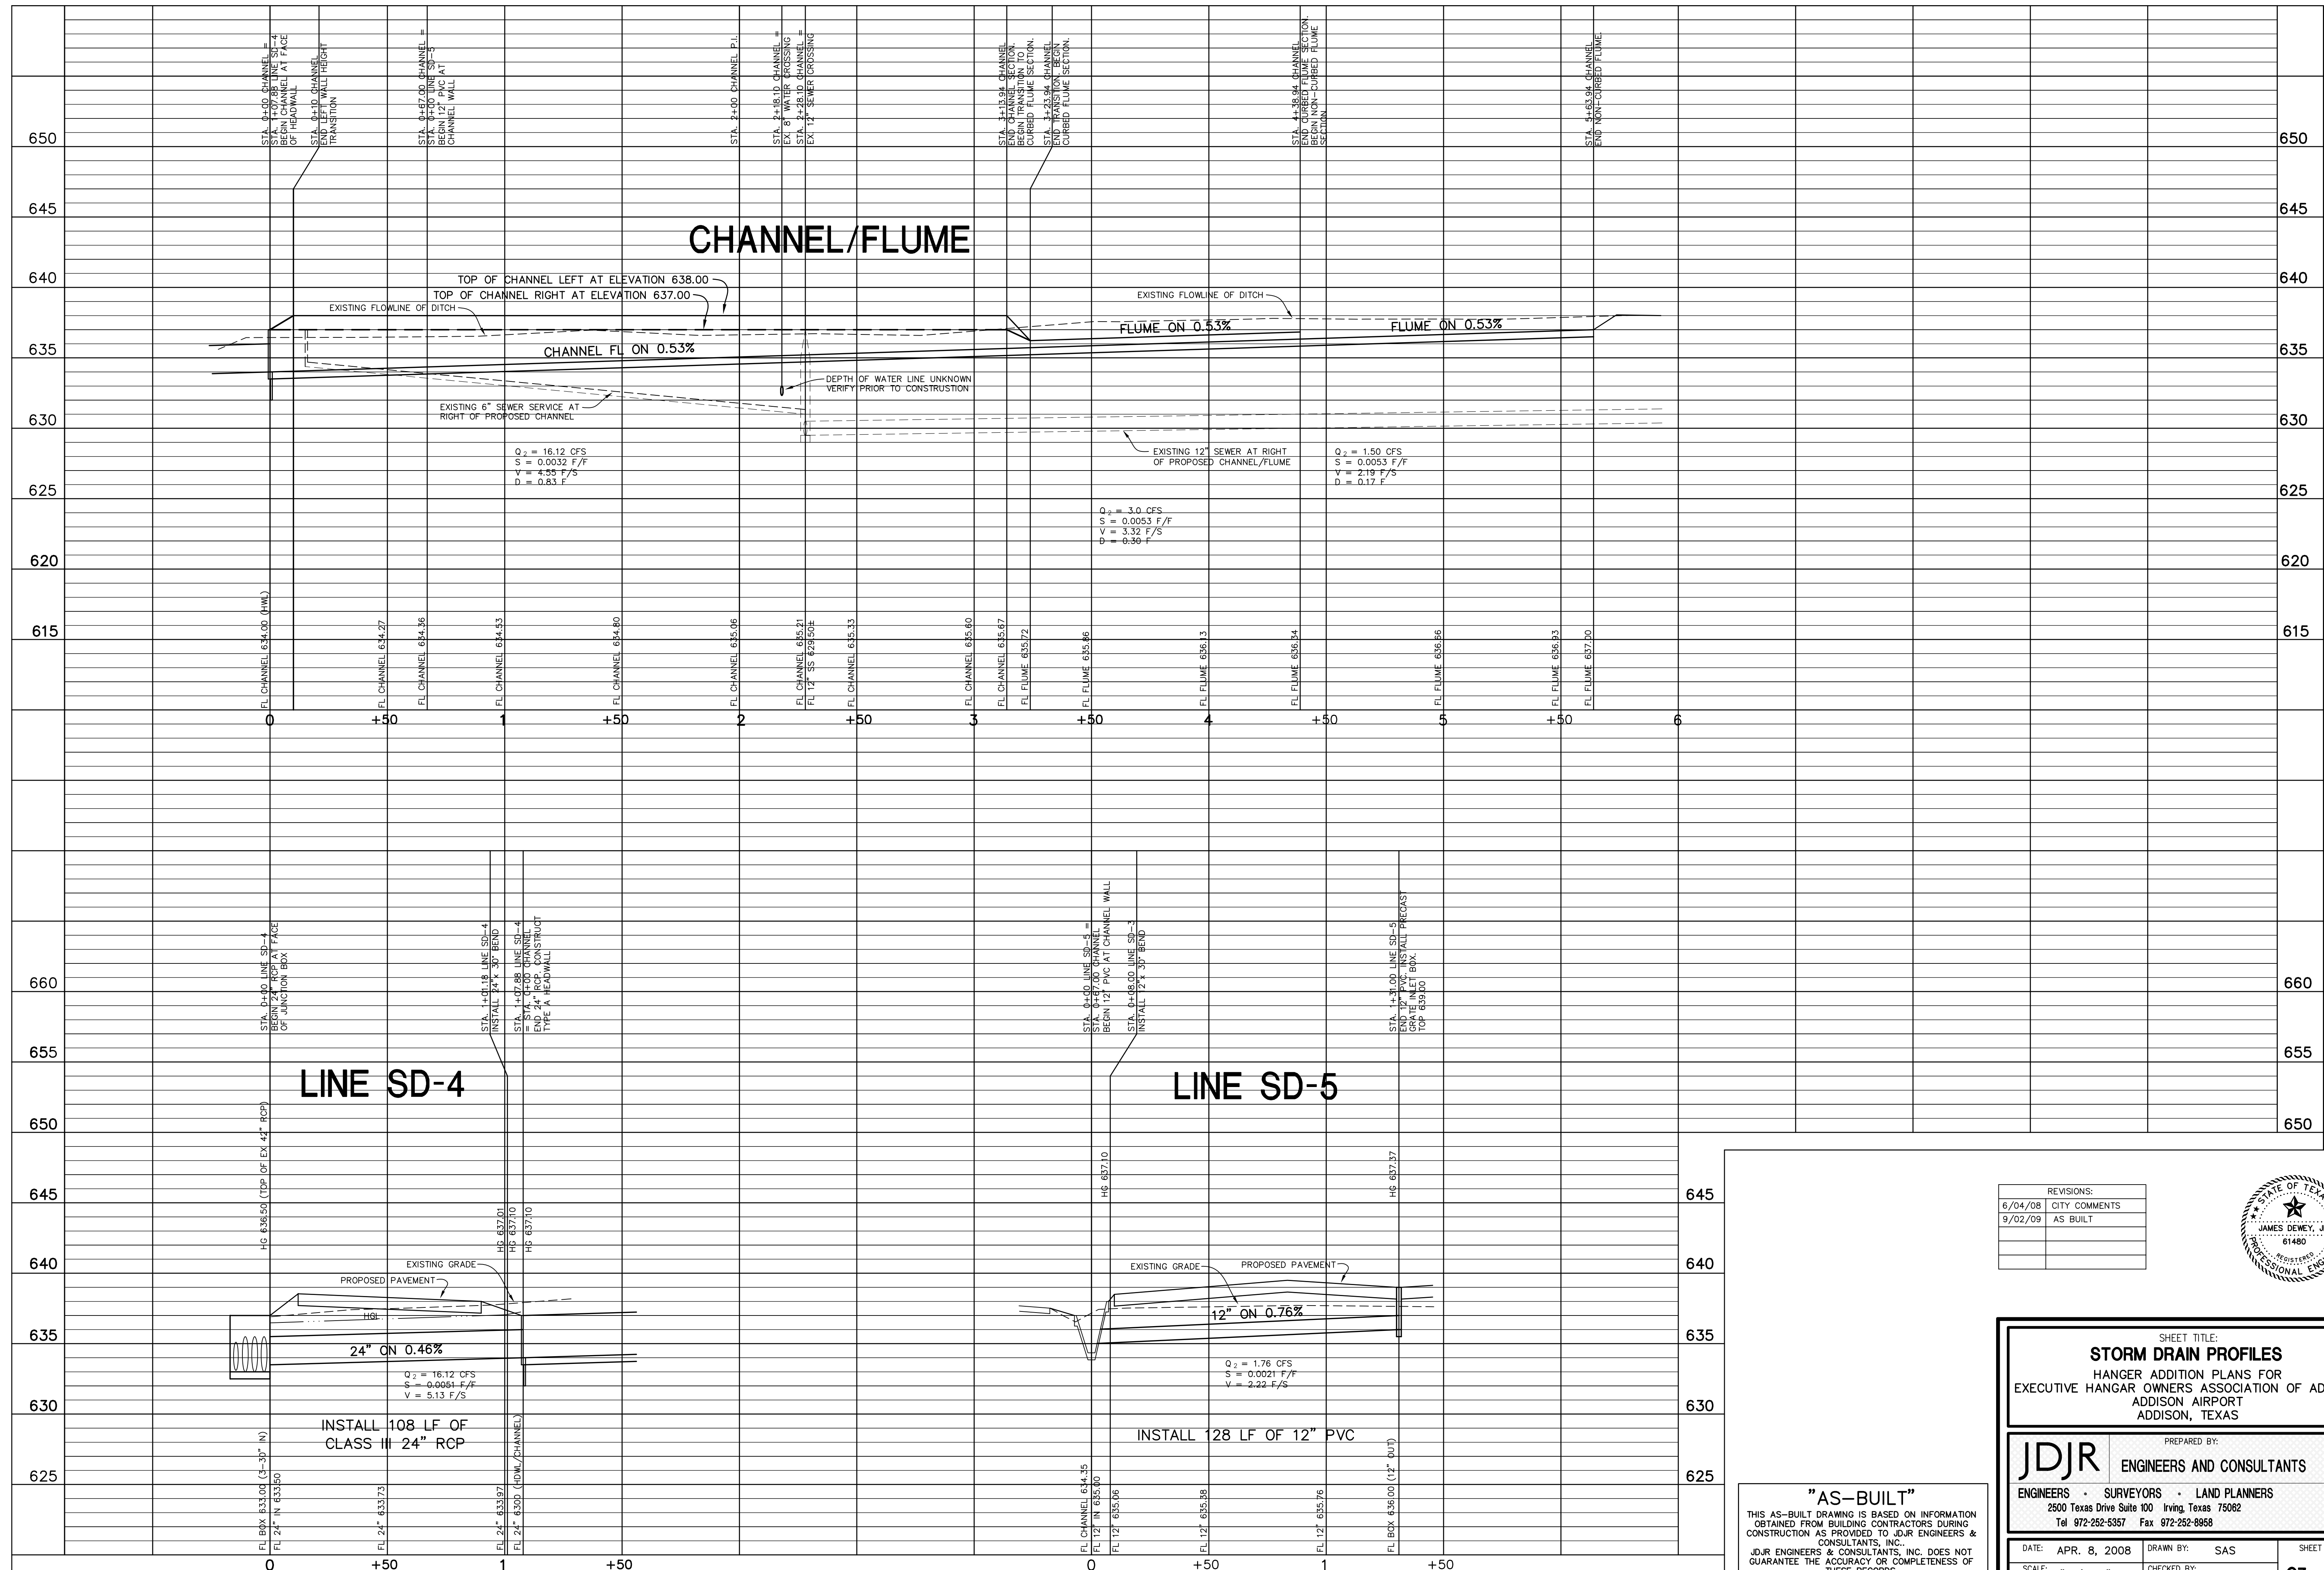

REVISIONS:	
6/04/08	CITY COMMENTS
9/02/09	AS BUILT

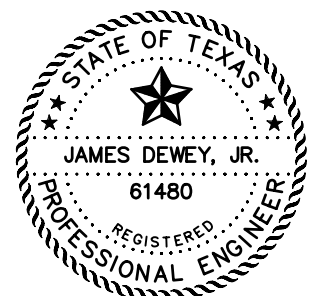

SHEET TITLE:
STORM DRAIN PROFILES
HANGER ADDITION PLANS FOR
EXECUTIVE HANGAR OWNERS ASSOCIATION OF ADDISON
ADDISON AIRPORT
ADDISON, TEXAS

PREPARED BY:
JDJR ENGINEERS AND CONSULTANTS
ENGINEERS • SURVEYORS • LAND PLANNERS
2500 Texas Drive Suite 100 Irving, Texas 75062
Tel 972-252-5357 Fax 972-252-8958

"AS-BUILT"
THIS AS-BUILT DRAWING IS BASED ON INFORMATION OBTAINED FROM BUILDING CONTRACTORS DURING CONSTRUCTION AS PROVIDED TO JDIR ENGINEERS & CONSULTANTS, INC.
JDIR ENGINEERS & CONSULTANTS, INC. DOES NOT GUARANTEE THE ACCURACY OR COMPLETENESS OF THESE RECORDS.

DATE: APR. 8, 2008 DRAWN BY: SAS SHEET NO.
SCALE: 1"=3'H, 1"=5'V CHECKED BY: JDJR **C7** OF 10