


GENERAL NOTES:

1. THE GENERAL CONTRACTOR AND OWNER RESPONSIBLE FOR PREVENTING SEDIMENT AND OTHER POLLUTANTS FROM LEAVING THE SITE. CARE SHALL BE EXERCISED TO PREVENT THE FLOW OR OFF-SITE TRACKING OF SEDIMENT AND OTHER POLLUTANTS TO ADJACENT PAVED DRIVEWAYS, ROADWAYS, INLETS AND STORM DRAIN SYSTEM.
2. ALL LOCATIONS USED AS AN EXIT MUST HAVE ROCK STABILIZATION 50' MINIMUM LENGTH, 3" DIAMETER STONE OVER GEOTEXTILE FABRIC.
3. THE STABILIZED CONSTRUCTION ENTRY/EXIT SHALL BE USED AS A WHEEL WASH AREA FOR ALL TRUCKS LEAVING THE SITE.
4. A BERM OR OTHER SPILL PROTECTION MEASURE SHALL BE CONSTRUCTED FOR ANY TEMPORARY FUEL STORAGE TANKS ON SITE DURING CONSTRUCTION.
5. ALL TRASH SHALL BE CONTAINED IN AN ENCLOSURE UNTIL PROPER DISPOSAL AT OFF-SITE FACILITIES.
6. VEHICLE PARKING AREAS, STAGING AREAS, STOCKPILES, SPOILS, ETC. SHALL BE LOCATED SUCH THAT THEY WILL NOT ADVERSELY AFFECT STORM WATER QUALITY. OTHERWISE, COVERING OR ENCIRCLING THE AREAS WITH PROTECTIVE MEASURES SHALL BE NECESSARY.
7. A DENSITY OF TEMPORARY OR PERMANENT GROUND COVER (I.E., VEGETATION, EROSION CONTROL, MATTING, ETC.) SUFFICIENT TO PREVENT EROSION SHALL BE ESTABLISHED ON ALL SWALES AND SLOPES IN A TIMELY MANNER IN ORDER TO PREVENT EROSION PROBLEMS FROM DEVELOPING IN THESE AREAS.
8. ALL SURFACE AREAS DISTURBED WITHIN OR ADJACENT TO THE CONSTRUCTION LIMITS MUST BE PERMANENTLY STABILIZED. STABILIZATION IS OBTAINED WHEN THE SITE IS COVERED WITH IMPERVIOUS STRUCTURES, PAVING OR A UNIFORM PERENNIAL VEGETATIVE COVER. THE PERENNIAL VEGETATION MUST HAVE A COVERAGE DENSITY OF AT LEAST 70 PERCENT. STABILIZATION IS REQUIRED BEFORE TERMINATING MAINTENANCE AND REMOVAL OF EROSION CONTROL MEASURES.
9. ALL PERIMETER EROSION CONTROL MEASURES AND A ROCK STABILIZED ENTRY/EXIT MUST BE IN PLACE BEFORE STARTING SOIL DISTURBING ACTIVITIES.
10. EROSION CONTROL MEASURES THAT PROVE TO BE INEFFECTIVE SHALL BE REPLACED WITH MORE EFFECTIVE MEASURES OR ADDITIONAL MEASURES.
11. A MAINTENANCE PROGRAM FOR ALL PROPOSED EROSION CONTROL MEASURES SHALL BE ESTABLISHED.
12. TO PREVENT ENTRY OF SEDIMENT INTO PROPOSED STORM SEWERS DURING CONSTRUCTION, INSTALL PIPE SEDIMENT FILTER OR SEDIMENT FILTER OR SEDIMENT BARRIER AT THE END OF EACH WORK DAY.
13. CONTRACTOR TO CONSTRUCT A PIT OR WASH BASIN ON-SITE FOR WASH-OUT OF CONCRETE TRUCKS.
14. IF PUMPS ARE USED TO REMOVE WATER FROM PONDED AREAS, FILTER THE DISCHARGE TO REMOVE SEDIMENT AND OTHER POLLUTANTS BEFORE THE WATER LEAVES THE SITE OR ENTERS STORM DRAIN SYSTEM. DO NOT BYPASS SILT BARRIERS OR INLET SEDIMENT FILTERS WITH THE DISCHARGE.
15. TO PREVENT DAMAGE TO VEGETATION IN DOWNSTREAM WATER COURSES, LIMIT ANY PROPOSED LIME STABILIZATION OPERATIONS TO THAT WHICH CAN BE MIXED AND COMPACTED BY THE END OF EACH WORK DAY. A SILT FENCE IS NOT EFFECTIVE IN FILTERING LIME SINCE THE GRAIN SIZE IS SIGNIFICANTLY SMALLER THAN THE OPENING IN THE FABRIC.
16. THE CONTRACTOR(S) SHALL INSPECT EROSION CONTROL MEASURES AT LEAST ONCE EACH WEEK AND WITHIN 24 HOURS AFTER A STORM EVENT OF 1/2 INCH OR GREATER. REPAIR OR REPLACE DAMAGED MEASURES AS NECESSARY TO RETAIN SEDIMENT ON SITE. EROSION CONTROL MEASURES THAT PROVE TO BE INEFFECTIVE SHALL BE REPLACED WITH MORE EFFECTIVE MEASURES OR ADDITIONAL MEASURES WITHIN SEVEN (7) CALENDAR DAYS.
17. FOR ALTERNATIVE STABILIZATION AND EROSION CONTROL MEASURES, REFER TO THE CONSTRUCTION BEST MANAGEMENT PRACTICES (BMP) MANUAL PUBLISHED BY NORTH CENTRAL TEXAS COUNCIL OF GOVERNMENTS.
18. CONTRACTOR TO CHECK AREAS ADJACENT TO PROPERTY DAILY FOR CONSTRUCTION WASTE MATERIALS AND DEBRIS THAT HAVE BLOWN OR WASHED OFF-SITE AND REMOVE IMMEDIATELY.
19. CONTAIN ALL RUNOFF FROM MATERIALS USED IN THE SUBGRADE STABILIZATION PROCESSTO EACH I.S.
20. INLET PROTECTION TO REMAIN IN PLACE UNTIL DRAINAGE AREAS CONTRIBUTING TO EACH INLET IS ESTABLISHED WITH VEGETATION (LAWN).

"AS-BUILT"
 THIS AS-BUILT DRAWING IS BASED ON INFORMATION OBTAINED FROM BUILDING CONTRACTORS DURING CONSTRUCTION AS PROVIDED TO JDR ENGINEERS & CONSULTANTS, INC.
 JDR ENGINEERS & CONSULTANTS, INC. DOES NOT GUARANTEE THE ACCURACY OR COMPLETENESS OF THESE RECORDS.

REVISIONS:	
6/04/08	CITY COMMENTS
7/25/08	CITY COMMENTS
8/01/08	CITY COMMENTS
8/05/08	CITY COMMENTS
9/02/09	AS BUILT

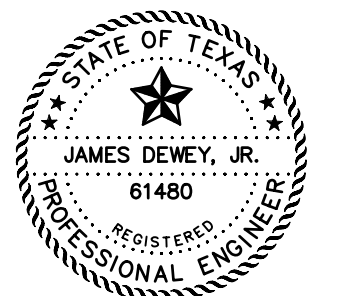

LEGEND

- 5.45 EXISTING CONTOUR LINE
- PROPOSED SILT FENCE
- PROPOSED STABILIZED CONSTRUCTION ENTRANCE
- INLET CONTROL - SILT FENCE CONSTRUCTED 5' MAX. AROUND INLET

SHEET TITLE:
EROSION CONTROL PLAN
 HANGER ADDITION PLANS FOR
 EXECUTIVE HANGER OWNERS ASSOCIATION OF ADDISON
 ADDISON AIRPORT
 ADDISON, TEXAS

PREPARED BY:
JDR ENGINEERS AND CONSULTANTS

ENGINEERS • SURVEYORS • LAND PLANNERS
 2500 Texas Drive Suite 100 Irving, Texas 75062
 Tel 972-252-5357 Fax 972-252-8958

DATE: APR. 8, 2008 DRAWN BY: SAS SHEET NO.
 SCALE: 1" = 30' CHECKED BY: JDR **C9** OF 10