


PLANS FOR REMOVAL, GRADING AND PAVING ADDISON AIRPORT ASPHALT PAVEMENT IMPROVEMENTS


1506
5070
RECORD SET

SUPER KEN WHITELEY - ADVANCED PAVING
Cell - 214-326-4296

ECS-DWIGHT GOODY
469-231-2961 ext / 972 392 3222

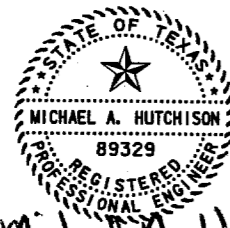

Michael A. Hutchison
12/27/05

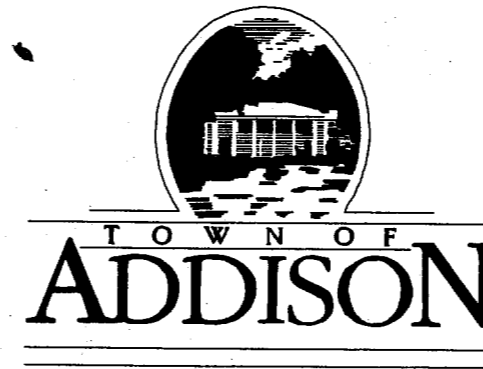


<u>JOE CHOW</u> MAYOR	
<u>JIMMY NIEMANN</u> MAYOR PRO TEMPORE	<u>GREGORY S. HIRSCH</u> DEPUTY MAYOR PRO TEMPORE
<u>TOM BRAUN</u> ROGER S. MELLOW	<u>DIANE MALLORY</u> DENNIS KRAFT
COUNCIL MEMBERS	
<u>RON WHITEHEAD</u> CITY MANAGER	
<u>NANCY CLINE, P.E.</u> DIRECTOR OF PUBLIC WORKS	

OWNER:


TOWN OF ADDISON
DEPT. OF PUBLIC WORKS
16801 WESTGROVE
P.O. BOX 9010
ADDISON, TX 75001-9010
(972) 450-2871

ENGINEER:

HNTB CORPORATION
5910 W. PLANO PARKWAY, STE 200
DALLAS, TX 75093
(972) 661-5626

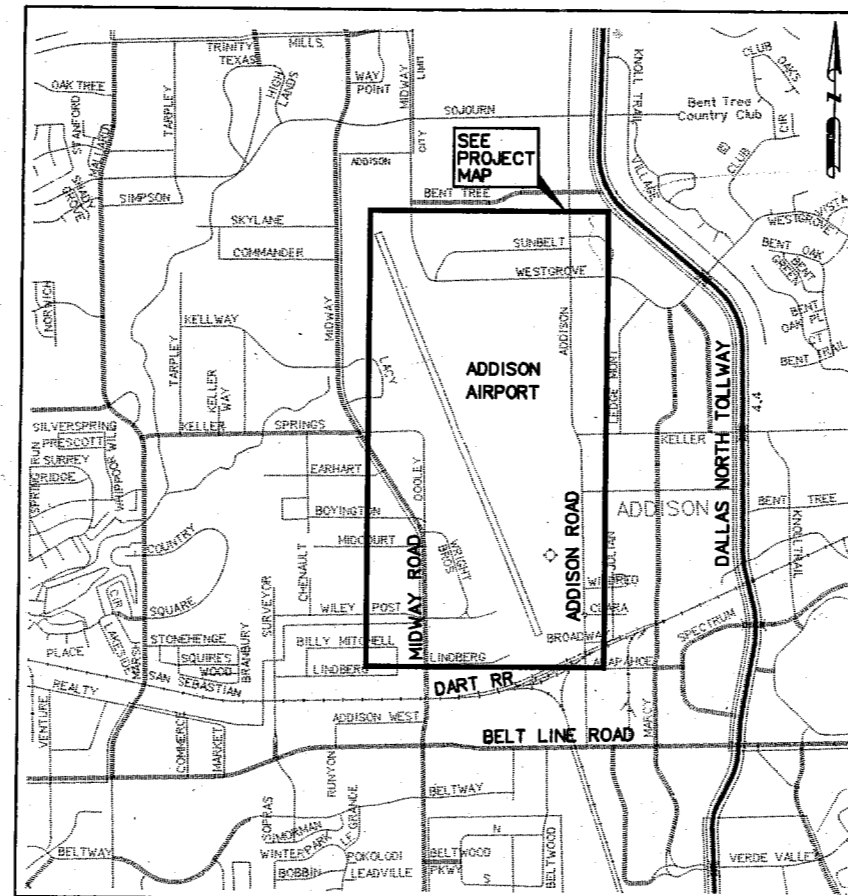

LOCATION MAP
NOT TO SCALE

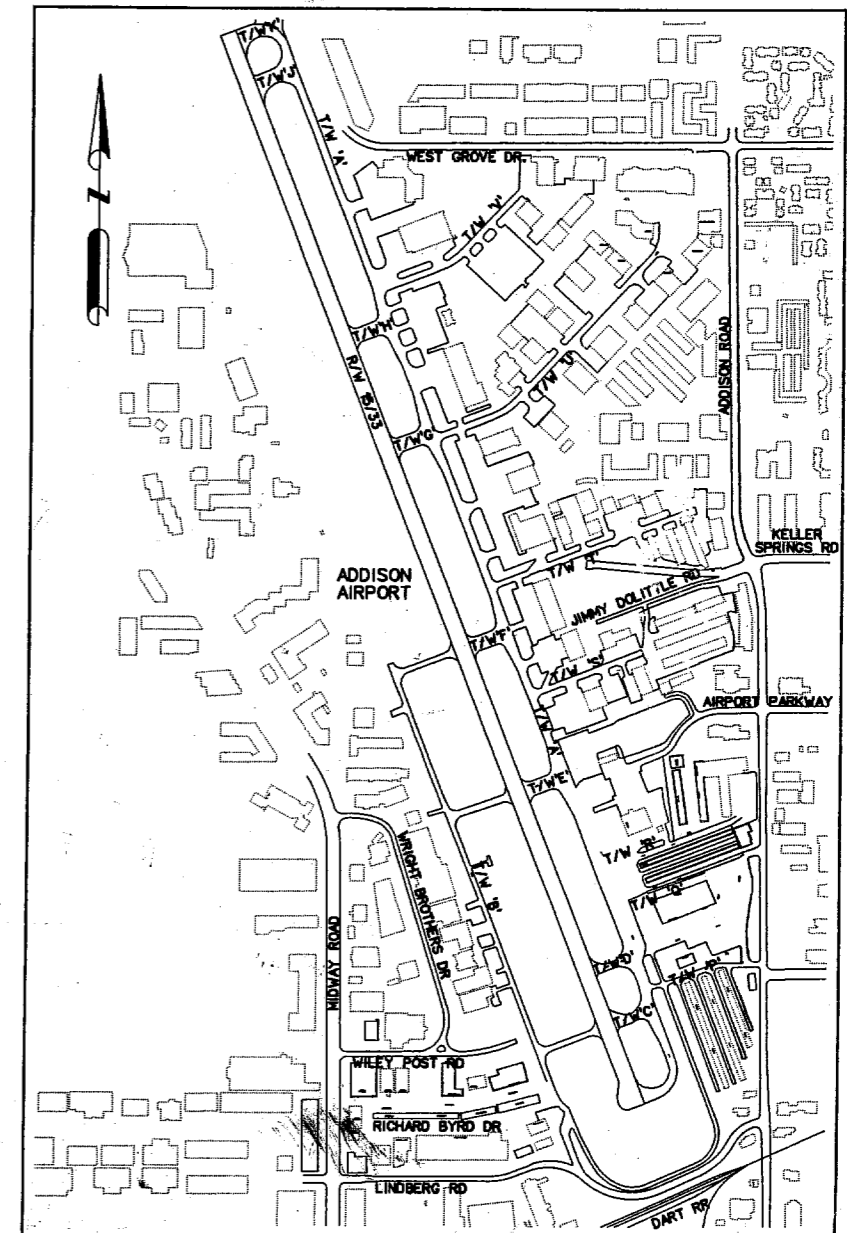

PROJECT MAP
NOT TO SCALE