






LEGEND

-  PHASE 1
-  ASPHALT CONSTRUCTED PRIOR TO PHASE 1
-  LOW LEVEL LIGHTED BARRICADES
-  AIRCRAFT TRAFFIC FLOW




LOW LEVEL LIGHTED BARRICADES 10' MAX SPACING BETWEEN BARRICADES (TYP)

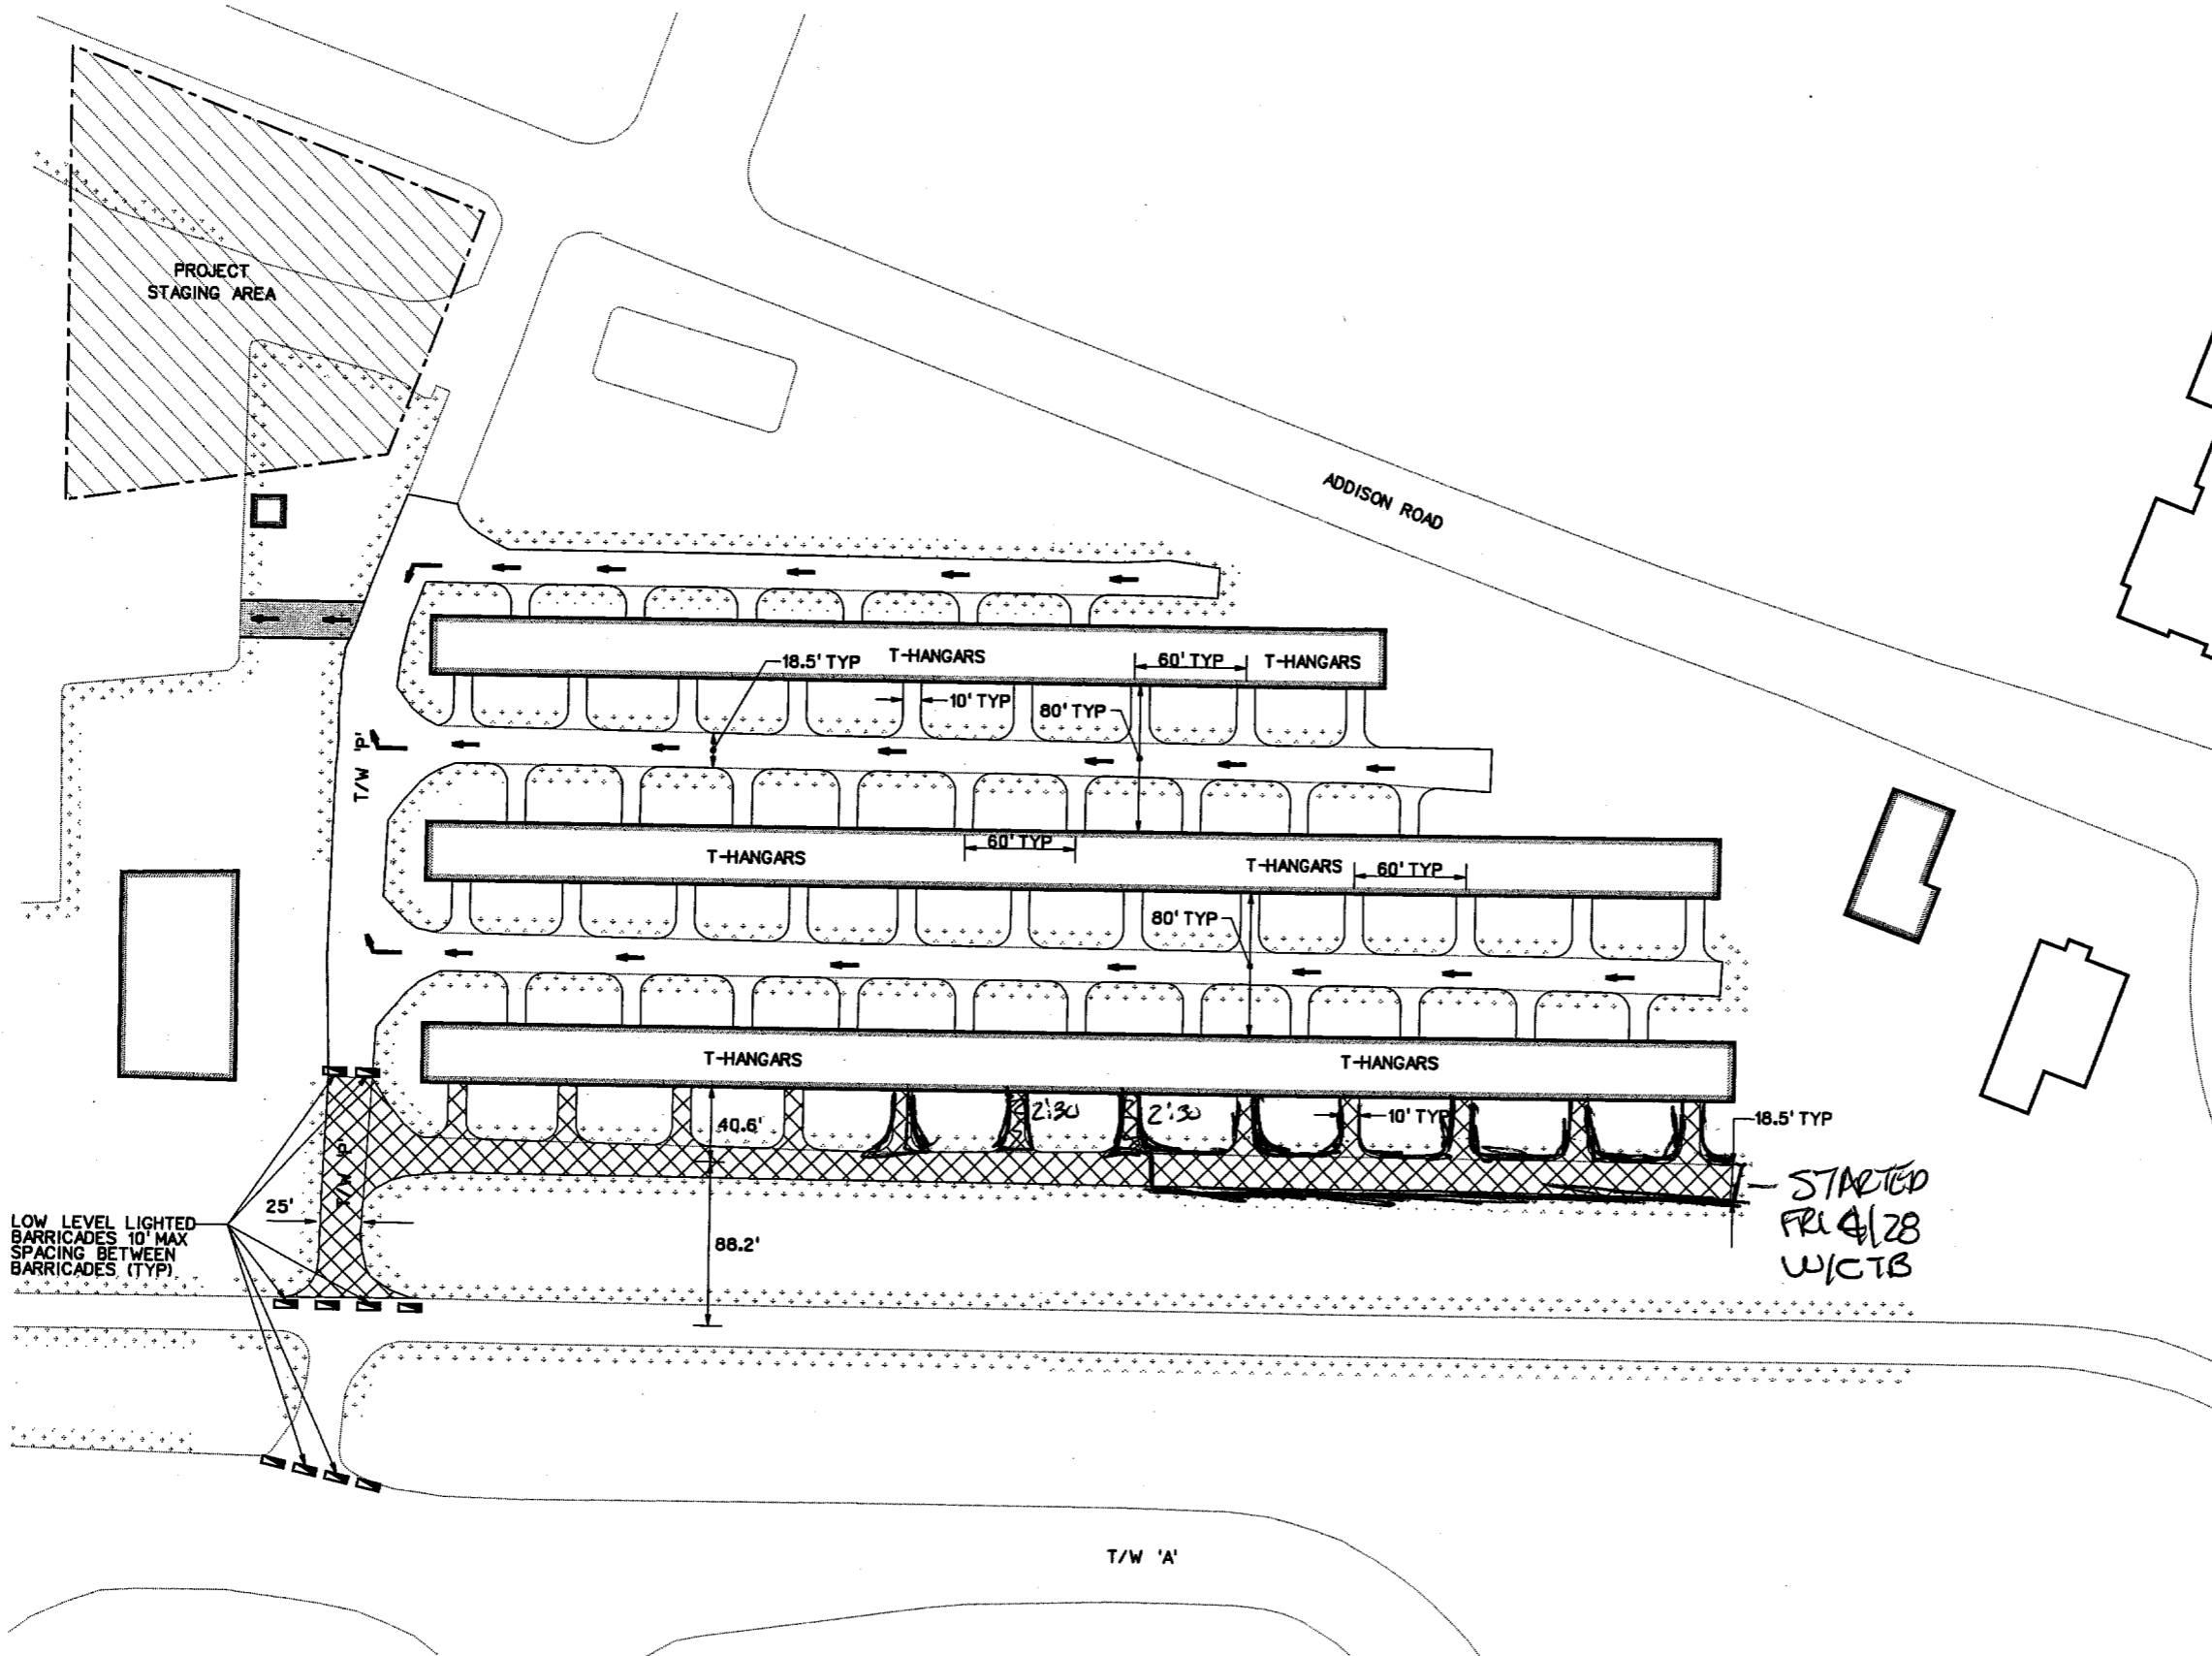STARTED FRI 4/28 W/CTB

- PHASING NOTES:**
- CONTRACTOR TO VERIFY STAGING AREA LIMITS WITH DAVE FOSTER, ADDISON AIRPORT OPERATIONS AND MAINTENANCE MANAGER 972-392-4852 PRIOR TO START OF CONSTRUCTION ACTIVITIES.
 - CONTRACTOR TO COORDINATE SCHEDULE WITH ADDISON AIRPORT. CONTRACTOR TO CONTACT DAVE FOSTER 14 DAYS PRIOR TO CONSTRUCTION TO ALLOW THE AIRPORT TO CONTACT AIRCRAFT OWNERS TO HAVE HANGARS EMPTY DURING CONSTRUCTION AND ALLOW FOR TEMPORARY RELOCATION OF AIRCRAFT.

27-DEC-2005 15:45 G:\41308\Cad\Sheets\rbncp07.dgn

NO.	DATE	REVISION	APPROV.	NO.	DATE	REVISION	APPROV.

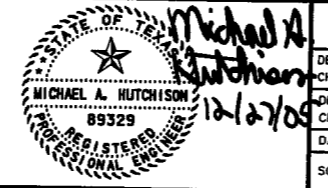

HNTB
HNTB Corporation
The HNTB Companies
Engineers Architects Planners

DESIGN CHECK DEC MAH
DRAWN CHECK CCH DEC
DATE DEC. 2005
SCALE

PROJECT NO. 41308



TOWN OF ADDISON		SHEET
ADDISON AIRPORT ASPHALT PAVEMENT IMPROVEMENTS		25 OF 36
PHASING PLAN TAXIWAY "P" / T HANGAR OVERLAY		TAXIWAY "p"
TOWN OF ADDISON, TEXAS		25