



REGISTRATION NO. F-5713

RECORD DRAWINGS
03/10/2015

REV.	DATE	DESCRIPTION

Addison Airport
ADDISON, TEXAS

RUNWAY 33 RSA IMPROVEMENTS

SAFETY & PHASING
PLAN - PHASES 1C & 1D



JOB NO.: 13081100
DATE: NOV. , 2013
DESIGNED BY: MRM
DRAWN BY: MRM

BAR IS ONE INCH ON ORIGINAL DRAWING
IF NOT ONE INCH ON THIS SHEET, ADJUST SCALES ACCORDINGLY.

DRAWING NUMBER
G-304

SHEET NUMBER
10


PHASE 1C

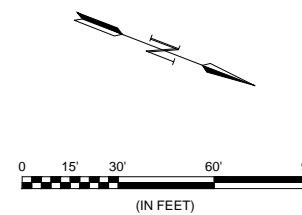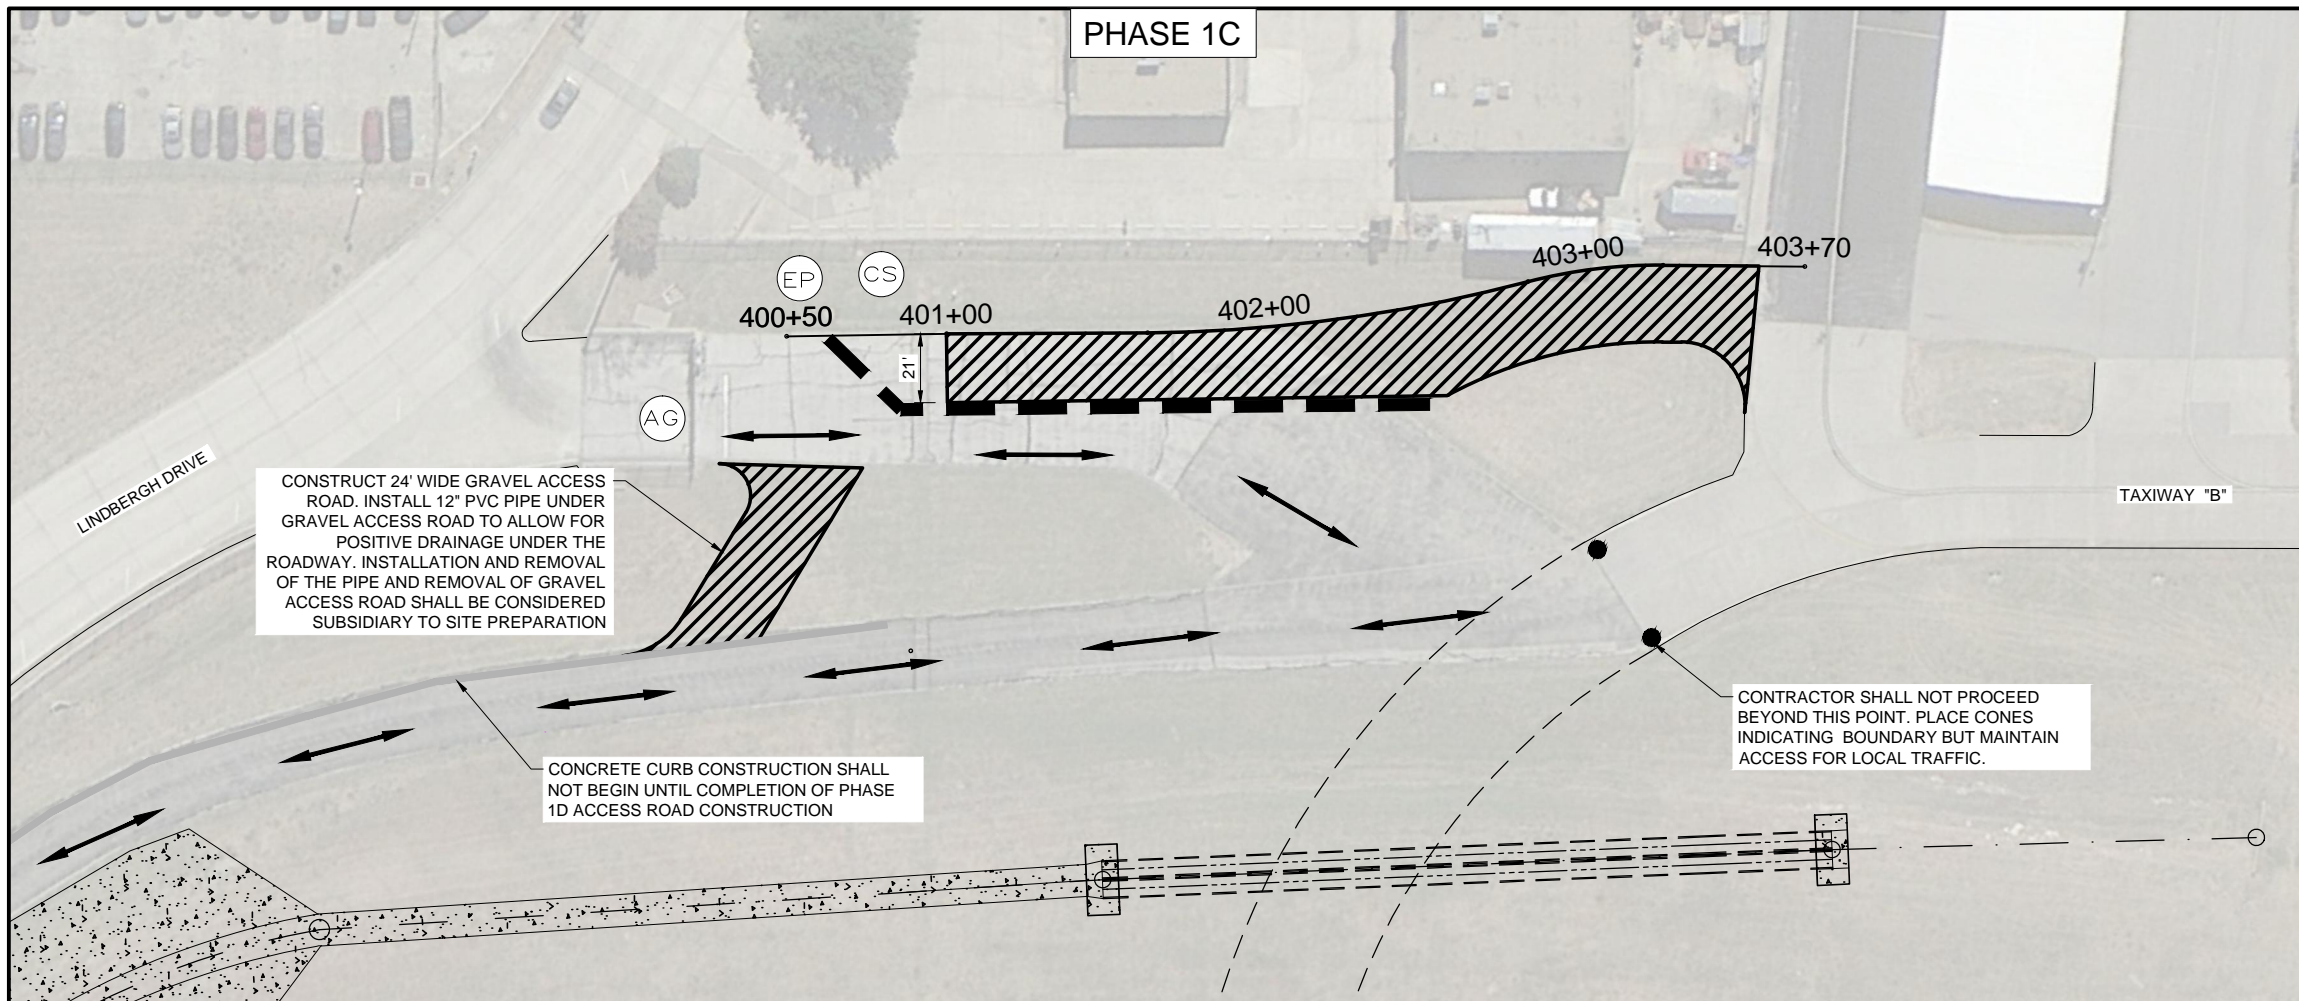

LEGEND

- PHASE 1C WORK AREA
- PHASE 1D WORK AREA
- PHASE 1D GRAVEL ROADWAY
- PHASE 1D PAVEMENT REMOVAL
- CONTRACTOR AND VEHICLE ACCESS
- BARRICADES (SEE SHEET G-203 FOR DETAILS)
- ACCESS GATE
- CONTRACTOR'S STAGING
- CONTRACTOR'S EMPLOYEE PARKING

PHASE 1D

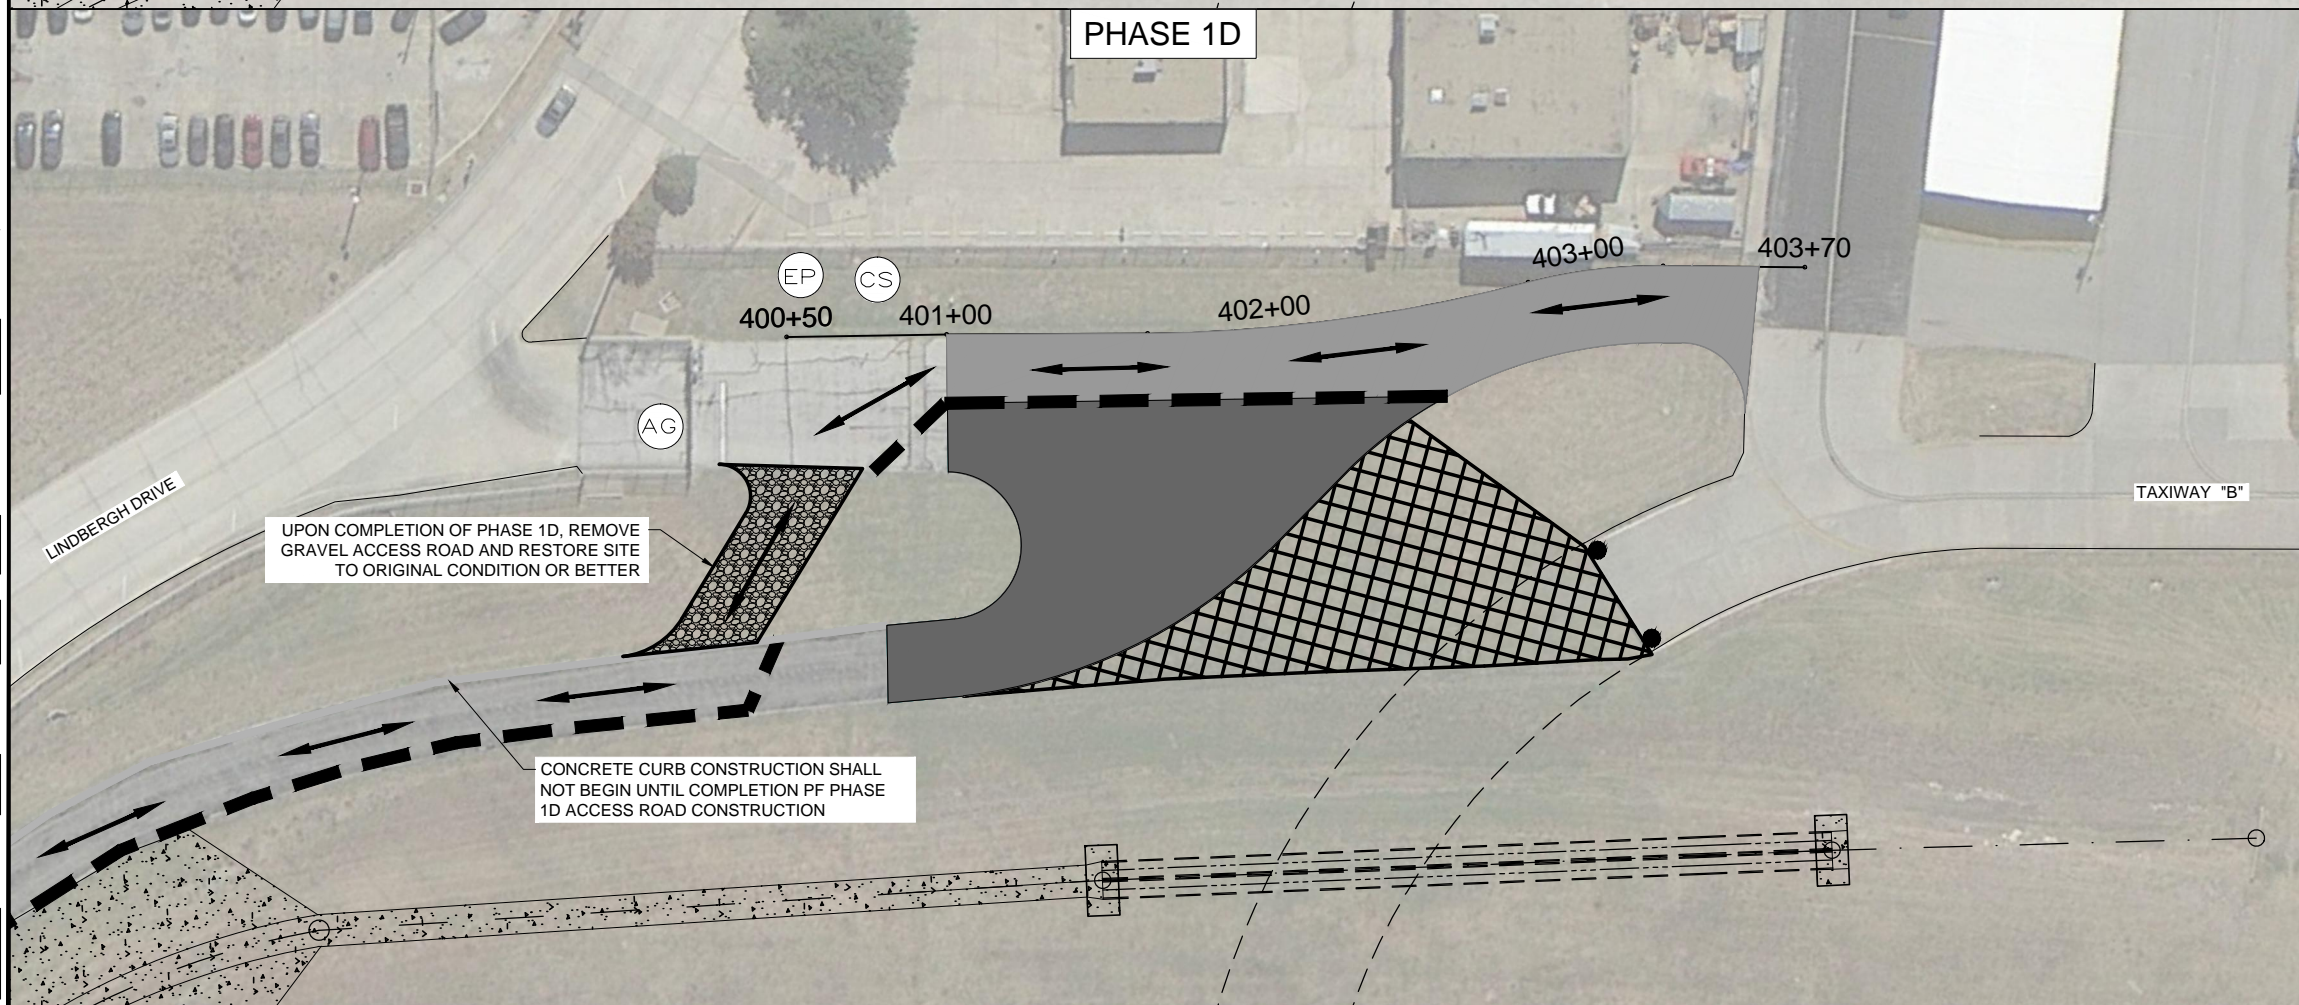

File: I:\2014\14081101 - ads emas construction\Drawings\RECORD\ADS_EMAS_G304_SP.dwg Last Save: 10/15/2014 1:40 PM Last saved by: Mirmcanelly
Last plotted by: Suarez, Javier Plot Style: AECOnono.ctb Plot Scale: 1:1 Plot Date: 3/10/2015 4:42 PM Plotter used: DWG To PDF.pc3