


EMAS BLOCK INFORMATION



REGISTRATION NO. F-5713

RECORD DRAWINGS
03/10/2015

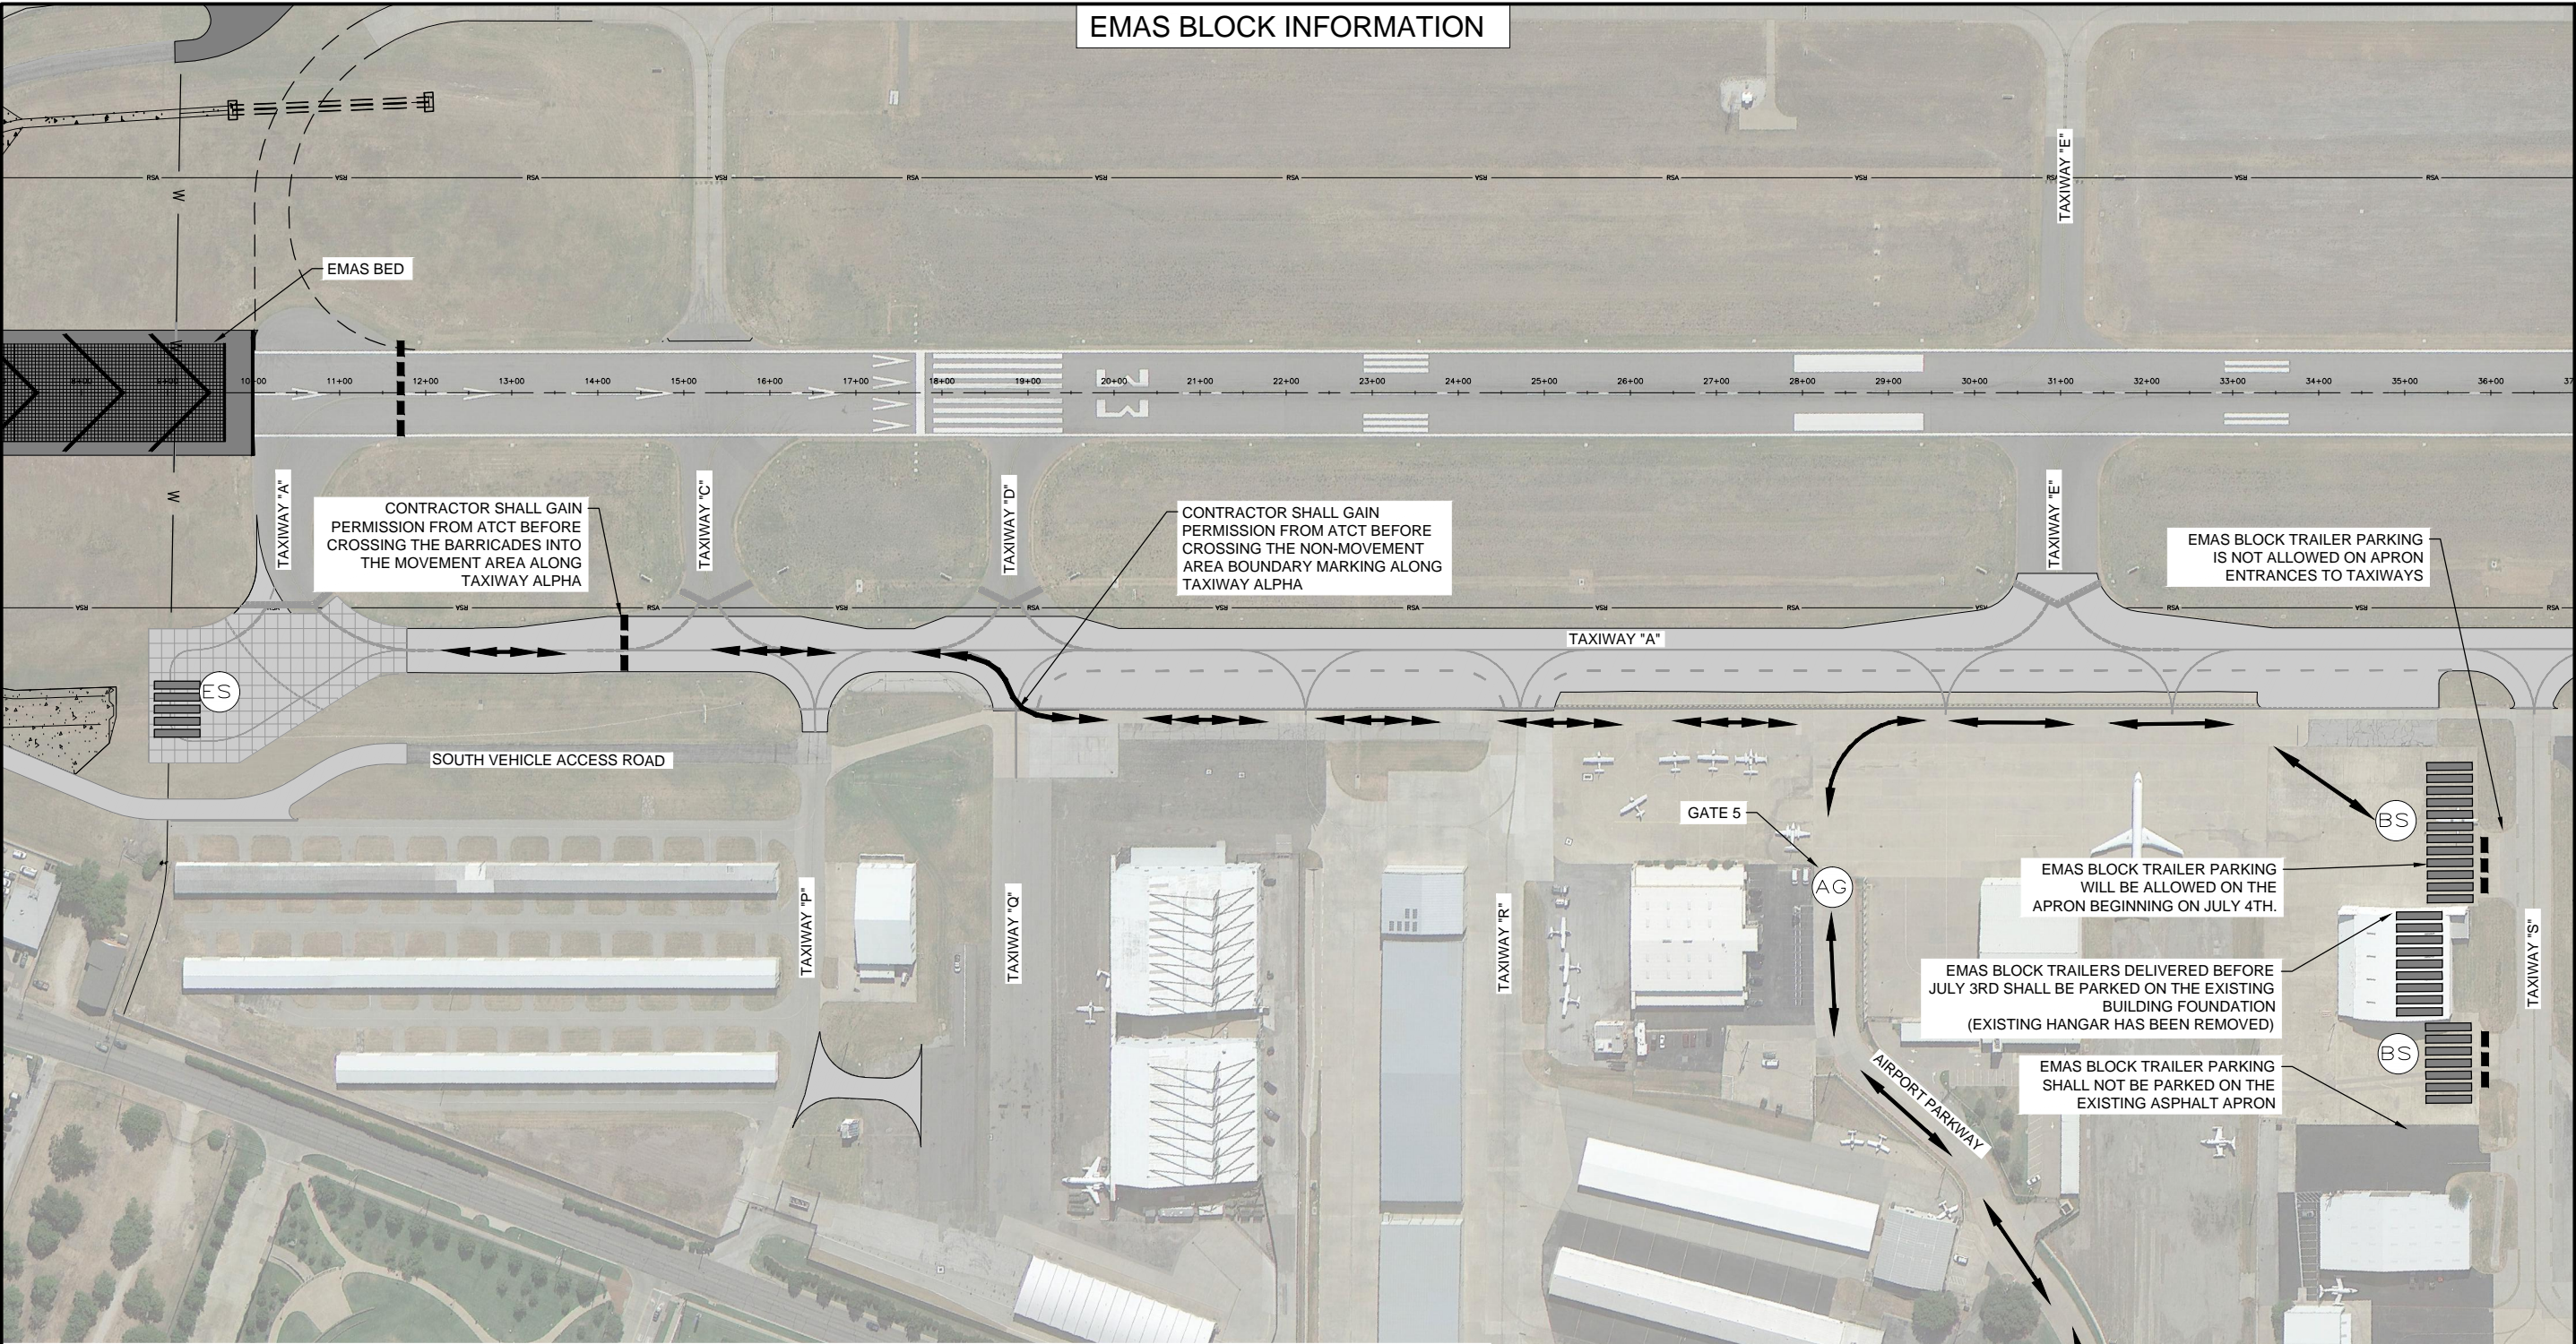


REV.	DATE	DESCRIPTION	BY

Addison Airport
ADDISON, TEXAS
RUNWAY 33 RSA IMPROVEMENTS

GENERAL NOTES:

- EMAS BLOCK DELIVERY SHALL BE COORDINATED WITH THE ENGINEER AS SOON AS THE ASPHALT PAVING FOR THE EMAS FOUNDATION BED HAS COMMENCED.
- EMAS BLOCK DELIVERIES SHALL ENTER THROUGH GATE 5 ON AIRPORT PARKWAY.
- EMAS BLOCK TRAILERS SHALL BE STORED WITHIN THE DESIGNATED EMAS BLOCK TRAILER STORAGE AREA.
- CONTRACTOR SHALL HAVE AN APPROVED TRAILER LAYOUT PLAN BY THE ENGINEER BEFORE THE FIRST TRUCKS ARRIVE.
- THE EMAS BLOCK STAGING AREA SHALL BE USED TO UNLOAD EMAS BLOCKS FROM THE TRAILERS ONLY. EMPTY TRAILERS AND TRAILERS NOT DESIGNATED FOR IMMEDIATE INSTALLATION SHALL REMAIN IN THE EMAS BLOCK TRAILER STORAGE AREA.
- PER SPECIFICATION P-555, CONTRACTOR IS RESPONSIBLE FOR TRANSPORTING TRAILERS FROM THE EMAS BLOCK STORAGE AREA TO THE EMAS BLOCK STAGING AREA AND BACK TO THE EMAS BLOCK STORAGE AREA.
- ALL EMAS BLOCK DELIVERIES SHALL BE ESCORTED BY THE CONTRACTOR INSIDE THE AIRPORT PERIMETER FENCE.
- THE CONTRACTOR SHALL HAVE CONTINUOUS COMMUNICATION WITH THE AIR TRAFFIC CONTROL TOWER (ATCT) FROM THE EMAS BLOCK TRAILER STORAGE AREA TO THE EMAS BLOCK STAGING AREA. THE CONTRACTOR SHALL GAIN PERMISSION FROM ATCT BEFORE CROSSING INTO THE MOVEMENT AREAS ALONG TAXIWAY ALPHA.
- ALL WORK ASSOCIATED WITH EMAS DELIVERY AND INSTALLATION SHALL BE CONSIDERED SUBSIDIARY TO THE EMAS BLOCK INSTALLATION SERVICES PAY ITEM.

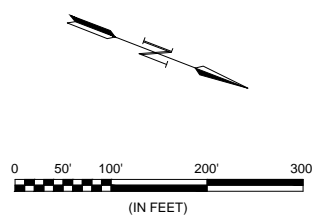

LEGEND

- EMAS BLOCK TRAILER PARKING
- EMAS BLOCK DELIVERY ROUTE
- EMAS BLOCK HAUL ROUTE TO STAGING AREA
- BARRICADES
- ACCESS GATE
- EMAS BLOCK TRAILER STORAGE AREA
- EMAS BLOCK STAGING AREA (INSTALLATION ONLY)

SAFETY & PHASING PLAN - EMAS BLOCK DELIVERY AND HAUL ROUTES

JOB NO.: 13081100
DATE: NOV. , 2013
DESIGNED BY: MRM
DRAWN BY: MRM
DRAWING NUMBER **G-307**
SHEET NUMBER **12A**

File: I:\2014\14081101 - ads emas construction\Drawings\RECORD\ADDENADS_EMAS_G307_SP.dwg Last Save: 10/15/2014 1:41 PM Last saved by: Bebeville
Last Plotted by: Suarez, Javier Plot Style: AECmonochrome.ctb Plot Date: 3/10/2015 4:44 PM Plotter used: DWG To PDF.pc3