



File: I:\2014\14081101 - ads emas construction\Drawings\RECORD\ADS.EMAS_C101_GP.dwg Last Save: 10/15/2014 1:41 PM Last saved by: Bcbeville
 Last plotted by: Suarez, Javier Plot Style: AECmonochrome.ctb Plot Date: 3/10/2015 4:46 PM Plotter used: DWG To PDF.pc3

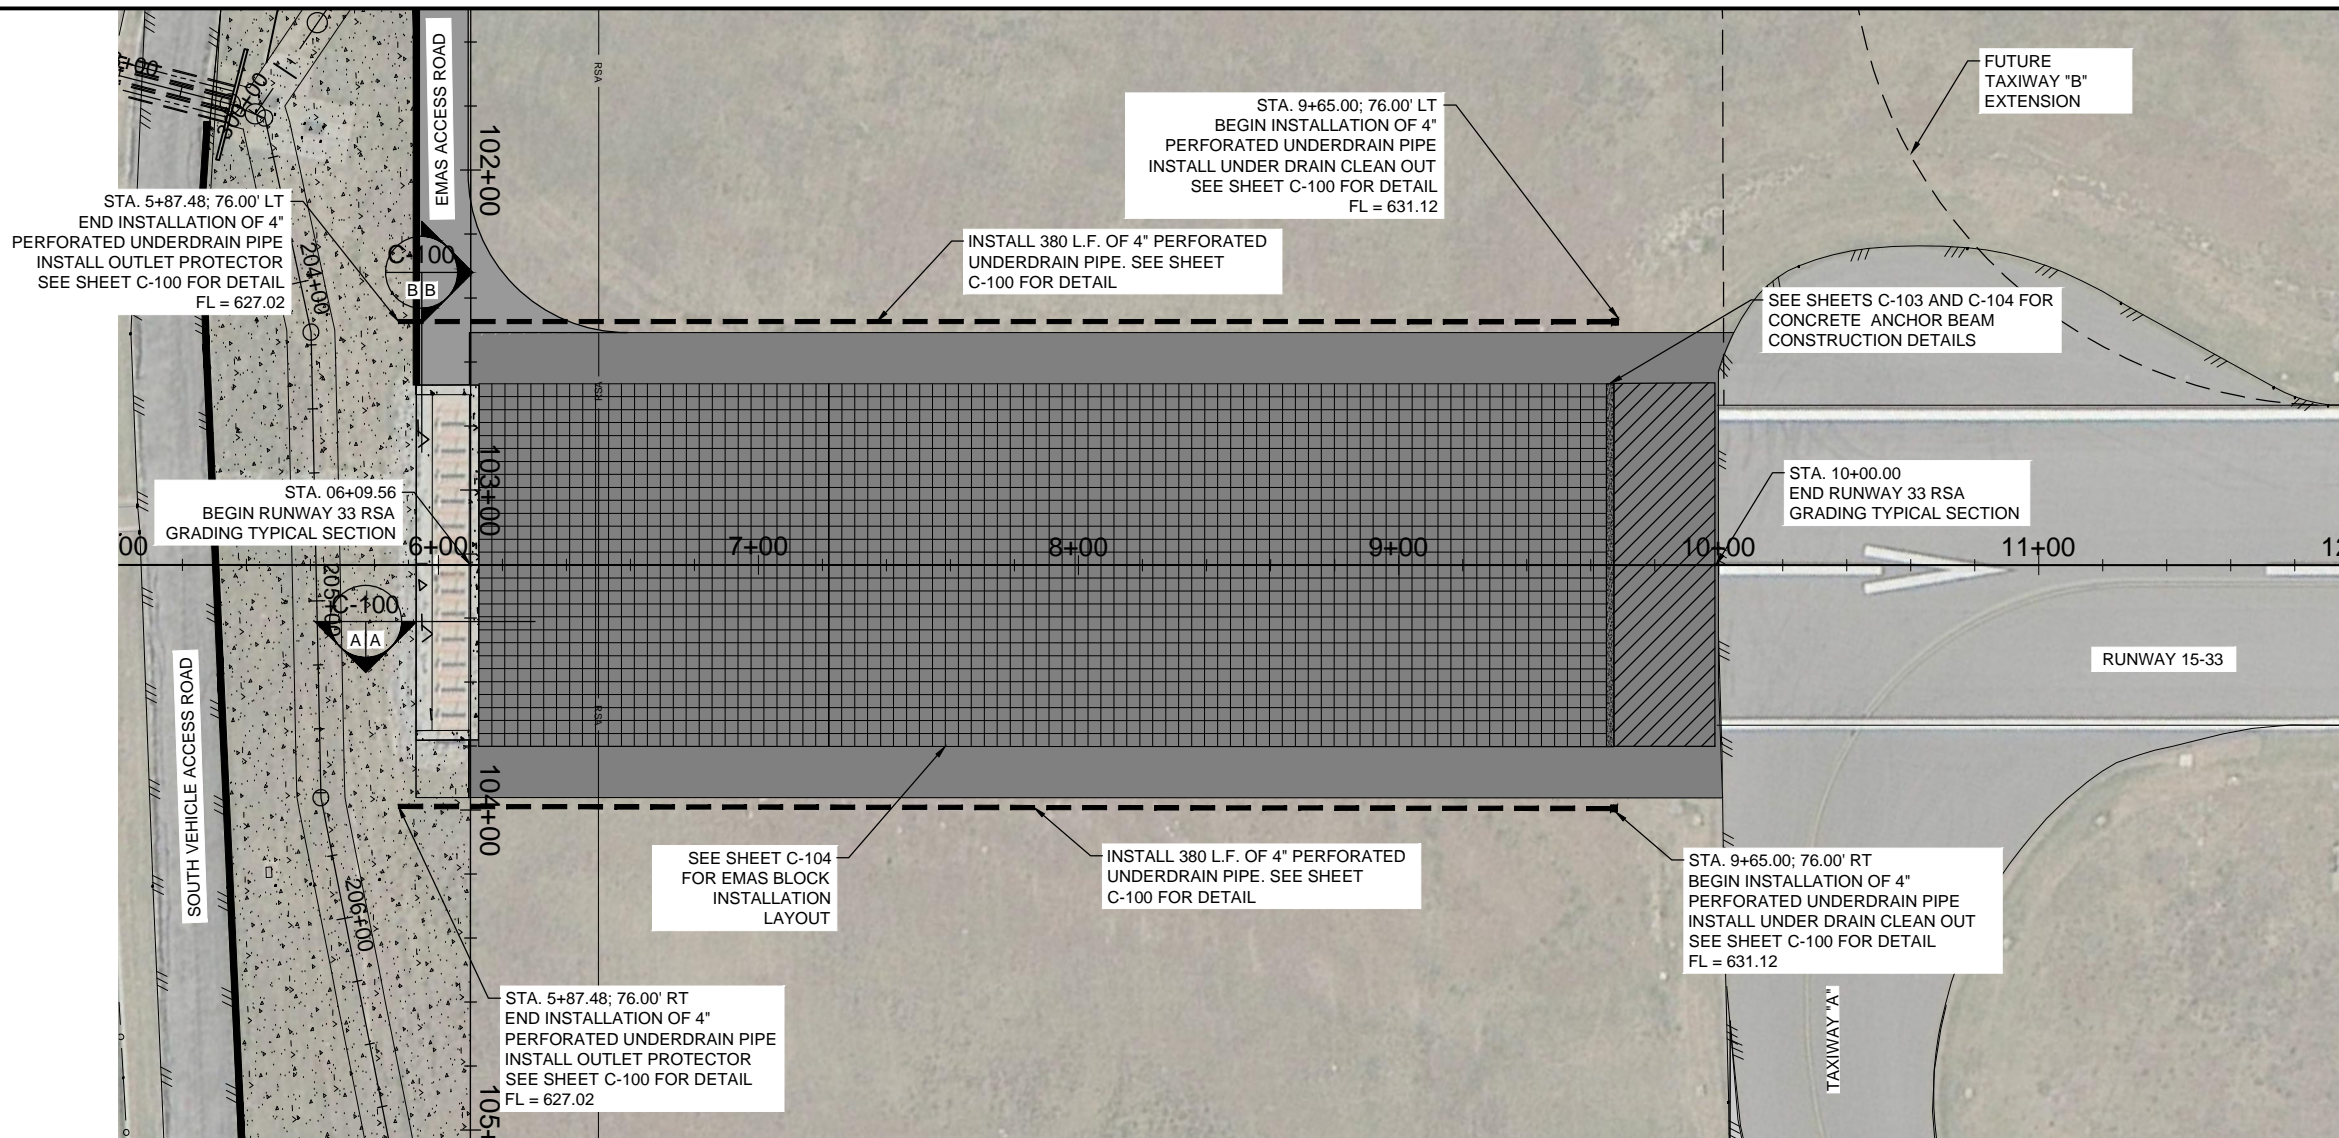

LEGEND

- SLOPE PROTECTION
- SAW-CUT GROOVE AREA
- UNDERDRAINS
- UNDERDRAIN CLEANOUT

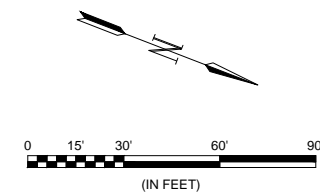

REGISTRATION NO.
F-5713

RECORD DRAWINGS
03/10/2015

REV.	DATE	DESCRIPTION	BY



ADDISON AIRPORT
ADDISON, TEXAS

RUNWAY 33 RSA IMPROVEMENTS

RUNWAY 33 RSA LAYOUT PLAN

JOB NO.: 13081100
DATE: NOV. , 2013
DESIGNED BY: BCB
DRAWN BY: BCB

BAR IS ONE INCH ON ORIGINAL DRAWING
IF NOT ONE INCH ON THIS SHEET, ADJUST SCALES ACCORDINGLY.

DRAWING NUMBER
C-101

SHEET NUMBER
18

