



File: \\EMAS\_2\Airport Engineering & Sales\CH2M Engineering\U.S. Airports\Addison, TX (Waco)\Drawings\Final Drawings\ADS RW 15 DE EMAS Plan view.dwg Last Save: 11/05/2013 8:29 AM Last saved by: Tuzinski  
 Last plotted by: Tim Buzinski Plot Style: AECMonochrome.ctb Plot Scale: 1:0.4295 Plot Date: 11/05/2013 4:53 PM Plotter used: DWG To PDF.pc3

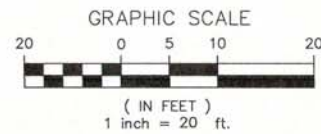

- LEGEND**
- 17" BLOCKS
  - 14" BLOCKS
  - 8" BLOCKS
  - EQUIPMENT RAMP
  - SEE PROFILE FOR BLOCK SIZES
  - ANCHOR BEAM/DEBRIS DEFLECTOR

NOTE: ALL BLOCKS ARE 4.00' X 4.00' X THICKNESS SHOWN  
 \*ALL HEIGHTS ARE NOMINAL\*  
 ACTUAL BLOCKS ARE 7/8" TALLER THAN HEIGHT SHOWN  
 A 17 BLOCK HAS AN ACTUAL HEIGHT OF 17.87"

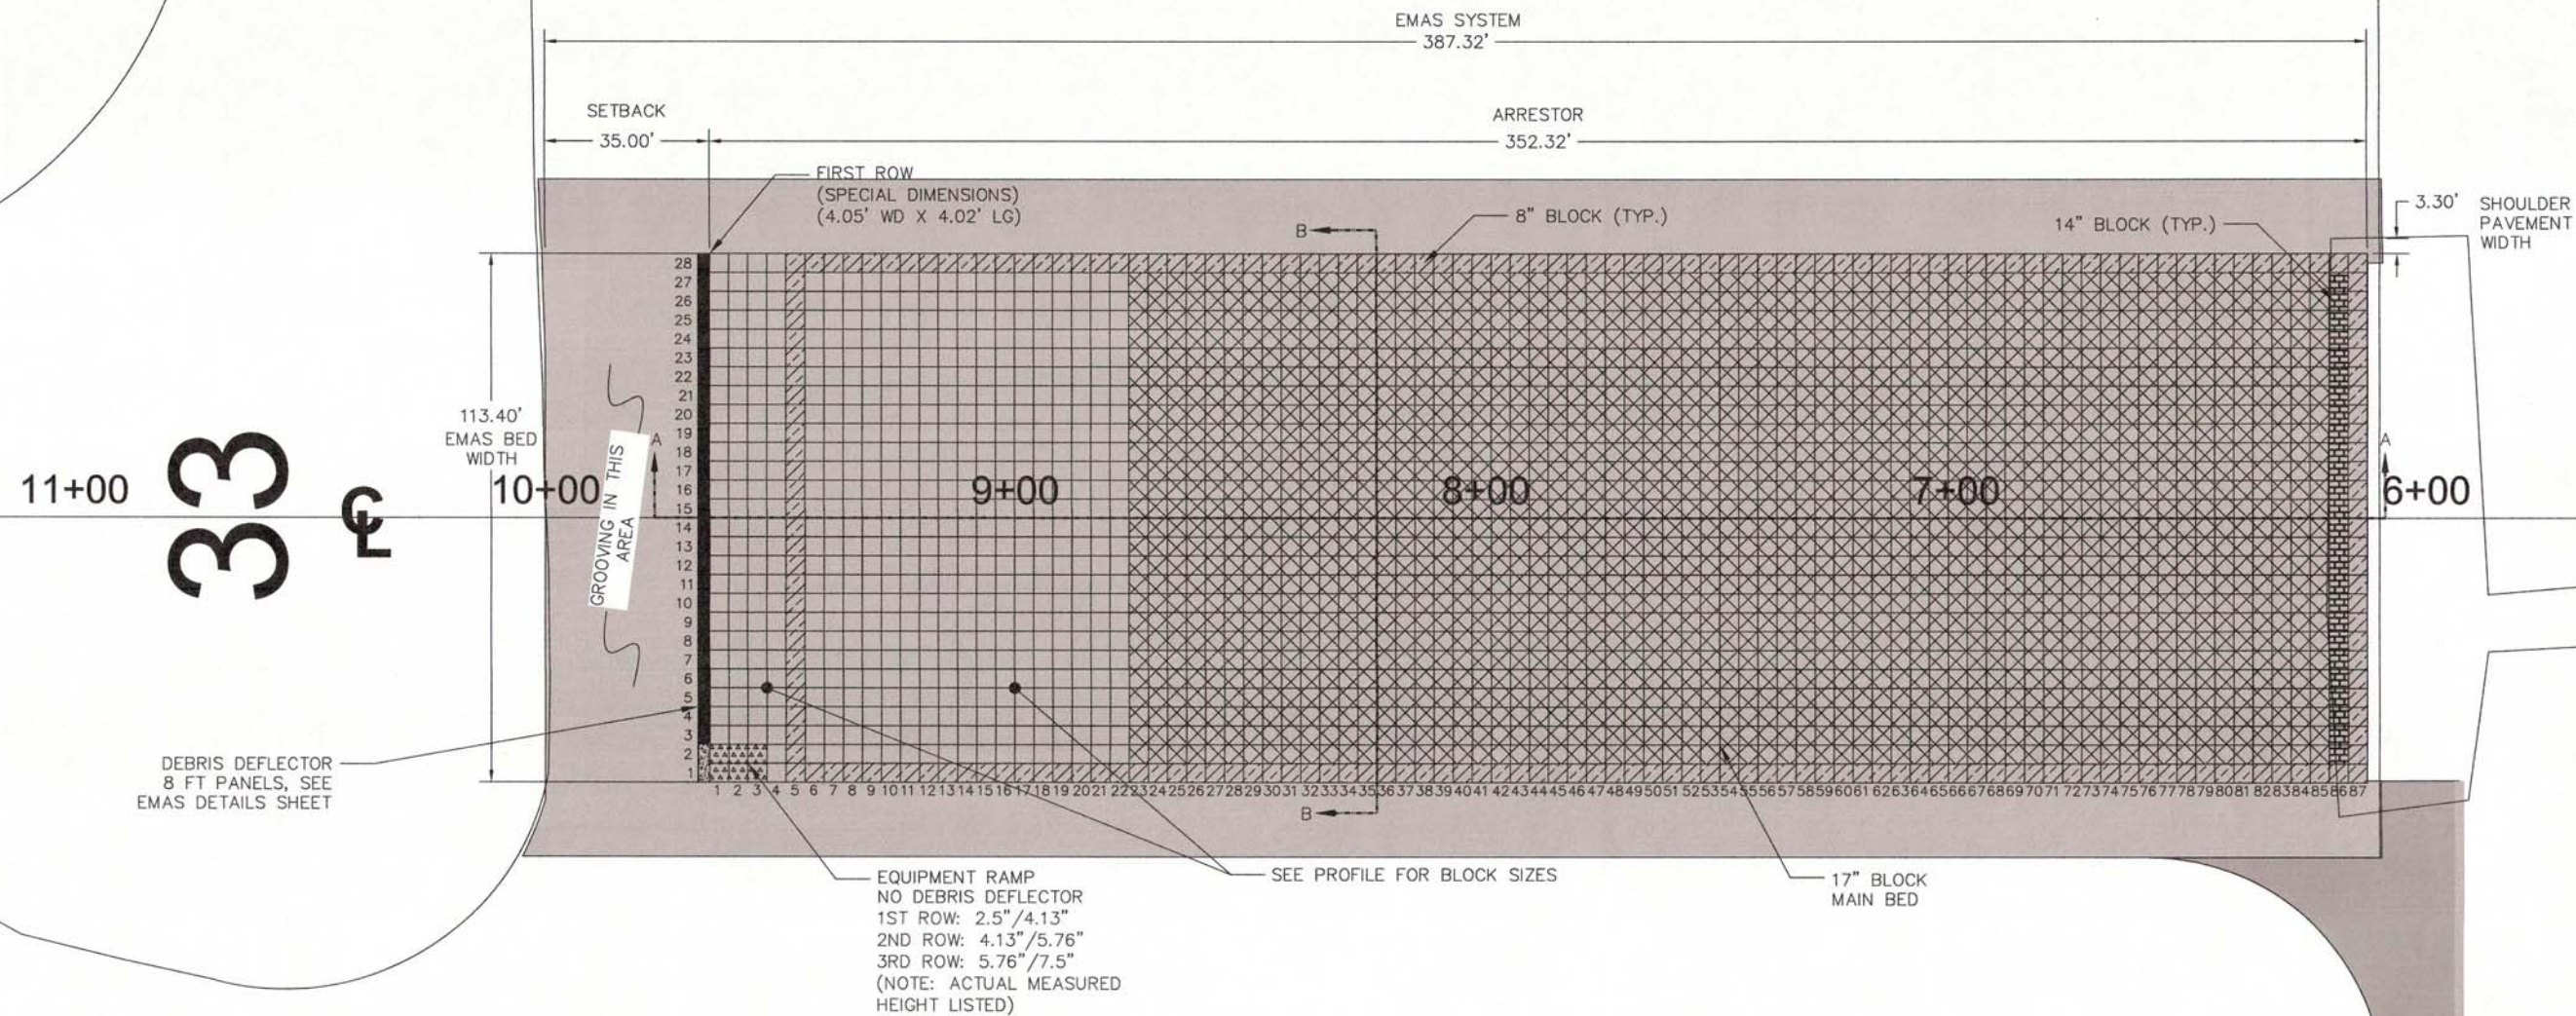

REGISTRATION NO. F-5713



Digitally Signed 11/07/2013

REV.	DATE	DESCRIPTION

**Addison Airport**  
 ADDISON, TEXAS  
 RUNWAY 33 RSA IMPROVEMENTS

EMAS PLAN VIEW

JOB NO.: 13081100  
 DATE: SEPT. 2013  
 DESIGNED BY: HKD  
 DRAWN BY: TMB

BAR IS ONE INCH ON ORIGINAL DRAWING  
 IF NOT ONE INCH ON THIS SHEET, ADJUST SCALES ACCORDINGLY.

DRAWING NUMBER  
**C-102**

SHEET NUMBER  
**19**