



File: \\EMAS\_2\Airport Engineering & Safety\Civil Engineering\U.S. Airports\Addison, TX (Waco)\Drawings\Final Drawings\ADS RW 15 DE EMAS Profile n Details.dwg Last Save: 11/5/2013 8:30 AM Last saved by: Miracally  
 Last plotted by: Tim Buzinski Plot Date: 11/5/2013 5:00 PM Plotter used: DWG To PDF.pc3

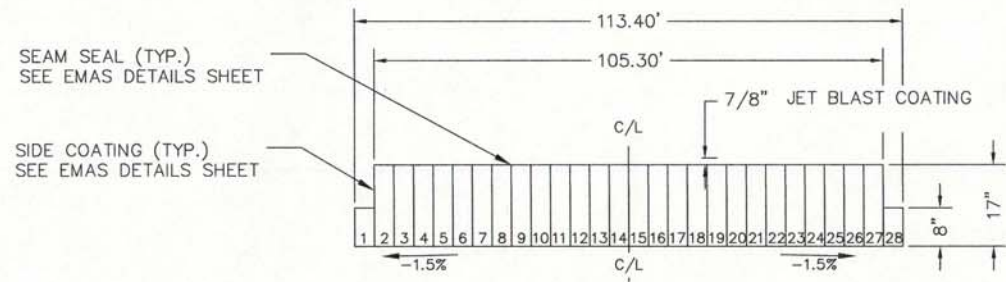


SECTION B-B  
FROM EMAS BLOCK LAYOUT

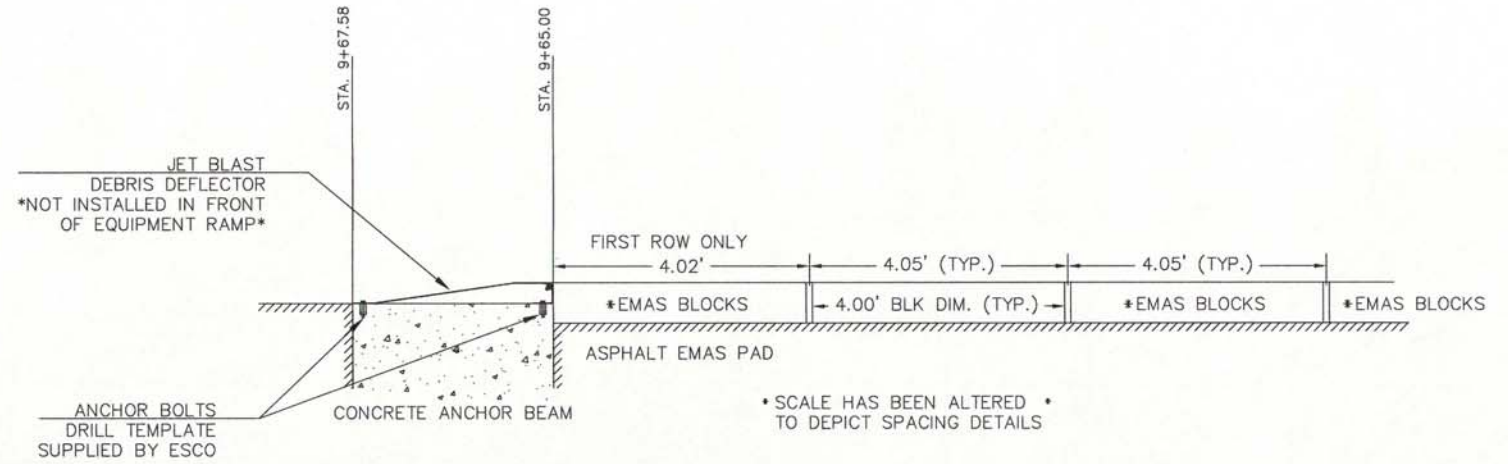

ANCHOR BEAM-DEBRIS DEFLECTOR LAYOUT  
SCALE: N.T.S.

NOTE:  
BLAST DEFLECTOR & MOUNTING BOLTS TO BE SUPPLIED BY ESCO  
ESCO WILL SUPPLY BLOCK SPACER & DRILL TEMPLATE FOR INSTALLATION

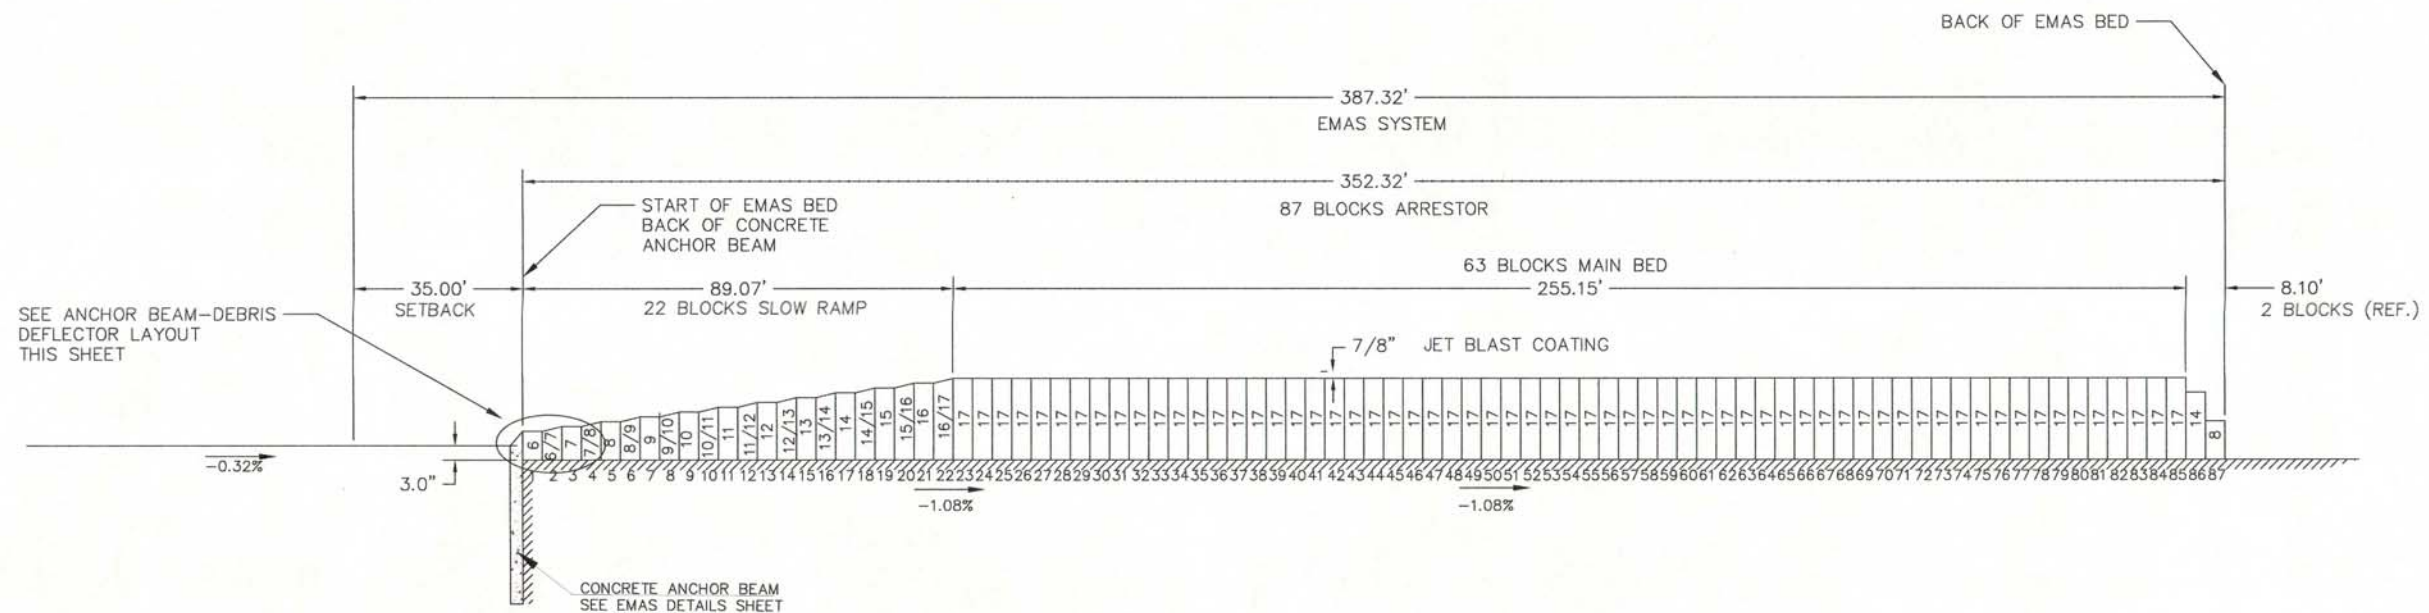

SECTION A-A  
FROM EMAS BLOCK LAYOUT

NOTE: ALL BLOCKS ARE 4.00' X 4.00' X THICKNESS SHOWN  
\*ALL HEIGHTS ARE NOMINAL\*  
ACTUAL BLOCKS ARE 7/8" TALLER THAN HEIGHT SHOWN



REGISTRATION NO.  
F-5713



Digitally Signed 11/07/2013

REV.	DATE	DESCRIPTION	BY

ADDISON AIRPORT  
 ADDISON, TEXAS  
 RUNWAY 33 RSA IMPROVEMENTS

EMAS PROFILE VIEW

JOB NO.: 13081100  
 DATE: SEPT. 2013  
 DESIGNED BY: HKD  
 DRAWN BY: TMB

BAR IS ONE INCH ON ORIGINAL DRAWING  
 IF NOT ONE INCH ON THIS SHEET, ADJUST SCALES ACCORDINGLY.

DRAWING NUMBER  
**C-103**

SHEET NUMBER  
**20**