



C-105  
A  
**SECTION A-A**  
SCALE: NONE

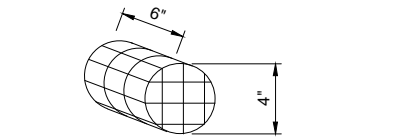


C-105  
2  
**RODENT SCREEN**  
SCALE: NONE

NOTE:  
INSTALL FRONT EDGE OF SCREEN  
6" UP INTO PIPE.

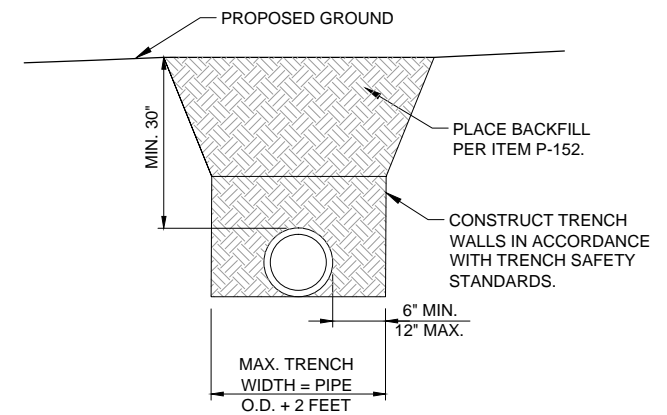


C-105  
3  
**OUTLET PIPE UNDER TURF**  
SCALE: NONE

C-105  
1  
**UNDERDRAIN SYSTEM**  
SCALE: NONE

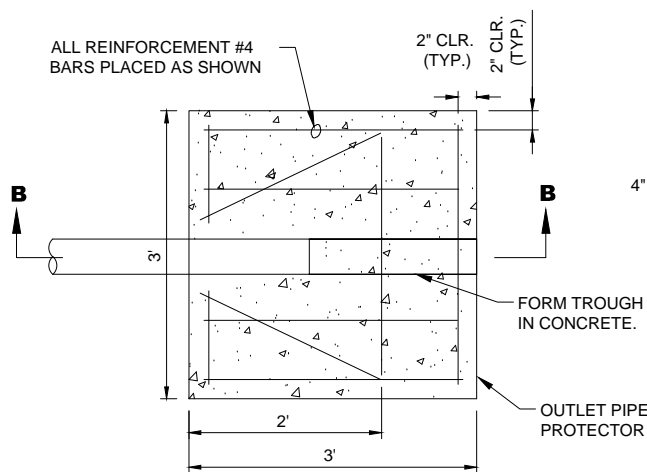


C-105  
**PLAN**  
SCALE: NONE

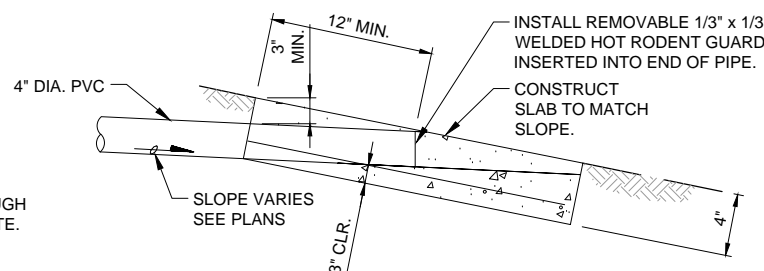

C-105  
B  
**SECTION B-B**  
SCALE: NONE

C-105  
4  
**OUTLET PROTECTOR**  
SCALE: NONE

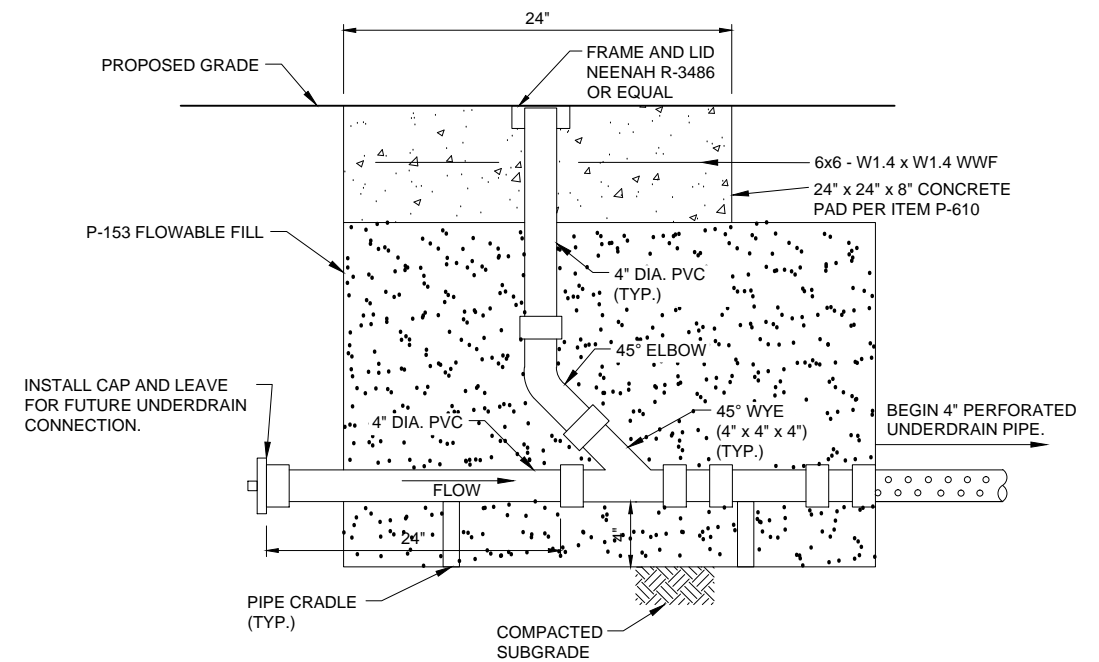

C-105  
5  
**UNDERDRAIN END CLEANOUT**  
SCALE: NONE



REGISTRATION NO.  
F-5713



DIGITALLY SIGNED  
11/07/2013

REV.	DATE	DESCRIPTION	BY



ADDISON AIRPORT  
ADDISON, TEXAS

RUNWAY 33 RSA IMPROVEMENTS

EMAS UNDERDRAIN  
DETAILS

JOB NO.: 13081100  
DATE: NOV., 2013  
DESIGNED BY: BCB  
DRAWN BY: BCB

BAR IS ONE INCH ON  
ORIGINAL DRAWING  
IF NOT ONE INCH ON  
THIS SHEET, ADJUST  
SCALES ACCORDINGLY.

DRAWING NUMBER  
**C-105**

SHEET  
NUMBER **22**