



REGISTRATION NO. F-5713

RECORD DRAWINGS  
03/10/2015

REV.	DATE	DESCRIPTION	BY




**Addison Airport**  
ADDISON, TEXAS  
RUNWAY 33 RSA IMPROVEMENTS

DRAINAGE PROFILES

JOB NO.: 13081100  
DATE: NOV. , 2013  
DESIGNED BY: BCB  
DRAWN BY: BCB

BAR IS ONE INCH ON ORIGINAL DRAWING  
IF NOT ONE INCH ON THIS SHEET, ADJUST SCALES ACCORDINGLY.

DRAWING NUMBER  
**C-204**  
SHEET NUMBER  
**29**

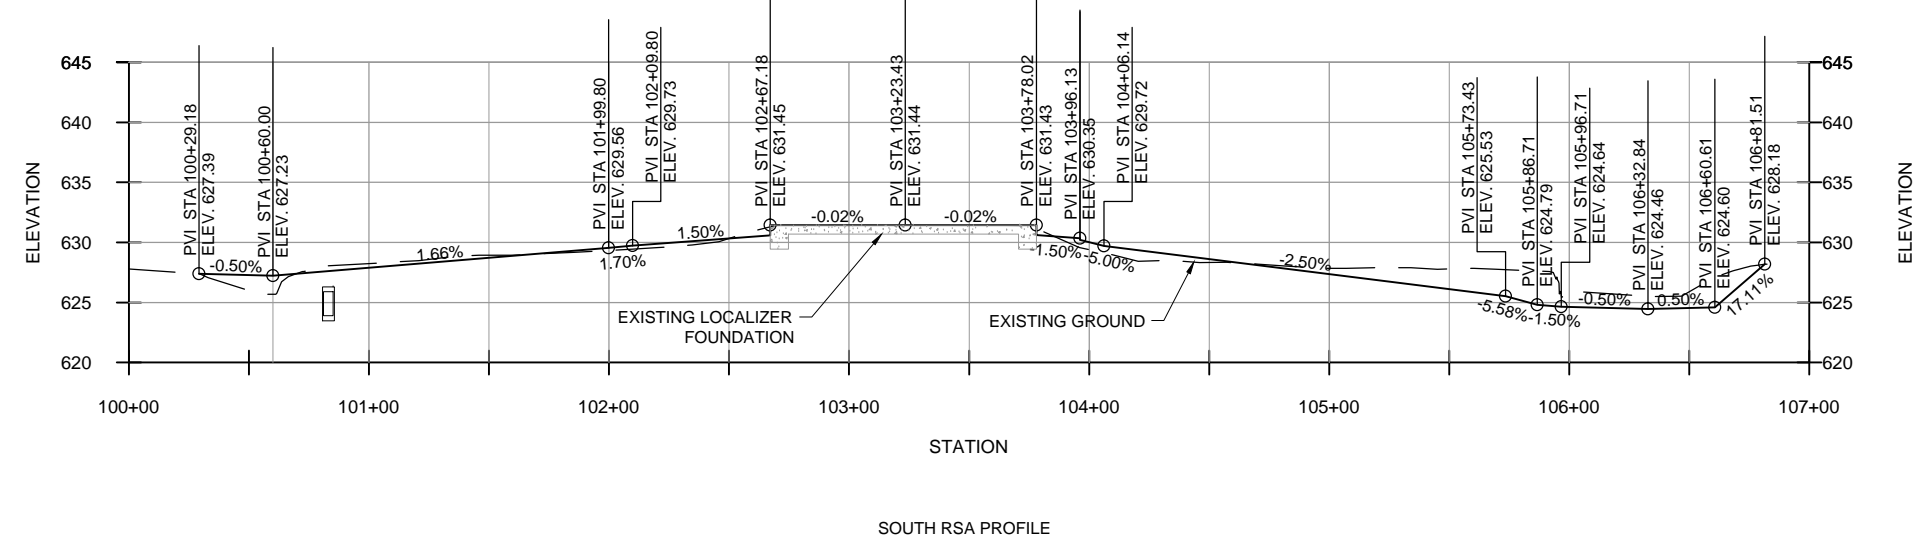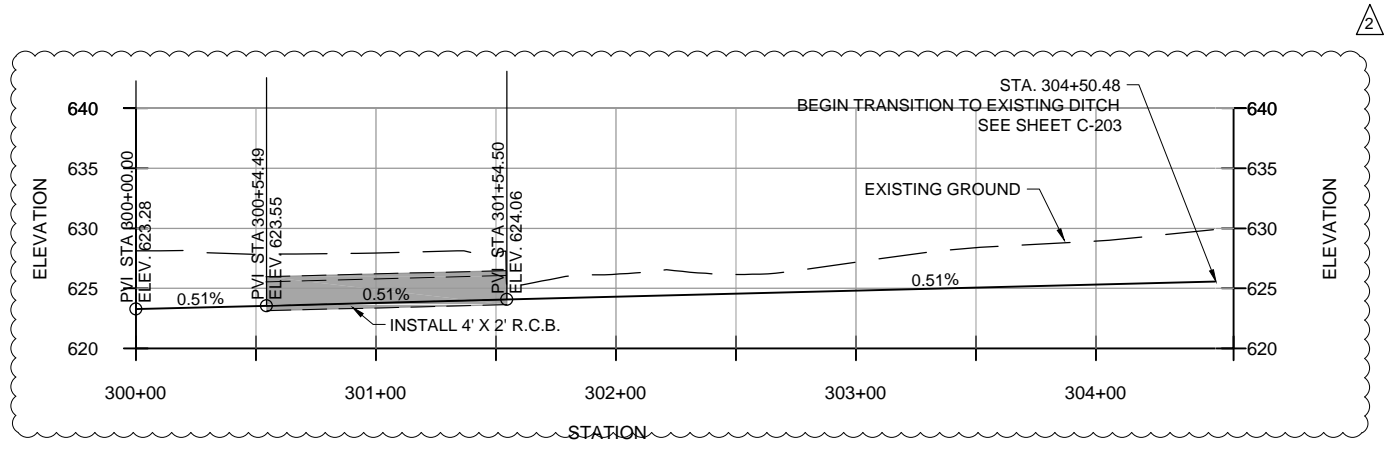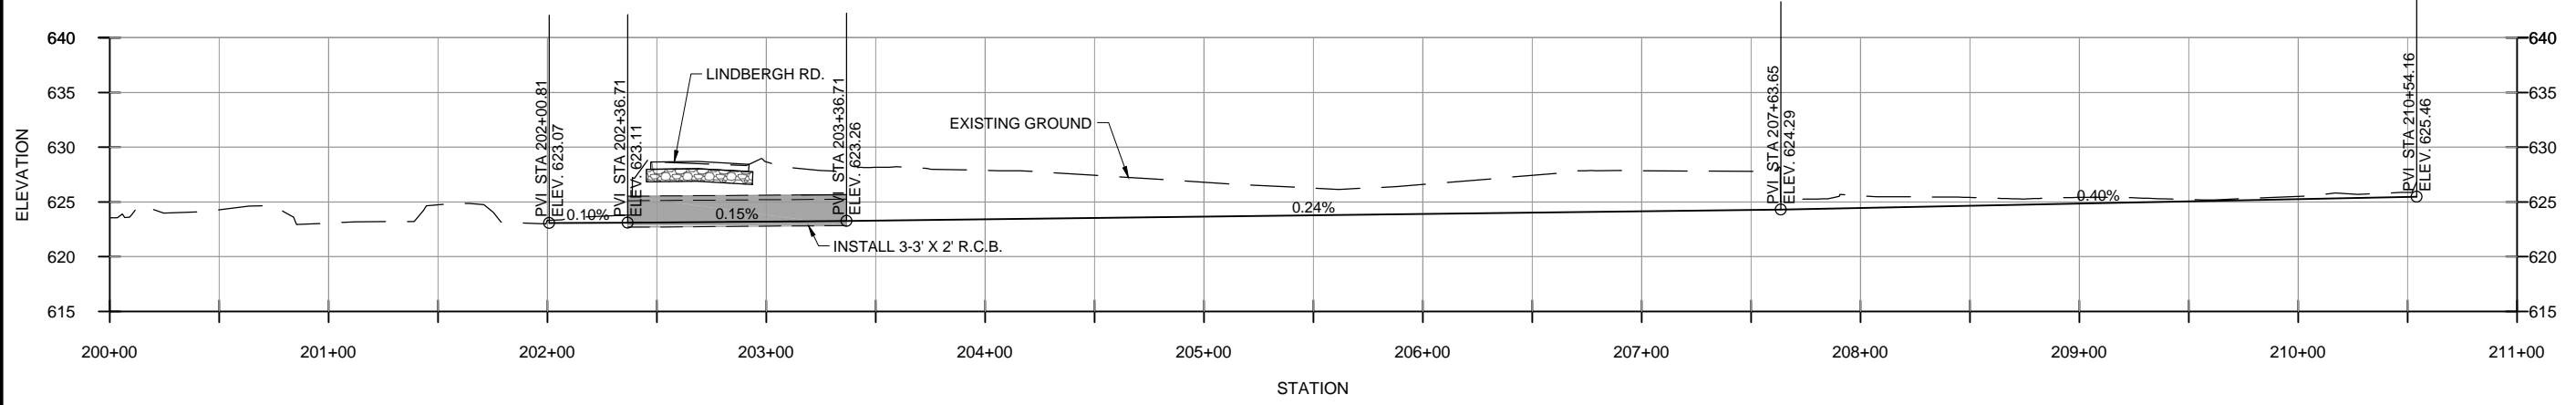

File: I:\2014\14081101 - ads emas construction\Drawings\RECORD\ADS\_EMAS\_C204\_DP.dwg Last Save: 10/15/2014 1:42 PM Last saved by: Mimicnally  
 Last Plotted by: Suarez, Javier Plot Style: AECmonochrome.ctb Plot Scale: 1:1 Plot Date: 3/10/2015 4:50 PM Plotter used: DWG To PDF.pc3