

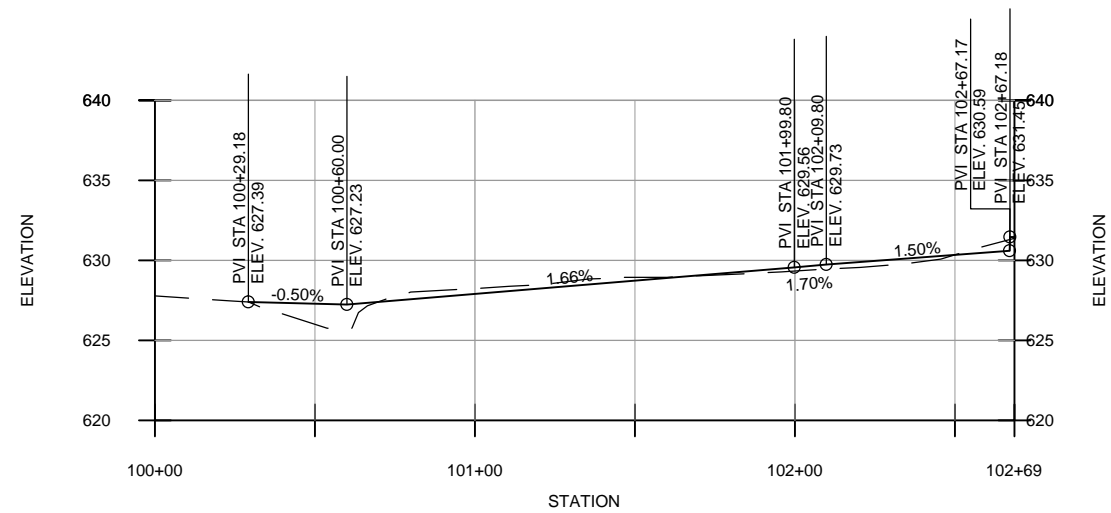


File: I:\2014\14081101 - ads emas construction\Drawings\RECORD\ADS_EMAS_C209_PP.dwg Last Save: 10/15/2014 1:42 PM Last saved by: Bcbville
 Last plotted by: Suarez, Javier Plot Style: AECmono.ctb Plot Scale: 1:1 Plot Date: 3/10/2015 4:52 PM Plotter used: DWG To PDF.pc3

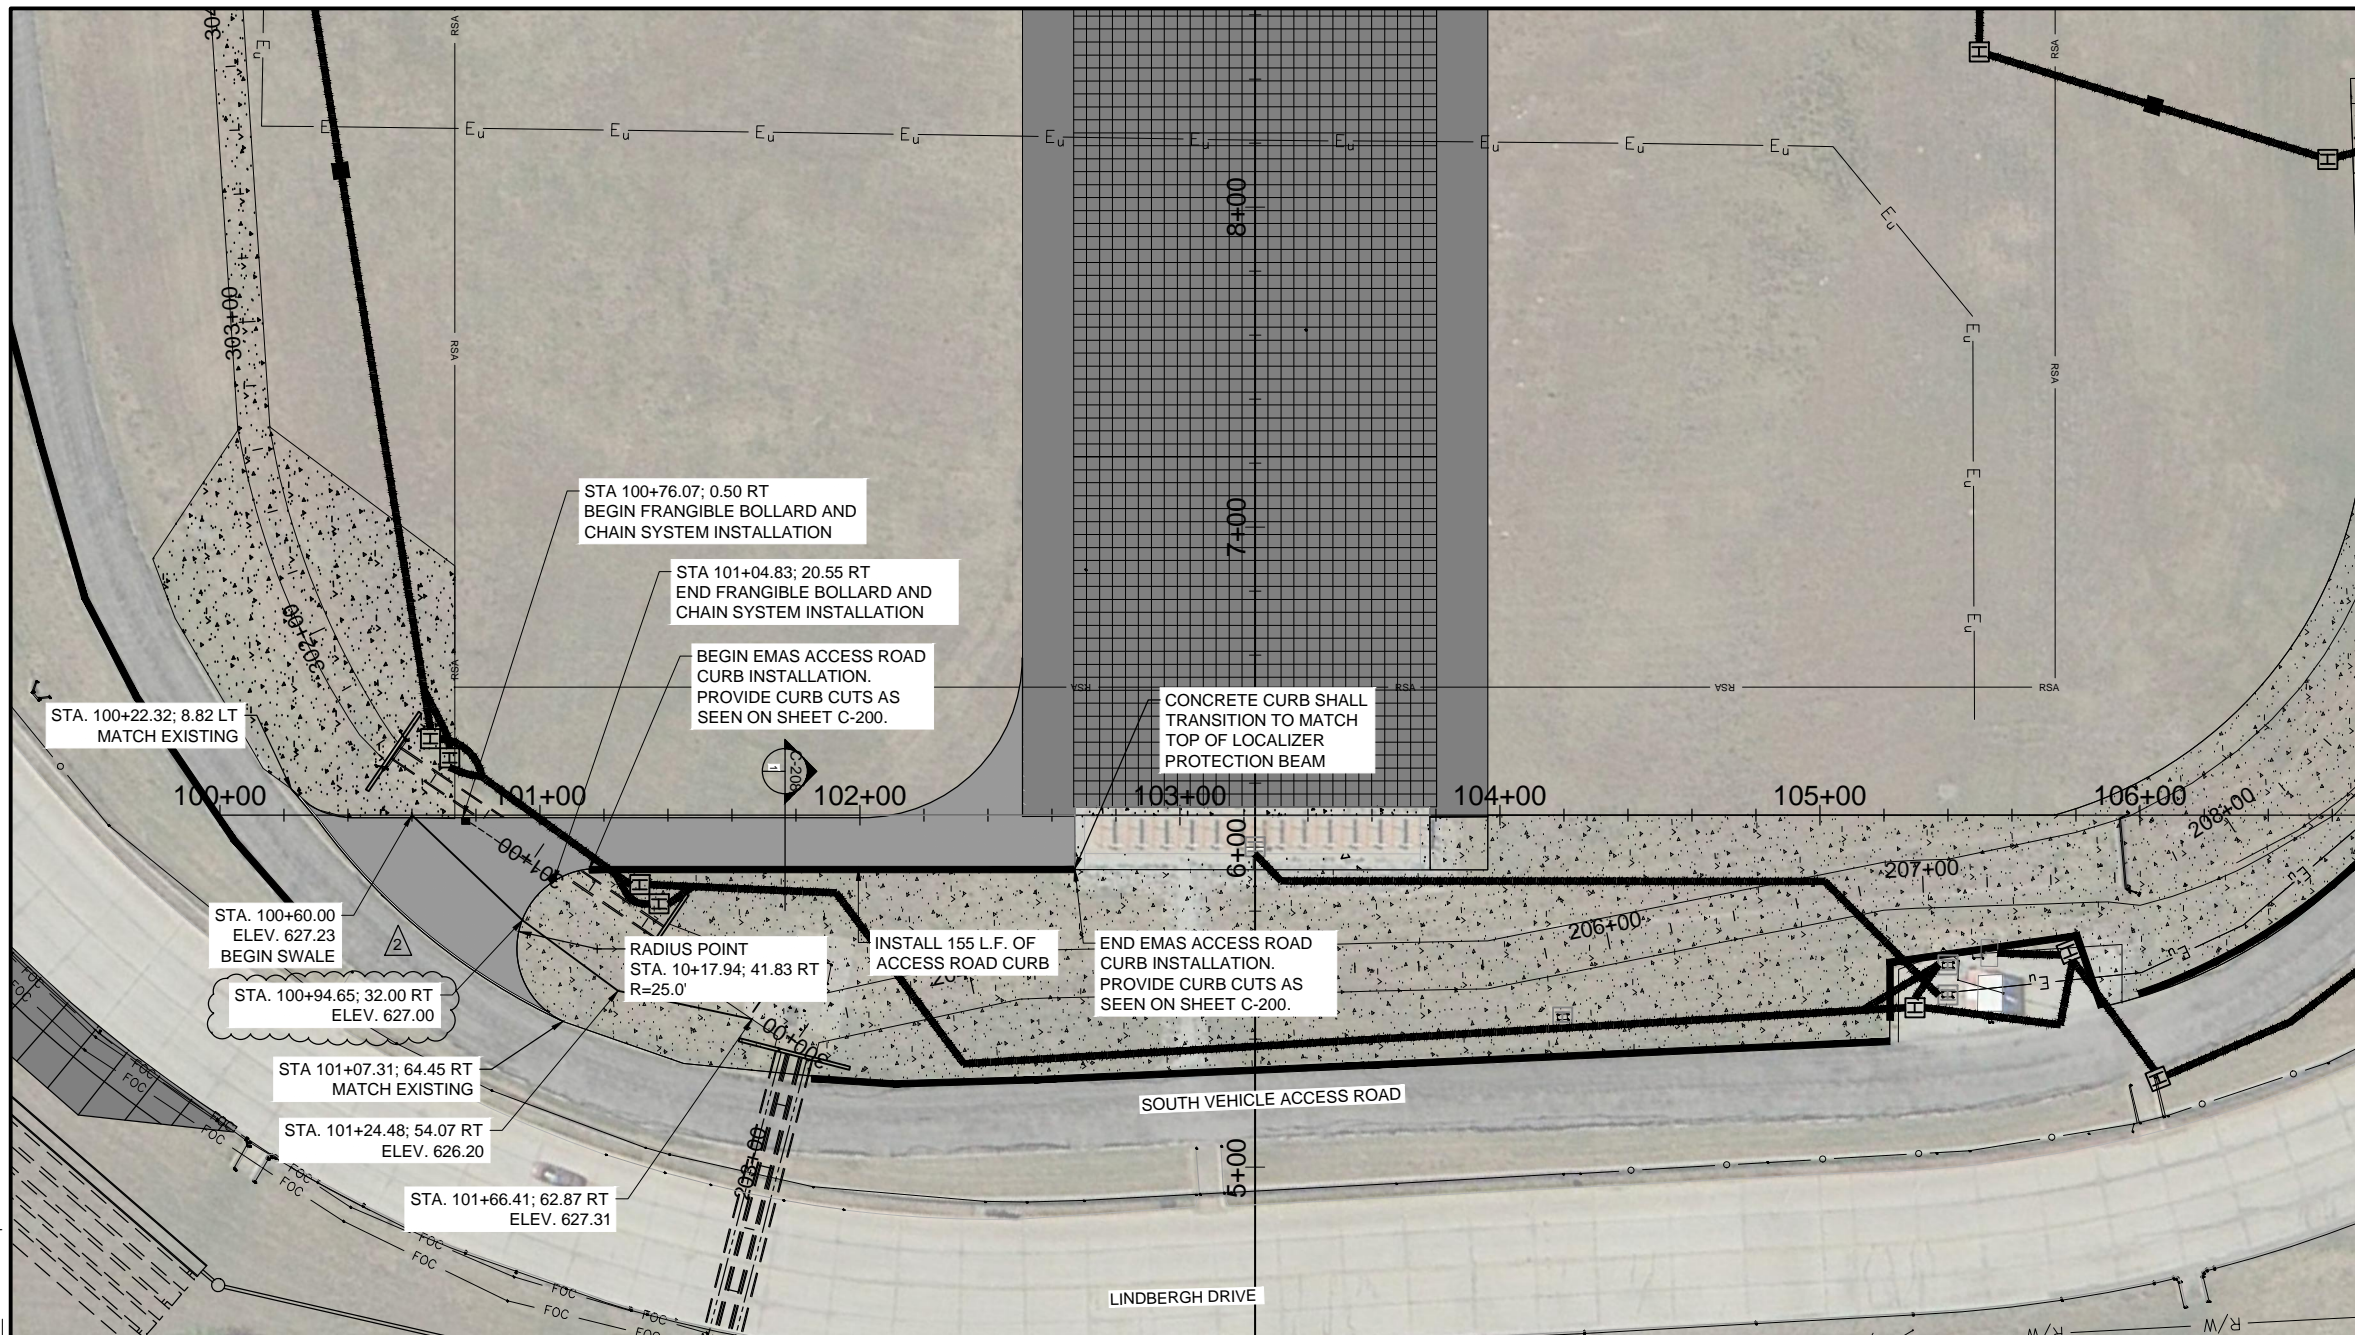

LEGEND

- CONCRETE SLOPE PROTECTION
- PROPOSED ACCESS ROAD
- 6" CONCRETE CURB

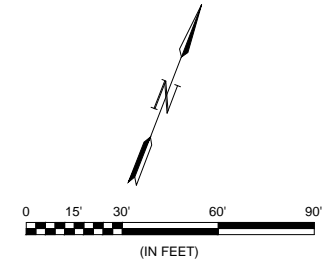

REGISTRATION NO.
F-5713

RECORD DRAWINGS
 03/10/2015

REV.	DATE	DESCRIPTION

ADDISON AIRPORT
 ADDISON, TEXAS
RUNWAY 33 RSA IMPROVEMENTS

EMAS ACCESS ROAD
PLAN & PROFILE

JOB NO.: 13081100
DATE: NOV. , 2013
DESIGNED BY: BCB
DRAWN BY: BCB

BAR IS ONE INCH ON ORIGINAL DRAWING
IF NOT ONE INCH ON THIS SHEET, ADJUST SCALES ACCORDINGLY.

DRAWING NUMBER
C-209
SHEET NUMBER **34**