



C-210
1
SOUTHWEST VEHICLE ACCESS ROAD SECTION
SCALE: NONE

NOTE:

1. SEE ACCESS ROAD REALIGNMENT CROSS SECTIONS (SHEET AR-X1) FOR MORE DETAIL.

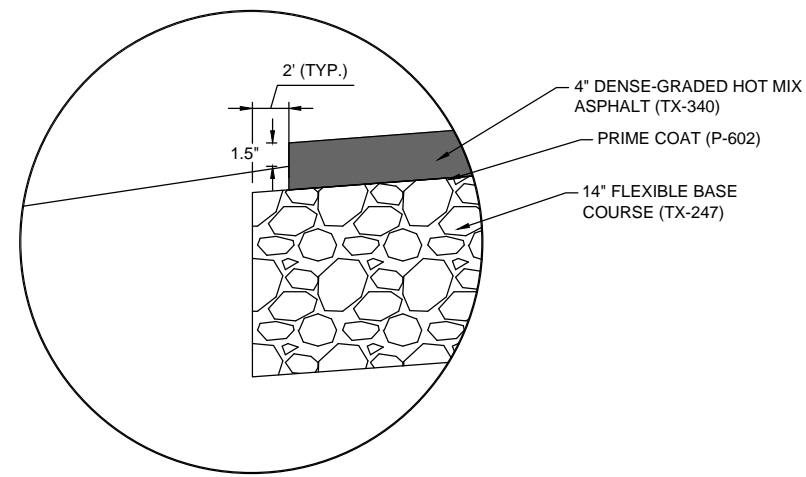

C-210
A
DETAIL "A"
SCALE: NONE

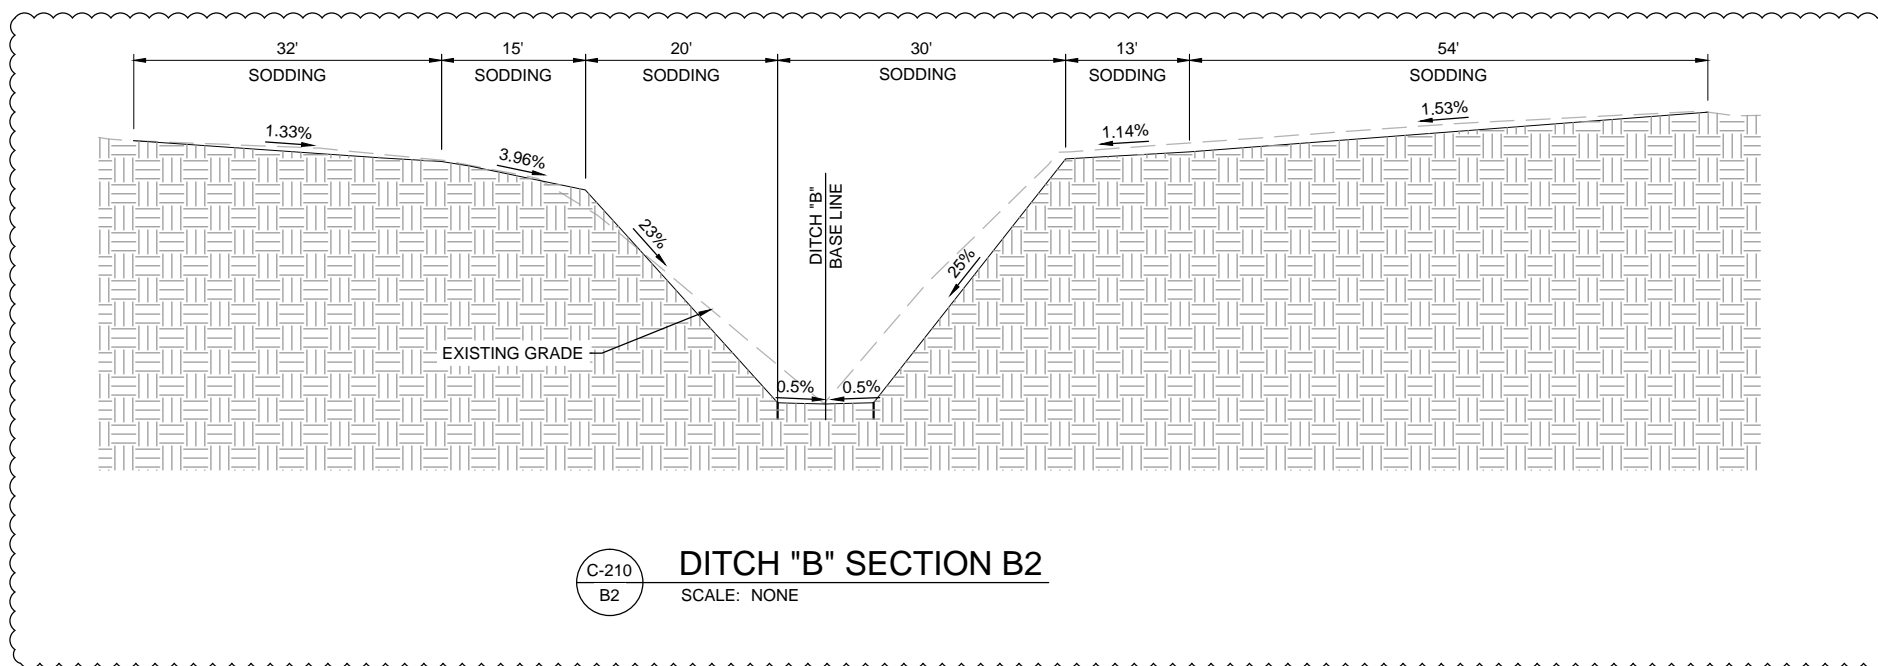

C-210
B2
DITCH "B" SECTION B2
SCALE: NONE

File: I:\2014\14081101 - ads emas construction\Drawings\RECORD\ADS, ENMS, C210_TS.dwg Last Saved: 10/15/2014 1:42 PM Last saved by: JSuarez
Last plotted by: Suarez, Javier Plot Style: AECmonochrome.ctb Plot Date: 3/10/2015 4:52 PM Plotter used: DWG To PDF.pc3



REGISTRATION NO.
F-5713

RECORD DRAWINGS
03/10/2015

REV.	DATE	DESCRIPTION	BY

Addison Airport
ADDISON AIRPORT
ADDISON, TEXAS
RUNWAY 33 RSA IMPROVEMENTS

SOUTHWEST ACCESS ROAD TYPICAL SECTION

JOB NO.: 13081100
DATE: NOV. , 2013
DESIGNED BY: BCB
DRAWN BY: BCB

BAR IS ONE INCH ON ORIGINAL DRAWING
IF NOT ONE INCH ON THIS SHEET, ADJUST SCALES ACCORDINGLY.

DRAWING NUMBER
C-210
SHEET NUMBER **35**