



10/15/2014 1:43 PM Last used: DWG To PDF.pc3

RD\ADS_EMAS_C-213_WD.dwg Last Save:

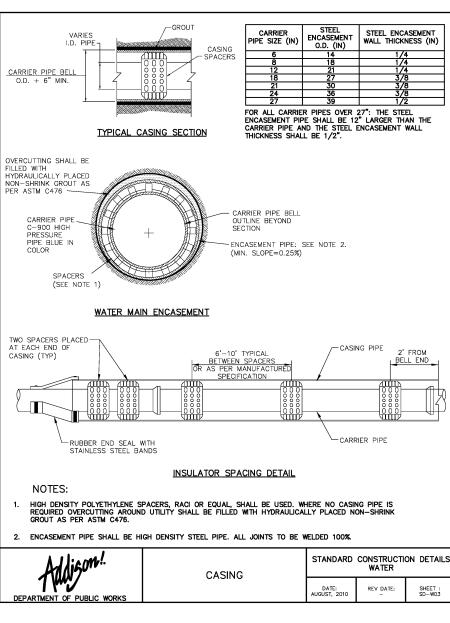

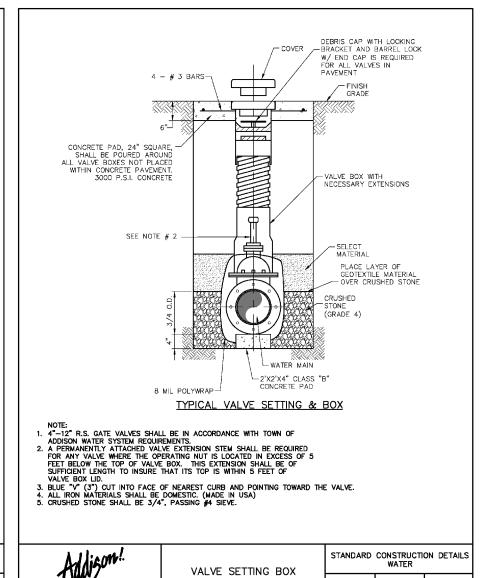

DATE: UGUST, 2010

REV DATE:

SHEET : SD-WO9



REGISTRATION NO. F-5713

> DRAWINGS RECORD

RSA IMPROVEMENTS 33

ADDISON AIRPORT

RUNWAY

WATER LINE DETAILS

JOB NO.: 13081100 DATE: NOV., 2013 DESIGNED BY: BCB DRAWN BY: BCB

DRAWING NUMBER C-213

NUMBER