



REGISTRATION NO.
F-5713

RECORD DRAWINGS
03/10/2015

REV.	DATE	DESCRIPTION	BY



Addison Airport
 ADDISON AIRPORT
 ADDISON, TEXAS
 RUNWAY 33 RSA IMPROVEMENTS

RAINWATER HARVESTING
 TYPICAL SECTION
 (ADD ALTERNATE A)

JOB NO.: 13081100
 DATE: NOV. , 2013
 DESIGNED BY: BCB
 DRAWN BY: BCB


BAR IS ONE INCH ON ORIGINAL DRAWING
 0 1"
 IF NOT ONE INCH ON THIS SHEET, ADJUST SCALES ACCORDINGLY.

DRAWING NUMBER
C-300
 SHEET NUMBER **39**

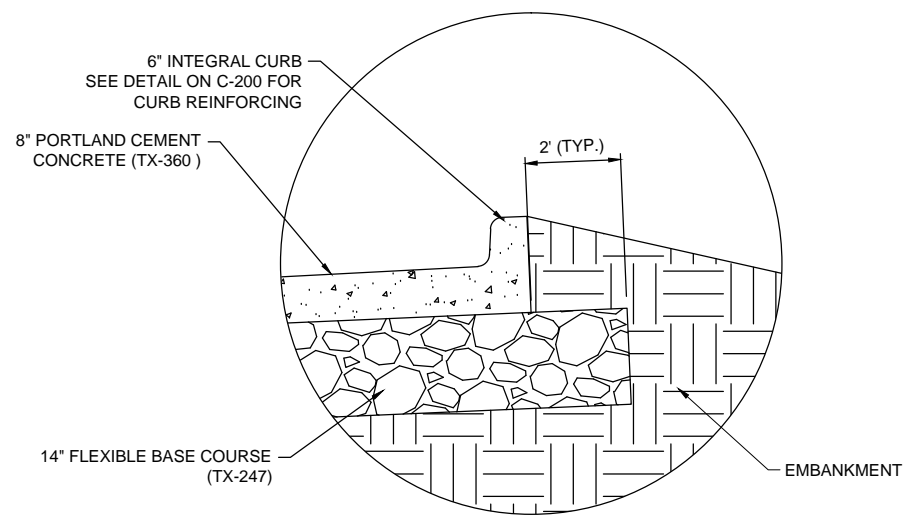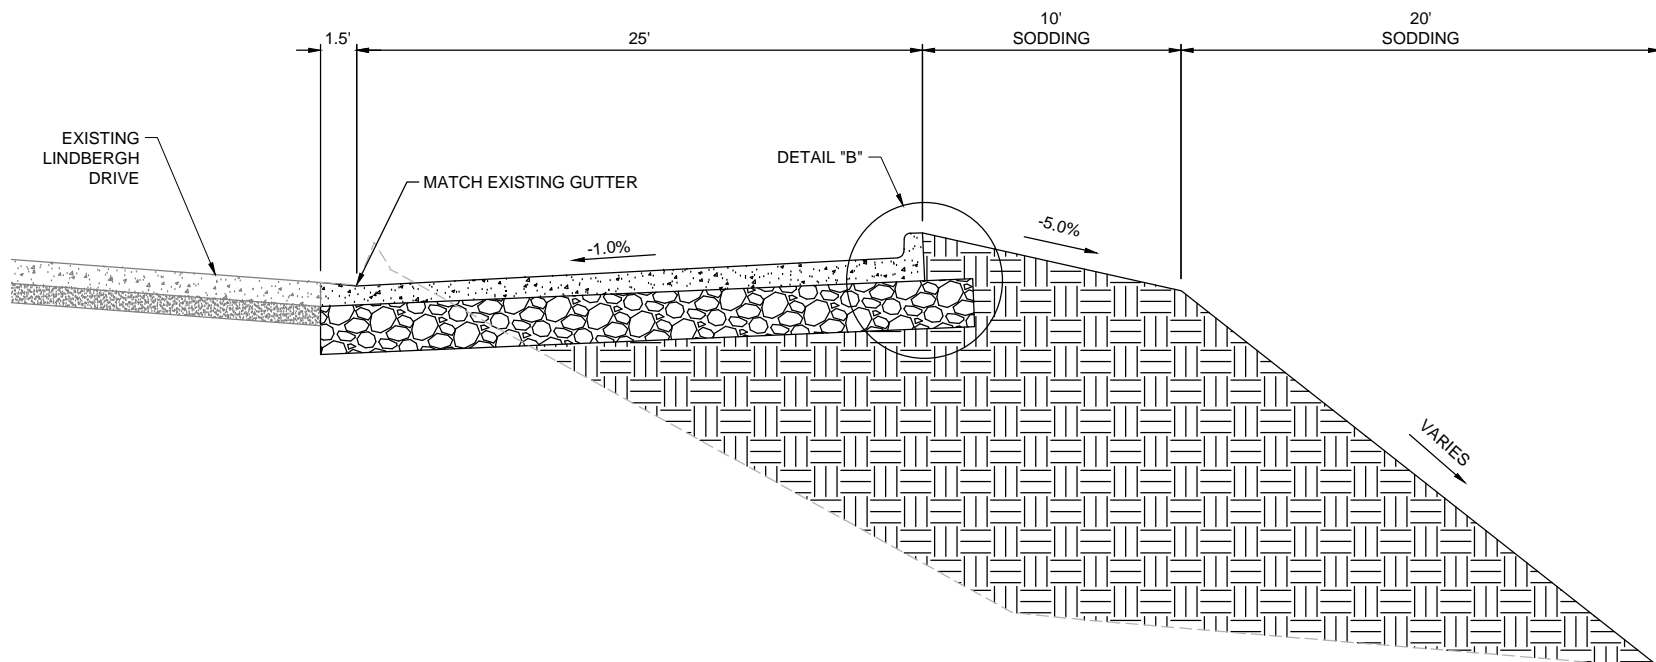

C-300
B
DETAIL "B"
 SCALE: NONE

C-300
1
RAINWATER HARVESTING ACCESS ROAD SECTION
 SCALE: NONE

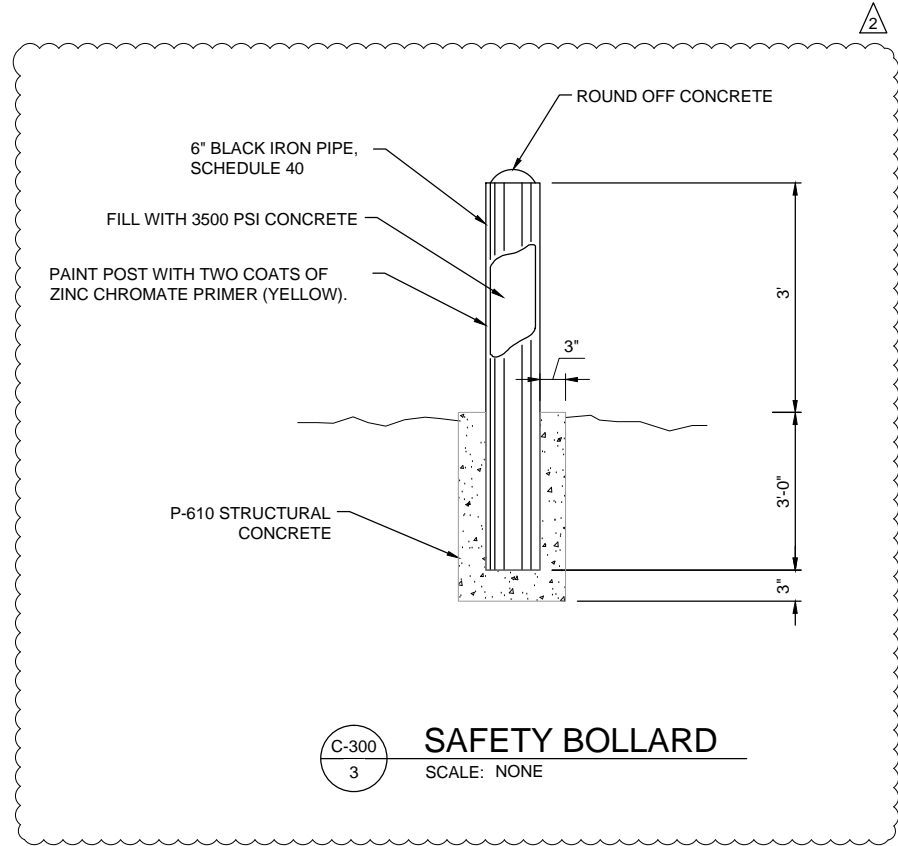

C-300
3
SAFETY BOLLARD
 SCALE: NONE

File: I:\2014\14081101 - ads emas construction\Drawings\RECORD\ADS, ENMS, C-300, RT.dwg Last Save: 10/15/2014 1:43 PM Last saved by: Bcbville
 Last plotted by: Suarez, Javier Plot Style: AECmonochrome.ctb Plot Date: 3/10/2015 4:54 PM Plotter used: DWG To PDF.pc3