



REGISTRATION NO.  
F-5713

RECORD DRAWINGS  
03/10/2015

REV.	DATE	DESCRIPTION	BY
1	03-20-15	RECORD DRAWINGS	MRM


**Addison Airport**  
ADDISON, TEXAS  
RUNWAY 33 RSA IMPROVEMENTS

RAINWATER HARVESTING LAYOUT PLAN (ADD ALTERNATE A)

JOB NO.: 13081100  
DATE: NOV. , 2013  
DESIGNED BY: BCB  
DRAWN BY: BCB

BAR IS ONE INCH ON ORIGINAL DRAWING  
IF NOT ONE INCH ON THIS SHEET, ADJUST SCALES ACCORDINGLY.

DRAWING NUMBER  
**C-301**  
SHEET NUMBER **40**

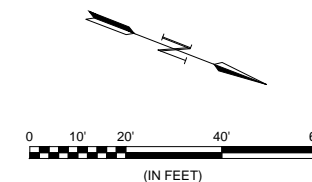

**LEGEND**


PROPOSED 48" CISTERN EXPANSION

FUTURE 48" CISTERN EXPANSION

FOR JOINT DETAILS SEE SHEET C-304

**BASELINE POINTS**

DESCRIPTION	STATION	NORTHING	EASTING	RADIUS	LENGTH	DELTA
RAINWATER HARVESTING SYSTEM ACCESS ROAD						
PC	701+00.00	7036432.21	2480021.51			
PI	702+01.68	7036379.78	2480108.63	449.84'	200.01'	25°28'29"L
PT	703+00.01	7036369.91	2480253.49			

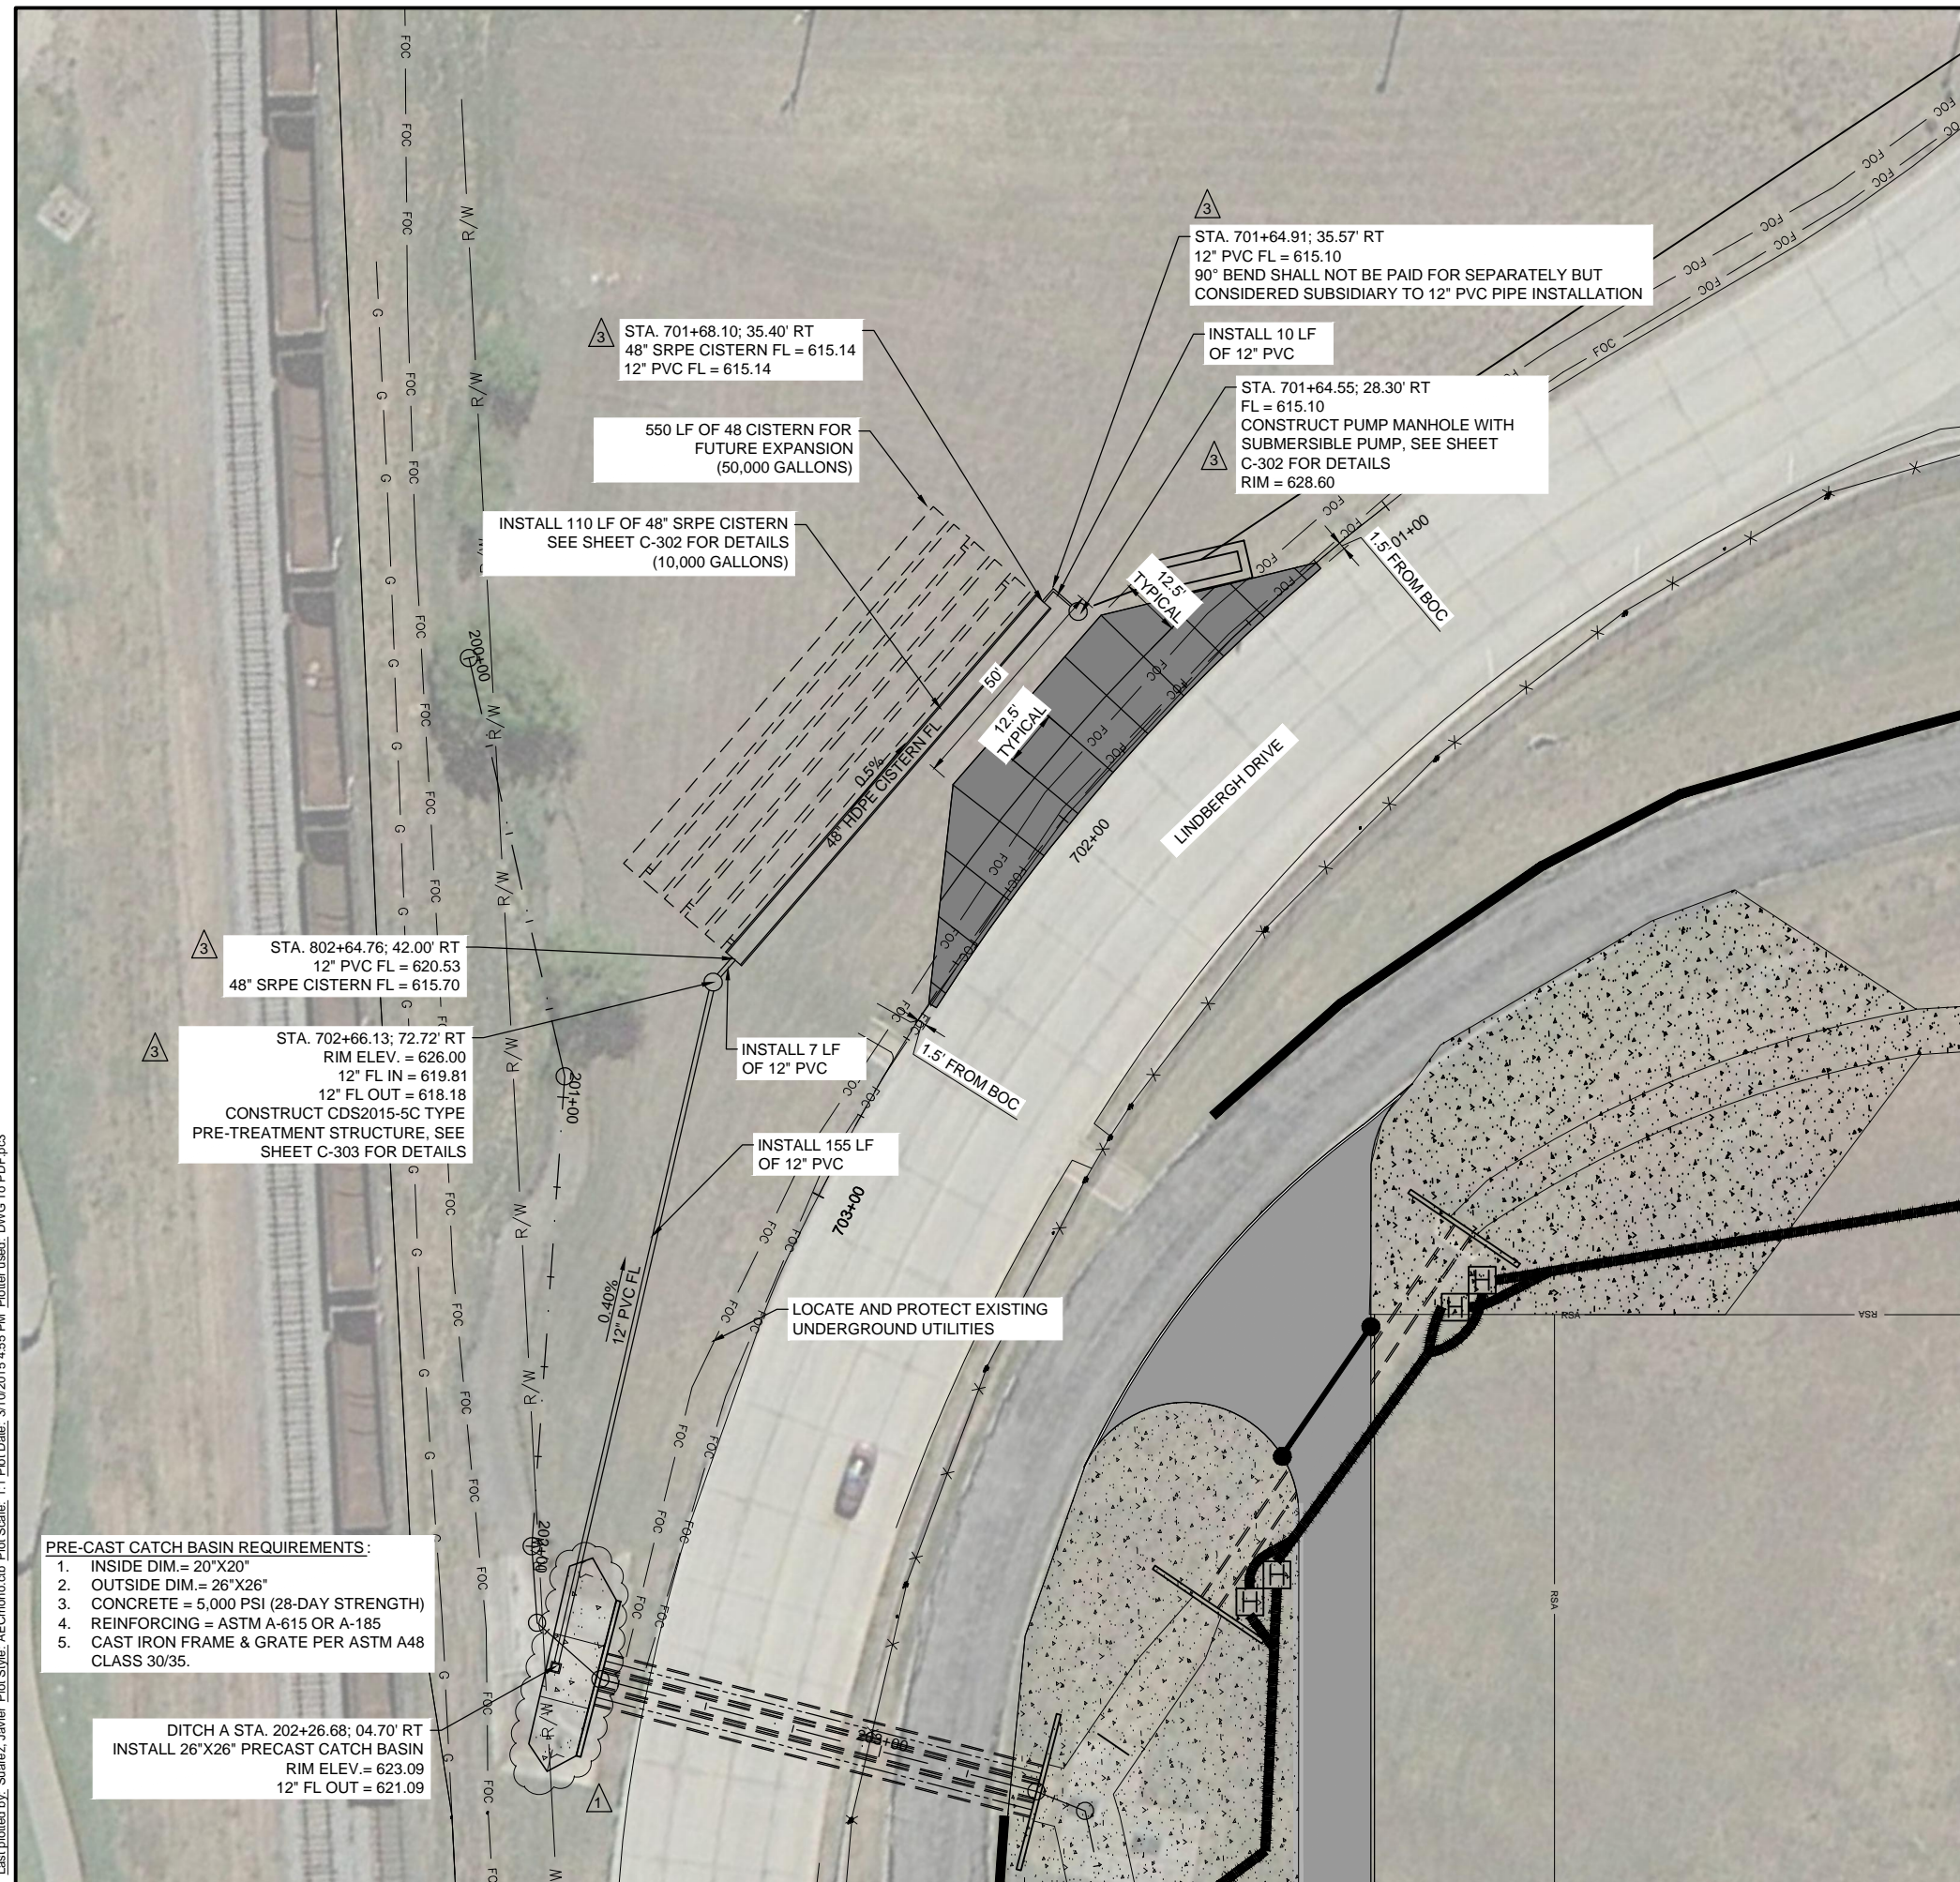

File: I:\2014\14081101 - ads emas construction\Drawings\RECORD\ADS\_EMAS\_C301\_RL.dwg Last Save: 3/10/2015 3:15 PM Last saved by: JSuarez  
Last plotted by: Suarez, Javier Plot Style: AECmonochrome.ctb Plot Date: 3/10/2015 4:55 PM Plotter used: DWG To PDF.pc3