

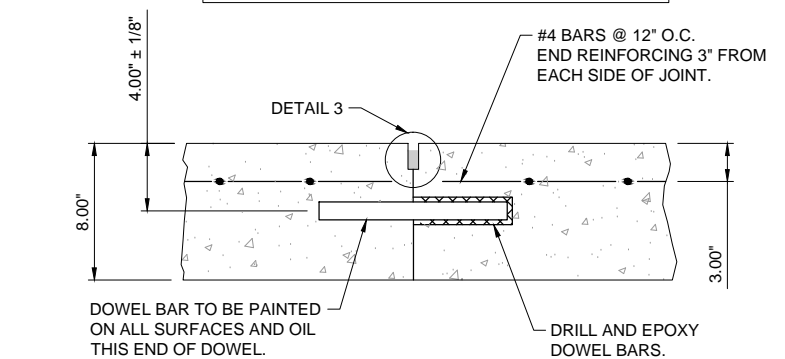
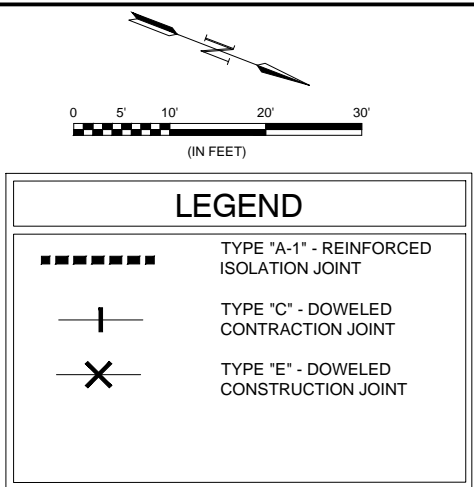



File: I:\2014\14081101 - ads emas construction\Drawings\RECORD\ADS_EMAS_C304_RD.dwg Last Save: 10/15/2014 1:43 PM Last saved by: Mirmanally
 Last Plotted by: Suarez, Javier Plot Style: AECmonochrome.ctb Plot Scale: 1:1 Plot Date: 3/10/2015 4:56 PM Plotter used: DWG To PDF.pc3

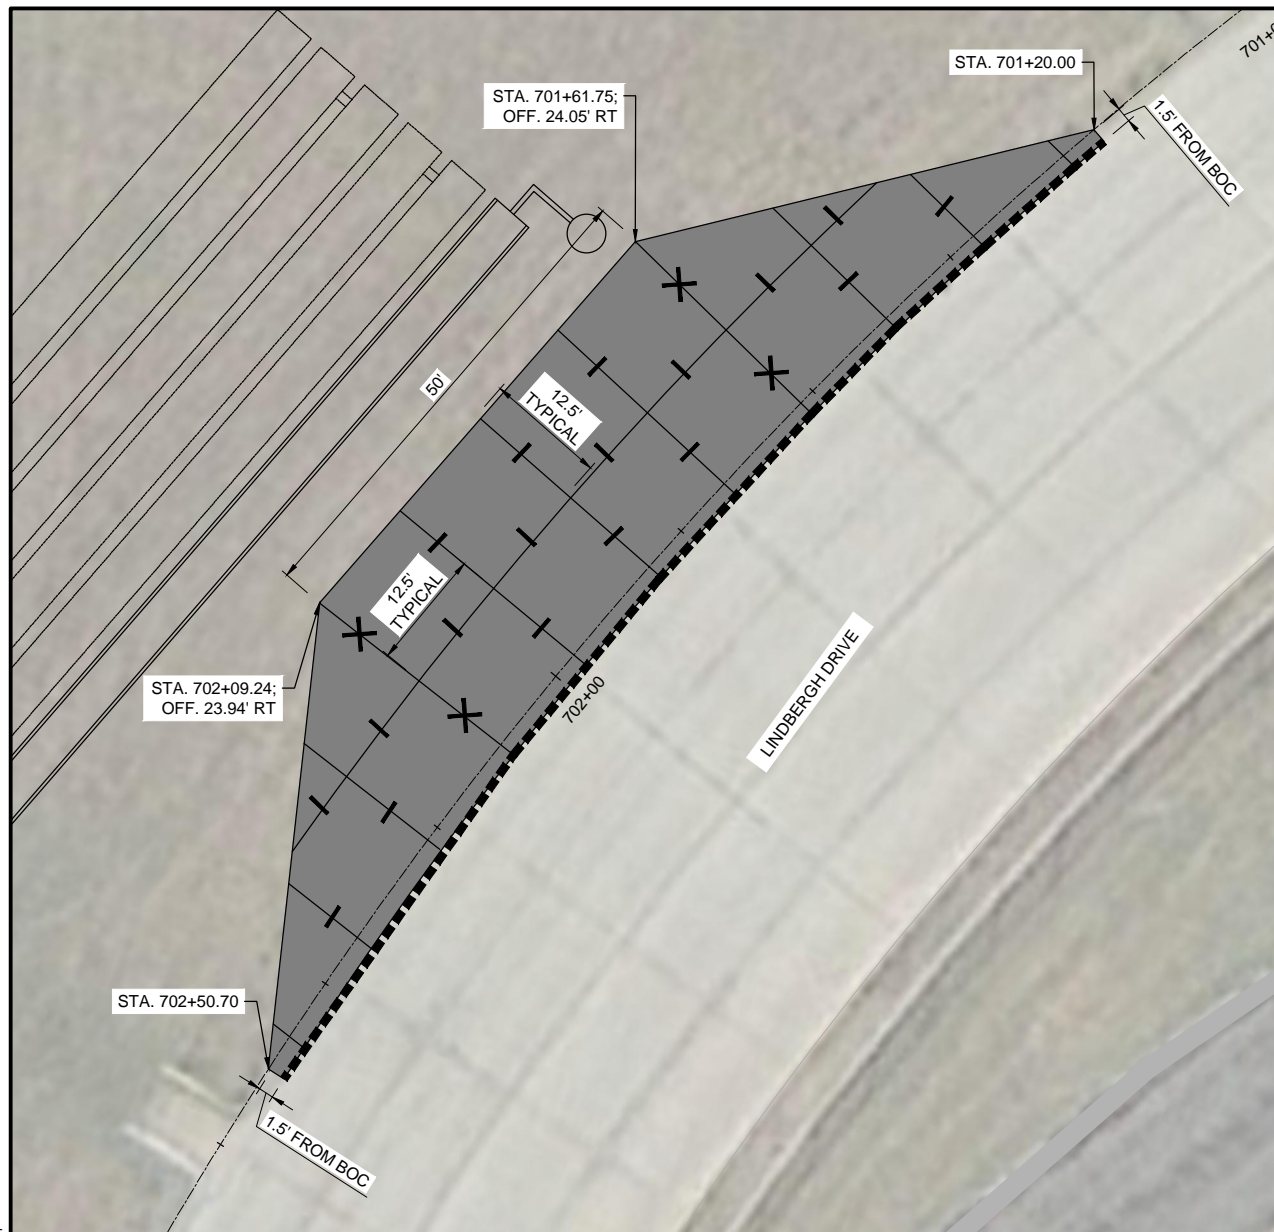


C-304 3 TYPE E-DOWELED CONSTRUCTION JOINT
SCALE: NONE

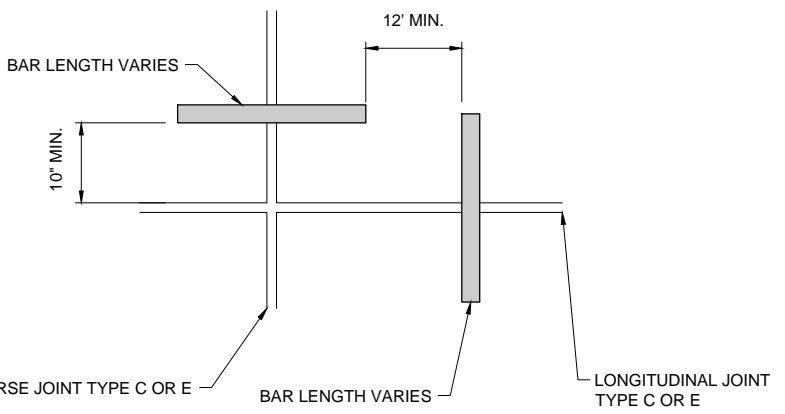


C-304 4 DOWEL BARS AT SLAB CORNERS (PLAN VIEW)
SCALE: NONE

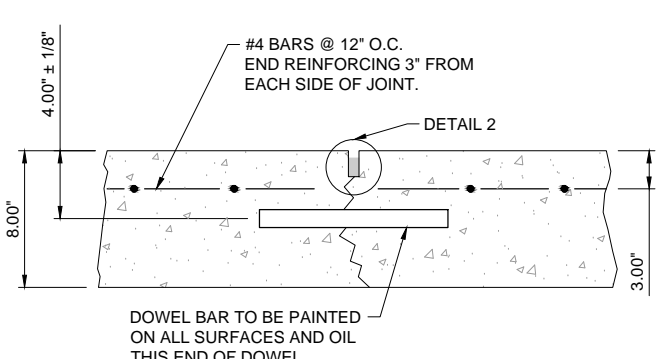


C-304 1 TYPE C-DOWELED CONTRACTION JOINT
SCALE: NONE

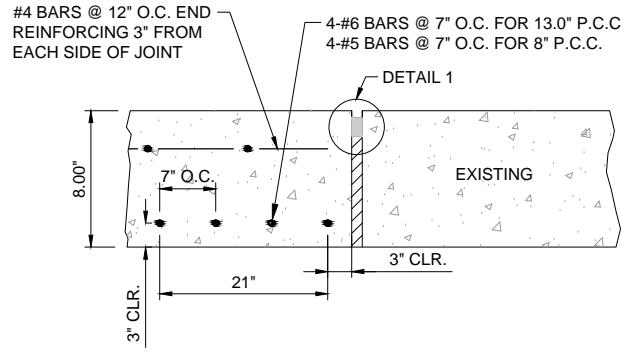


C-304 2 TYPE A-1-REINFORCED ISOLATION JOINT
SCALE: NONE

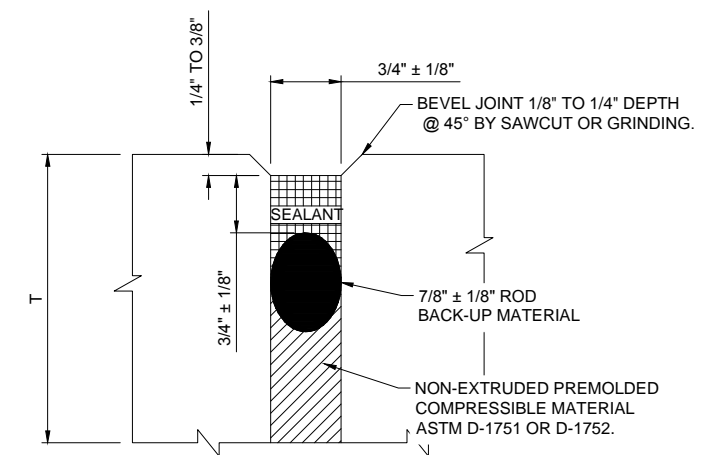

C-304 D1 DETAIL 1 - CONSTRUCTION JOINTS
SCALE: NONE

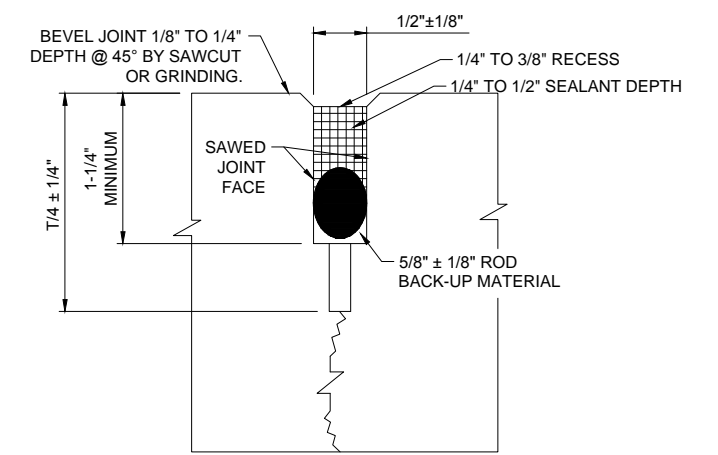


C-304 D2 DETAIL 2 - CONSTRUCTION JOINTS
SCALE: NONE

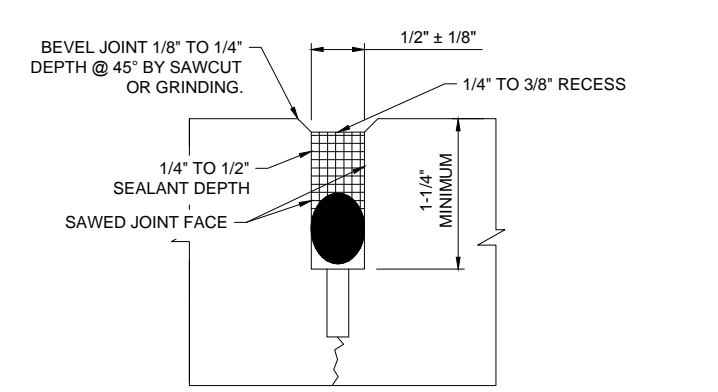

C-304 D3 DETAIL 3 - CONSTRUCTION JOINTS
SCALE: NONE

DOWEL BAR SPECIFICATIONS			
SLAB THICKNESS	DOWEL DIAMETER	DOWEL LENGTH	DOWEL SPACING
8"	1"	19"	12"

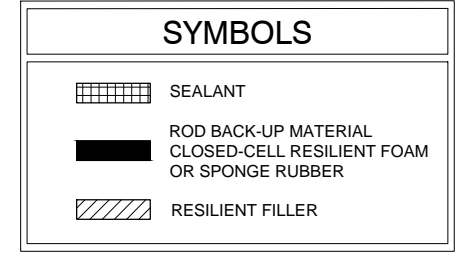

REGISTRATION NO. F-5713

RECORD DRAWINGS
03/10/2015

REV.	DATE	DESCRIPTION	BY

Addison Airport
 ADDISON, TEXAS
 RUNWAY 33 RSA IMPROVEMENTS

RAINWATER HARVESTING DETAILS III (ADD ALTERNATE A)

JOB NO.: 13081100
DATE: NOV., 2013
DESIGNED BY: BCB
DRAWN BY: BCB

BAR IS ONE INCH ON ORIGINAL DRAWING
IF NOT ONE INCH ON THIS SHEET, ADJUST SCALES ACCORDINGLY.

DRAWING NUMBER
C-304

SHEET NUMBER
43