
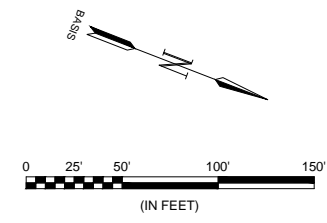


File: I:\2014\14081101 - ads emas construction\Drawings\RECORD\ADS_E101_DP.dwg Last Save: 10/15/2014 4:56 PM Last saved by: JKSchmitt
 Last Plotted by: Suarez, Javier Plot Style: AECmono.ctb Plot Date: 3/10/2015 4:57 PM Plotter used: DWG To PDF.pc3

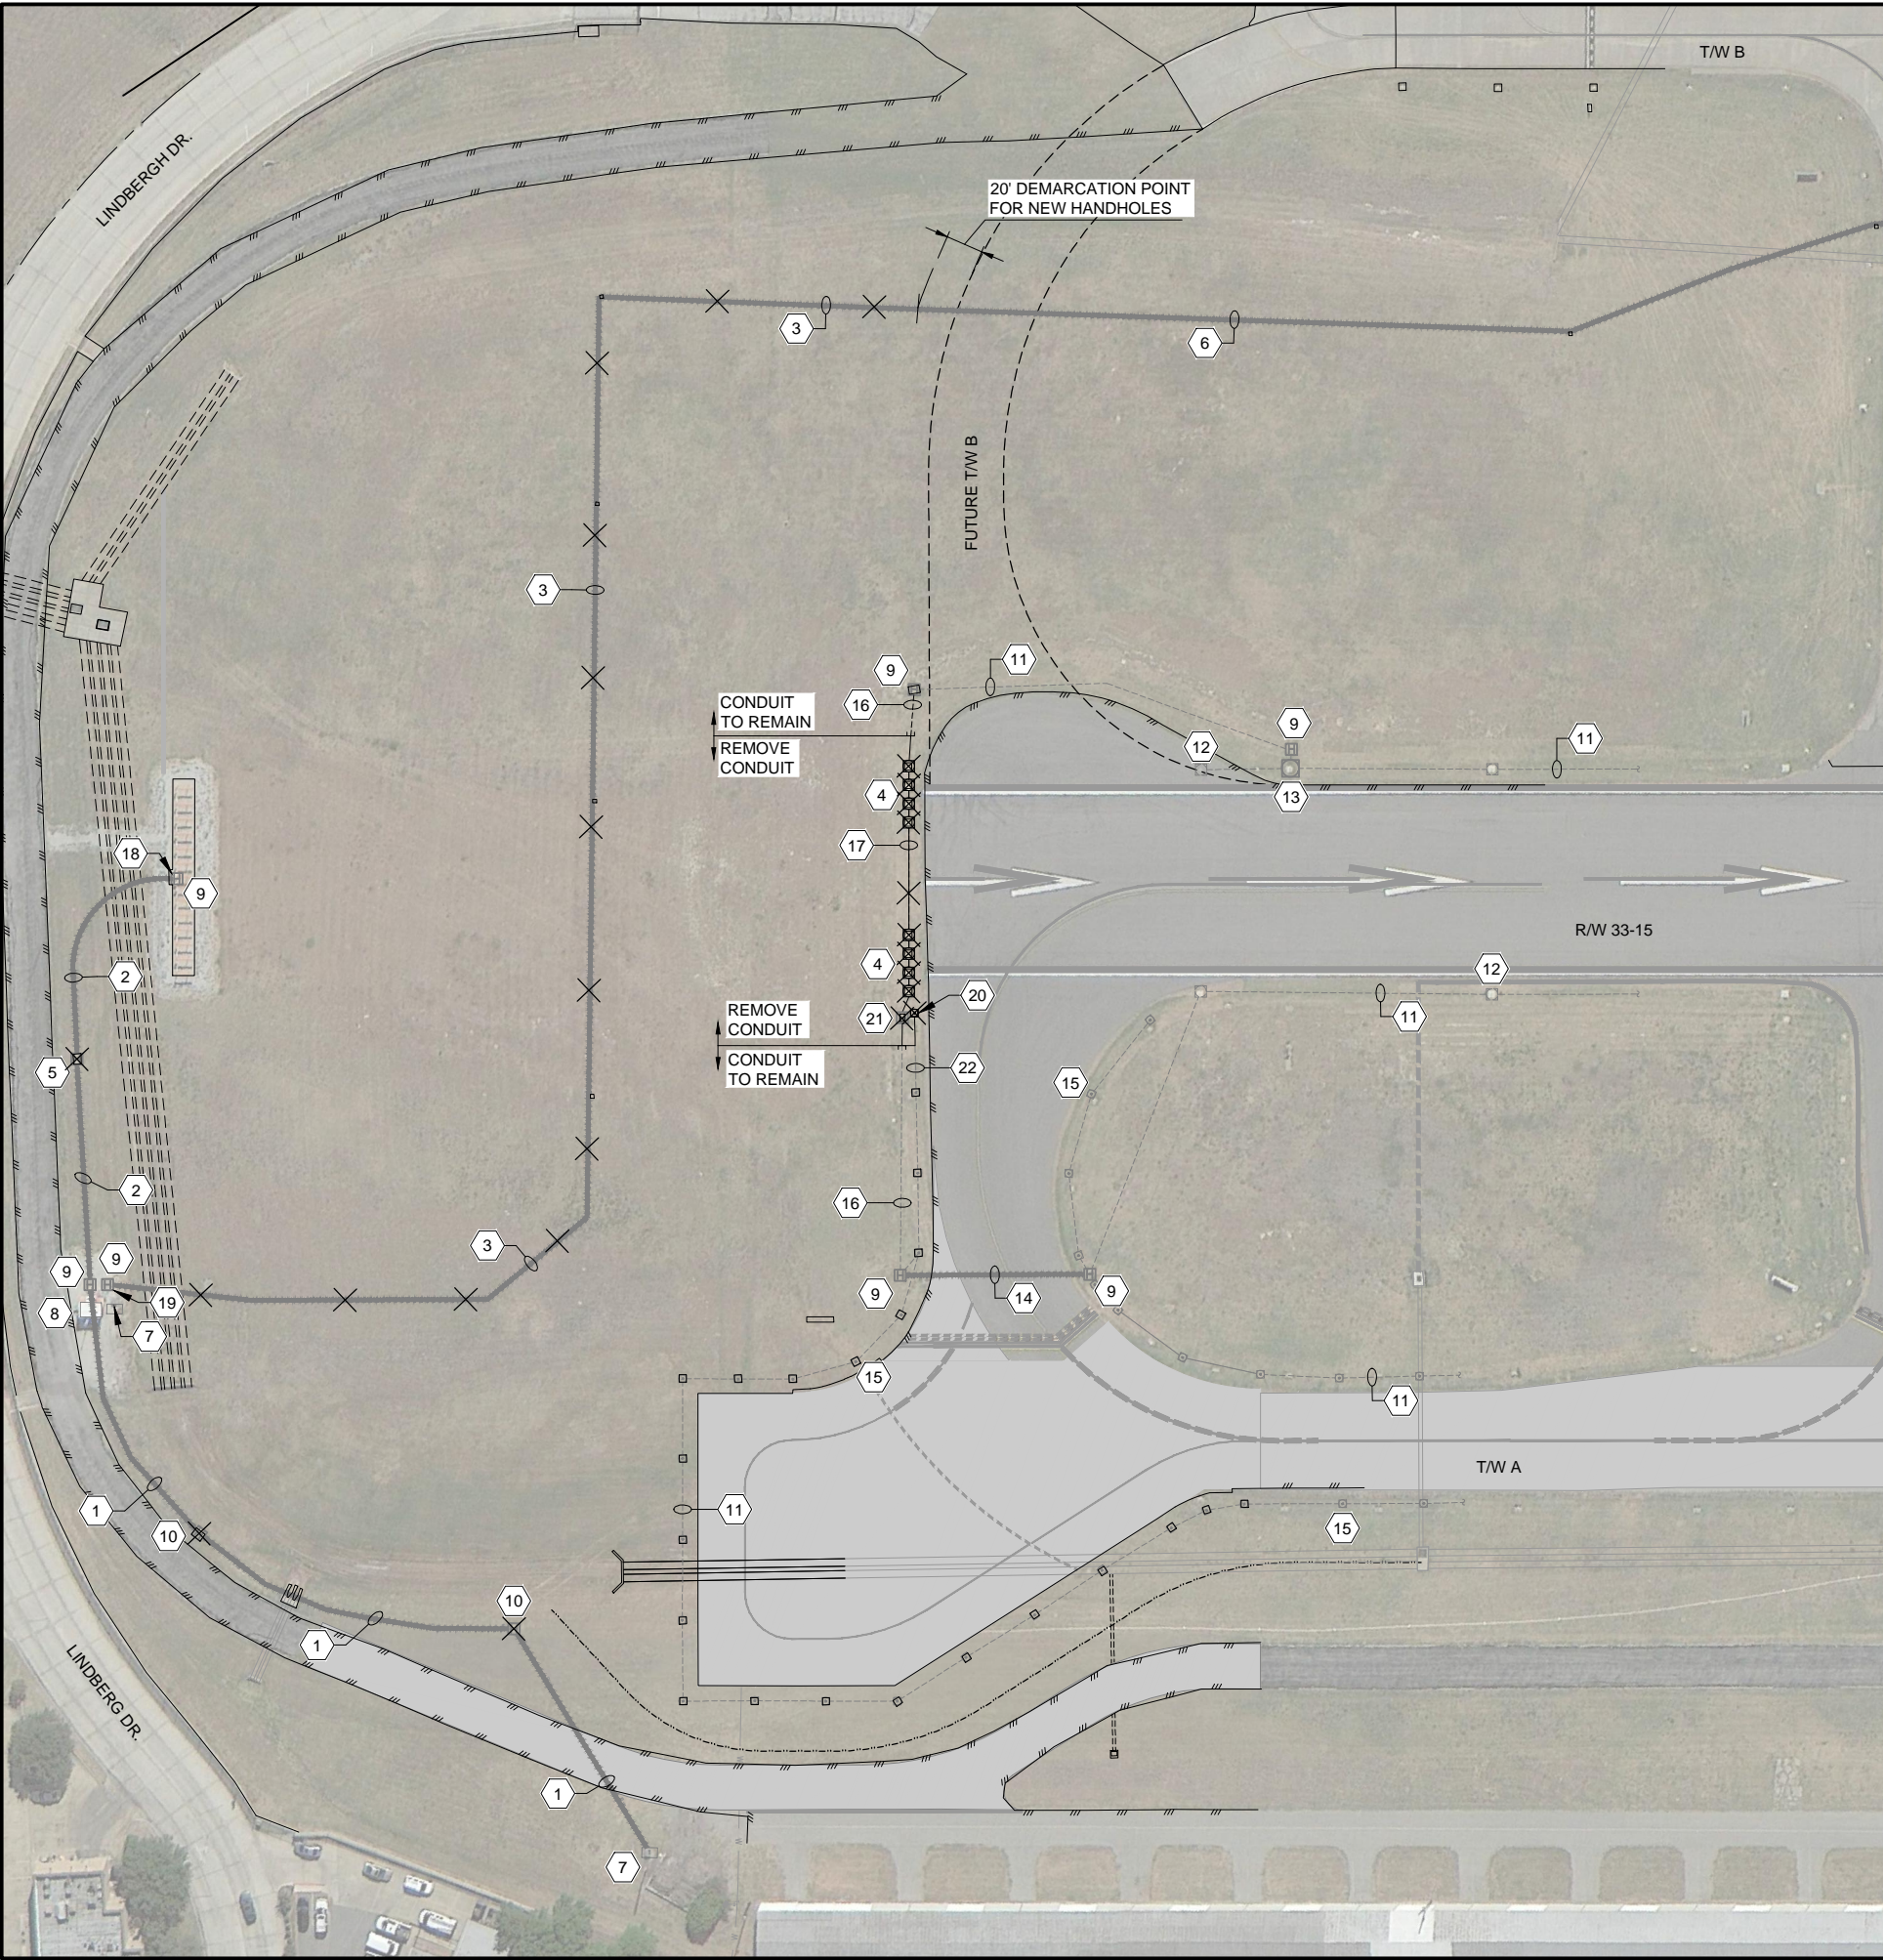

DEMOLITION KEYED NOTES:

- 1 ABANDON EXISTING 1W-2"C CONDUIT IN PLACE AND REMOVE EXISTING FAA LOCALIZER POWER CABLE BACK TO TRANSFORMER SECONDARY TERMINALS.
- 2 REMOVE EXISTING FAA LOCALIZER POWER, CONTROL, AND ANTENNA CABLES FROM EXISTING NON-ENCASED DUCT BANK BACK TO SHELTER. DEMOLISH EXISTING NON-ENCASED 4W-4" DUCT BANK. THE COST OF ELECTRICAL DUCT DEMOLITION SHALL BE SUBSIDIARY TO THE HANDHOLE DEMOLITION PAY ITEM.
- 3 ABANDON EXISTING DEB REIL POWER , GLIDESLOPE POWER, AND GLIDESLOPE COMMUNICATIONS CABLES IN PLACE TO DEMARCATION POINT INDICATED.
- 4 REMOVE AND STORE EXISTING L-862E RUNWAY END LIGHT FOR RE-INSTALLATION. DEMOLISH BASE. (TYPICAL)
- 5 REMOVE EXISTING FAA POWER, CONTROL, AND ANTENNA CABLES FROM HANDHOLE. DEMOLISH HANDHOLE.
- 6 EXISTING DEB REIL POWER, GLIDESLOPE POWER, AND GLIDESLOPE COMMUNICATION CABLES TO REMAIN. PROTECT DURING CONSTRUCTION.
- 7 EXISTING FAA NAVAIDS TRANSFORMER TO REMAIN. PROTECT DURING CONSTRUCTION.
- 8 EXISTING LOCALIZER SHELTER TO REMAIN. PROTECT DURING CONSTRUCTION.
- 9 EXISTING HANDHOLE TO REMAIN. PROTECT DURING CONSTRUCTION.
- 10 REMOVE EXISTING HANDHOLE. DEMOLISH BASE AND RESTORE SITE TO MATCH SURROUNDING AREA.
- 11 EXISTING AIRFIELD LIGHTING CIRCUIT TO REMAIN. PROTECT DURING CONSTRUCTION.
- 12 EXISTING RUNWAY LIGHT TO REMAIN. PROTECT DURING CONSTRUCTION. (TYPICAL)
- 13 EXISTING JUNCTION STRUCTURE TO REMAIN. PROTECT DURING CONSTRUCTION.
- 14 EXISTING DUCT TO REMAIN. PROTECT DURING CONSTRUCTION.
- 15 EXISTING TAXIWAY LIGHT TO REMAIN. PROTECT DURING CONSTRUCTION. (TYPICAL)
- 16 REMOVE EXISTING RUNWAY LIGHTING CIRCUIT BACK TO HANDHOLES AND MAINTAIN EXISTING CONDUIT IN PLACE UP TO DEMARCATION POINTS INDICATED.
- 17 REMOVE EXISTING RUNWAY LIGHTING CIRCUIT AND REMOVE 2" CONDUIT UP TO DEMARCATION POINTS INDICATED.
- 18 COORDINATE EXTENT OF DUCT BANK DEMOLITION WITH DUCT BANK EXTENSION.
- 19 REMOVE EXISTING REIL POWER, GLIDESLOPE POWER, AND GLIDESLOPE COMMUNICATIONS CABLES FROM HANDHOLE. PREPARE HANDHOLE FOR NEW DUCT CONNECTION.
- 20 REMOVE AND STORE EXISTING L-861T TAXIWAY EDGE LIGHT FOR RE-INSTALLATION. DEMOLISH BASE. (TYPICAL)
- 21 REMOVE EXISTING RUNWAY LIGHTING CIRCUIT FROM HANDHOLE. DEMOLISH HANDHOLE.
- 22 REMOVE EXISTING TAXIWAY CIRCUIT BACK TO TAXIWAY LIGHTS AND MAINTAIN EXISTING CONDUIT IN PLACE UP TO DEMARCATION POINTS INDICATED.

GENERAL KEYED NOTES:

1. ALL WORK WITHIN A 10' PERIMETER OF THE LOCALIZER SHELTER SHALL BE CONSIDERED SUBSIDIARY TO THE LOCALIZER SHELTER MODIFICATIONS PAY ITEM.
2. SEE SHEET E-001 FOR LEGEND AND ABBREVIATIONS, GENERAL CONSTRUCTION NOTES, CAUTION NOTES, AND ELECTRICAL SAFETY NOTES.



REGISTRATION NO. F-5713

RECORD DRAWINGS
03/10/2015

REV.	DATE	DESCRIPTION	BY

ADDISON AIRPORT
 ADDISON, TEXAS
 RUNWAY 33 RSA IMPROVEMENTS

AIRFIELD ELECTRICAL IMPROVEMENTS DEMOLITION PLAN

JOB NO.: 13081100
 DATE: NOV. , 2013
 DESIGNED BY: MCL
 DRAWN BY: JKS

BAR IS ONE INCH ON ORIGINAL DRAWING
 IF NOT ONE INCH ON THIS SHEET, ADJUST SCALES ACCORDINGLY.

DRAWING NUMBER
E-101
 SHEET NUMBER **45**