



File: I:\2014\14081101 - ads emas construction\Drawings\RECORD\ADS\_EMAS\_CSO\_XS.dwg Last Save: 10/15/2014 1:43 PM Last saved by: Baboville  
 Last plotted by: Suarez, Javier Plot Style: AECmono.ctb Plot Date: 3/10/2015 5:00 PM Plotter used: DWG To PDF.pc3

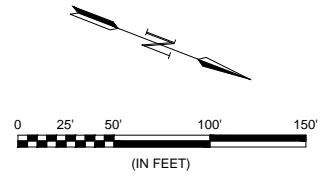

### LEGEND

- EAST AREA - SEE SHEETS EA-X1 TO EA-X4.
- WEST AREA - SEE SHEETS WA-X1 TO #####.
- SOUTH AREA - SEE SHEETS SA-X1 TO SA-X6.
- SOUTHWEST VEHICLE ACCESS ROAD - SEE SHEETS AR-X1 TO AR-X3.
- RAINWATER HARVESTING SYSTEM ACCESS - SEE SHEETS RW-01 TO RW-03.

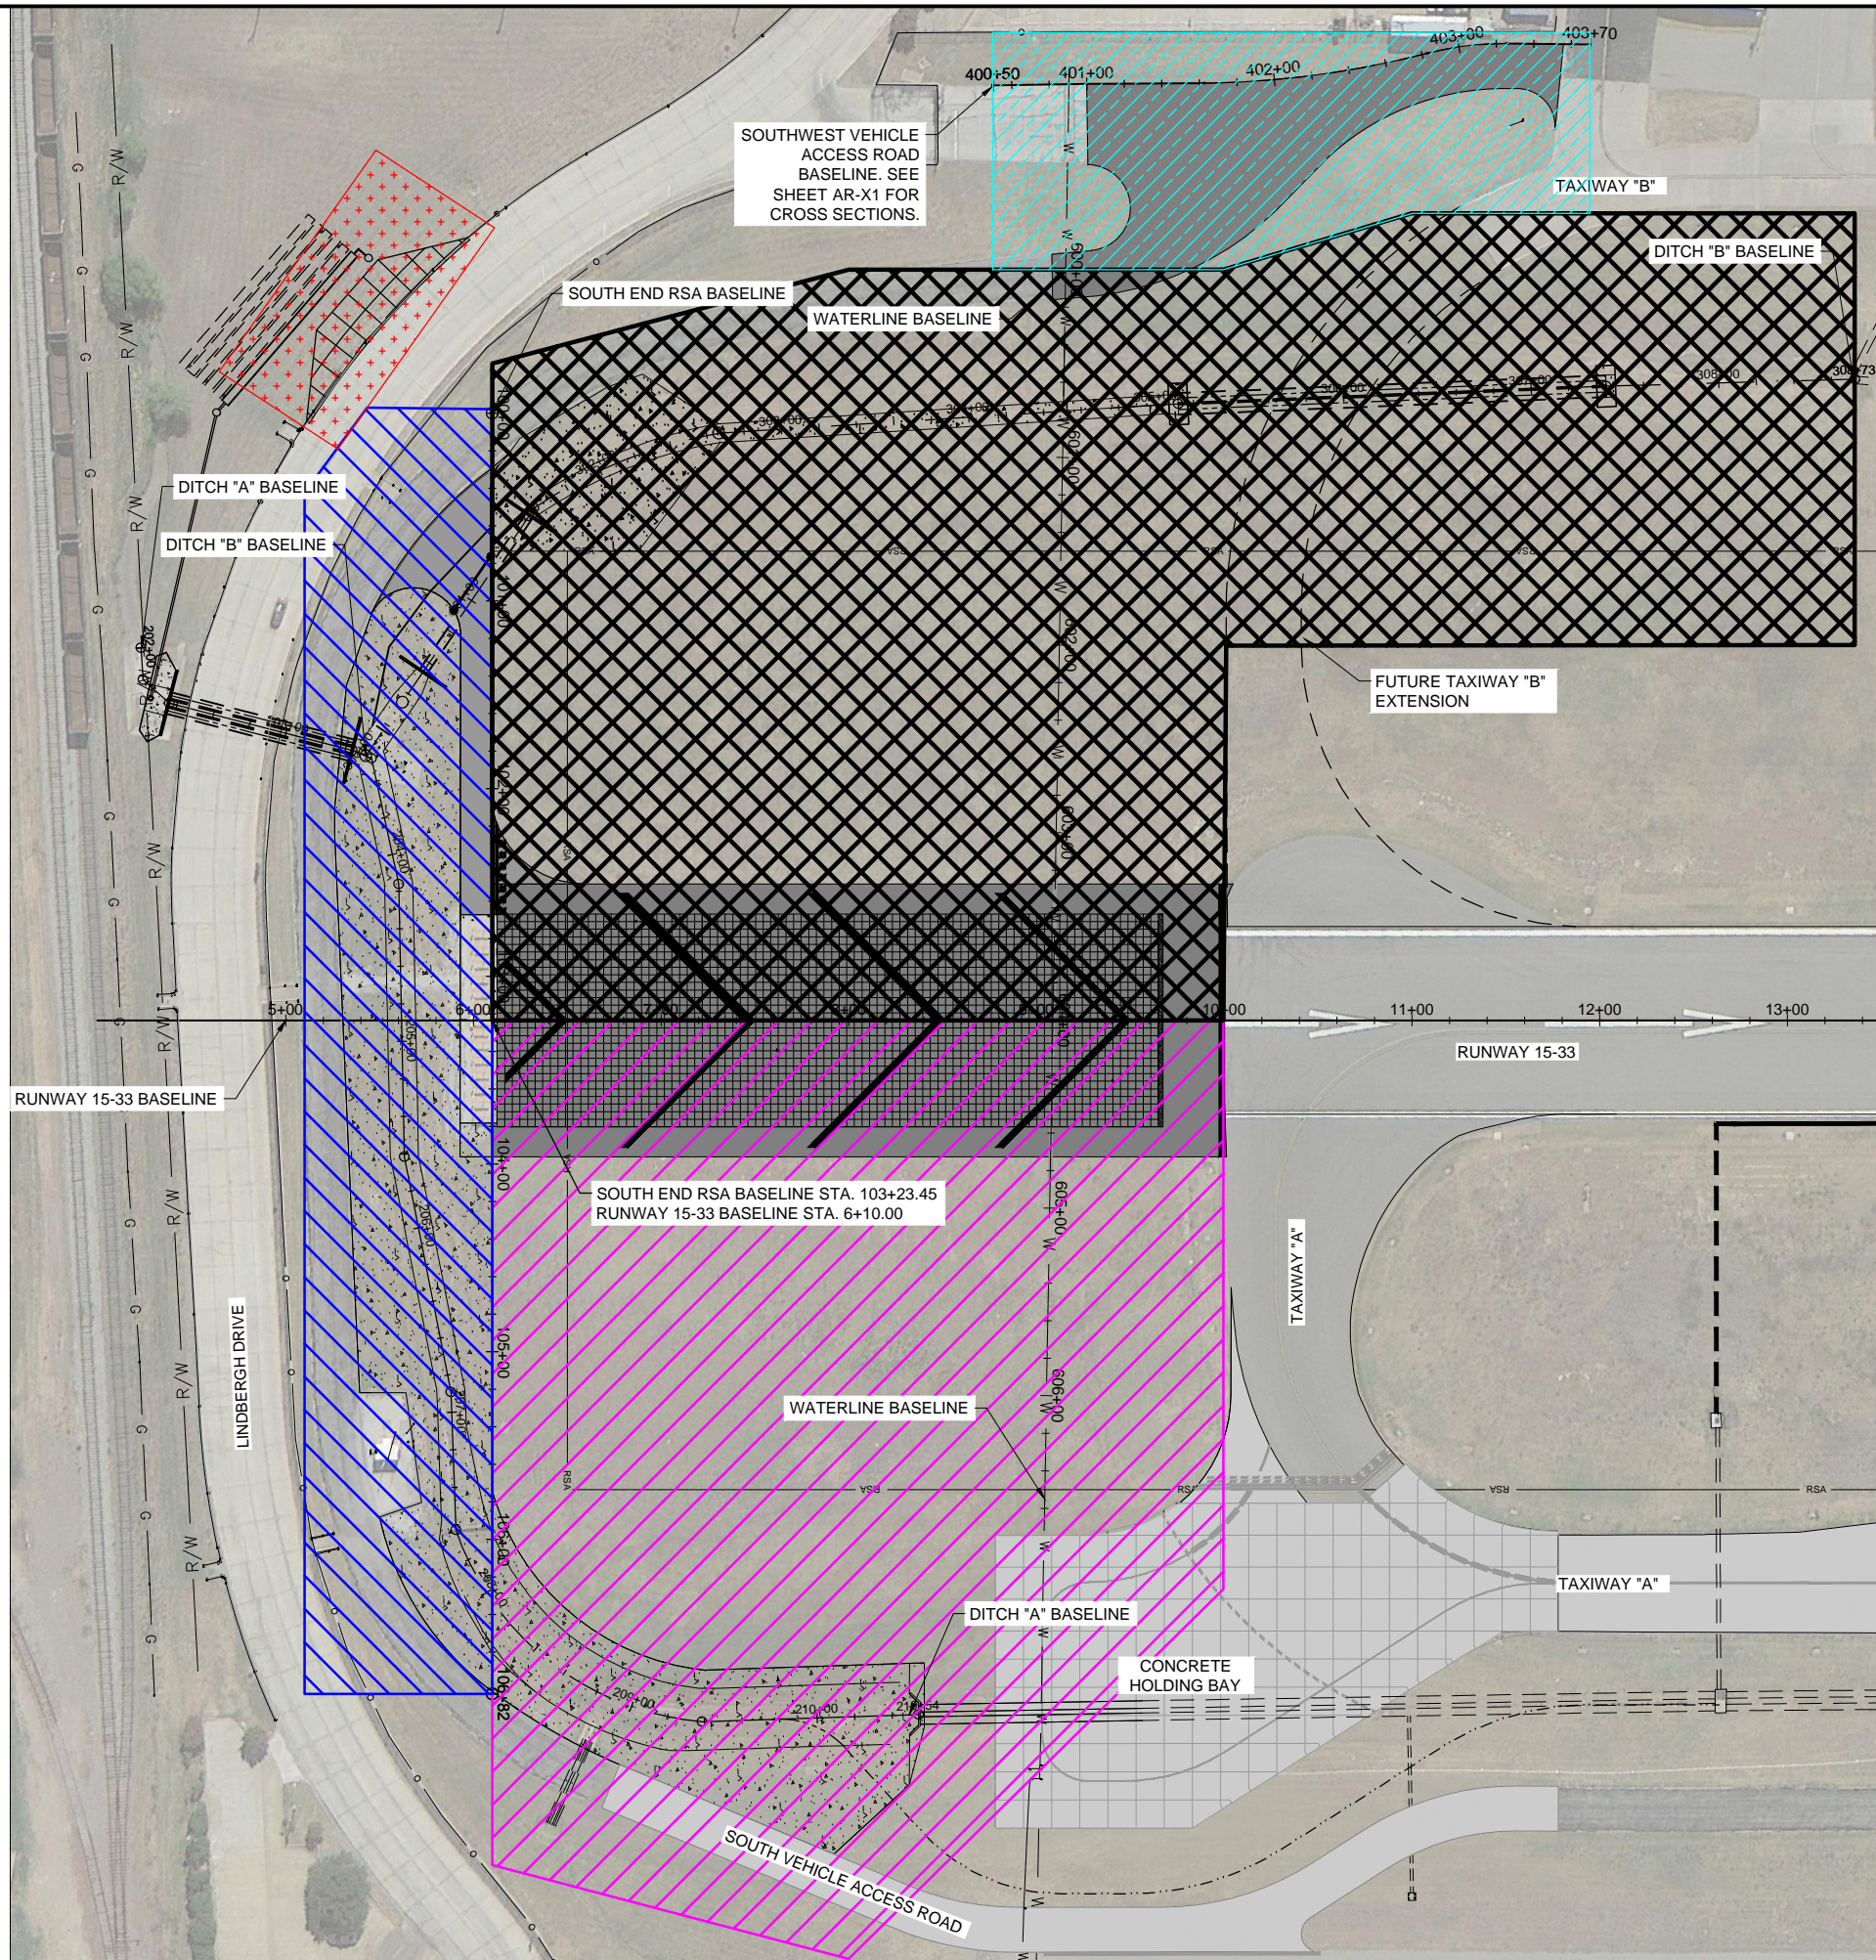

REGISTRATION NO.  
F-5713

RECORD DRAWINGS

03/10/2015

REV.	DATE	DESCRIPTION	BY



ADDISON AIRPORT

ADDISON, TEXAS

RUNWAY 33 RSA IMPROVEMENTS

CROSS SECTION OVERVIEW

JOB NO.: 13081100  
 DATE: NOV. , 2013  
 DESIGNED BY: BCB  
 DRAWN BY: BCB

BAR IS ONE INCH ON ORIGINAL DRAWING  
 0 1"  
 IF NOT ONE INCH ON THIS SHEET, ADJUST SCALES ACCORDINGLY.

DRAWING NUMBER  
CSO

SHEET NUMBER  
54