




File: I:\2014\14081101 - ads emas construction\Drawings\RECORD\ADS_EMAS_EAX1_EX.dwg Last Save: 10/15/2014 1:43 PM Last saved by: Mmccanally
 Last plotted by: Suarez, Javier Plot Style: AECmono.ctb Plot Scale: 1:1 Plot Date: 3/10/2015 5:01 PM Plotter used: DWG To PDF.pc3

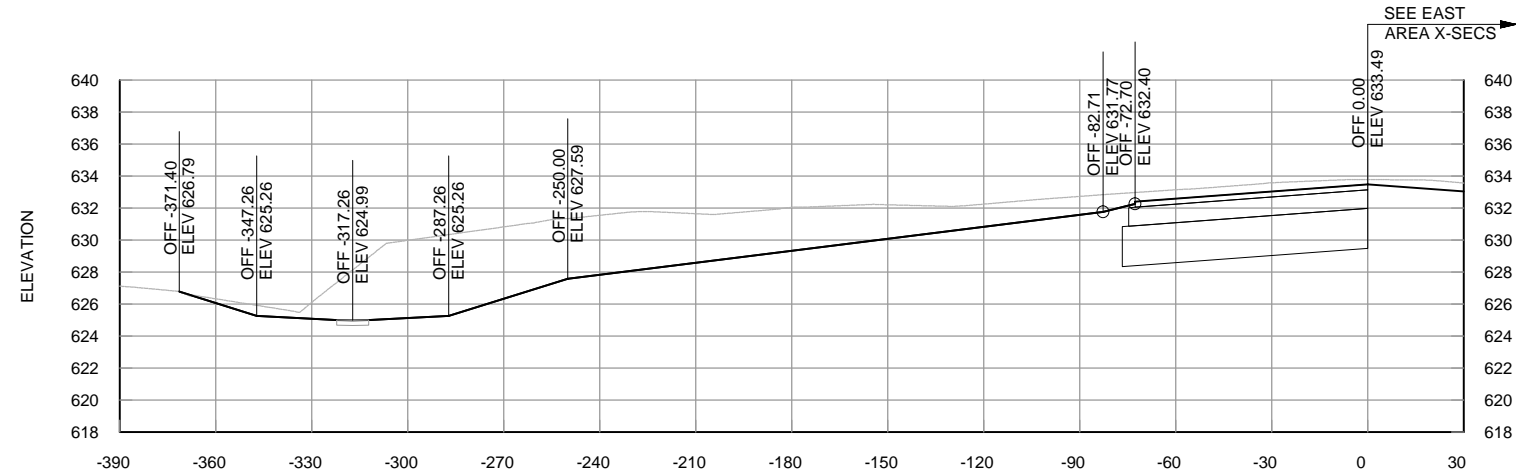


8+00

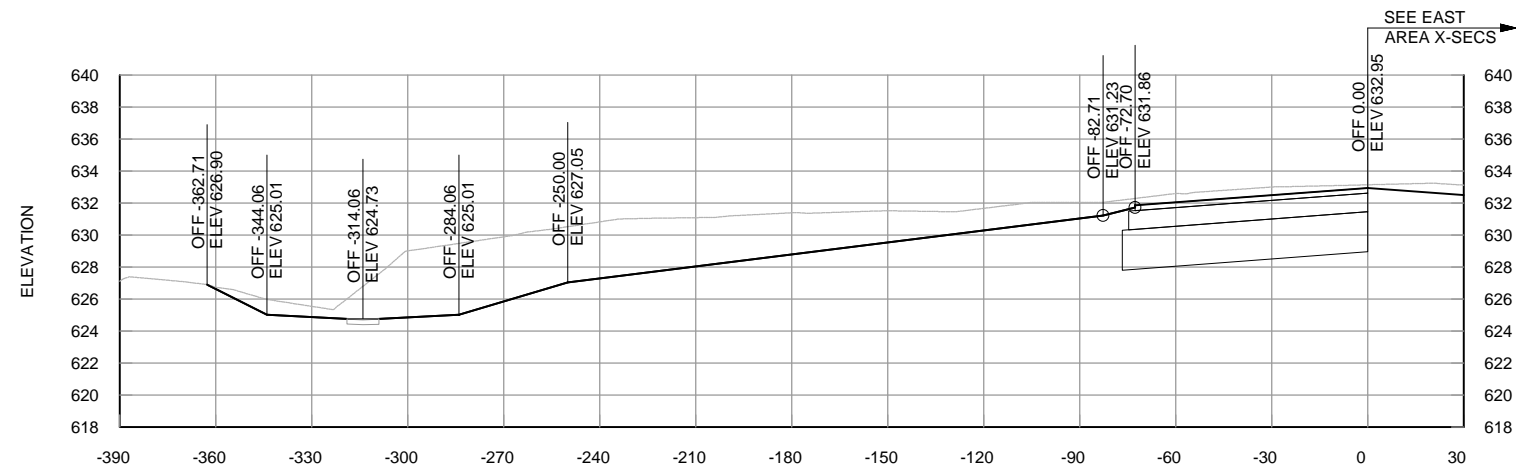

7+50

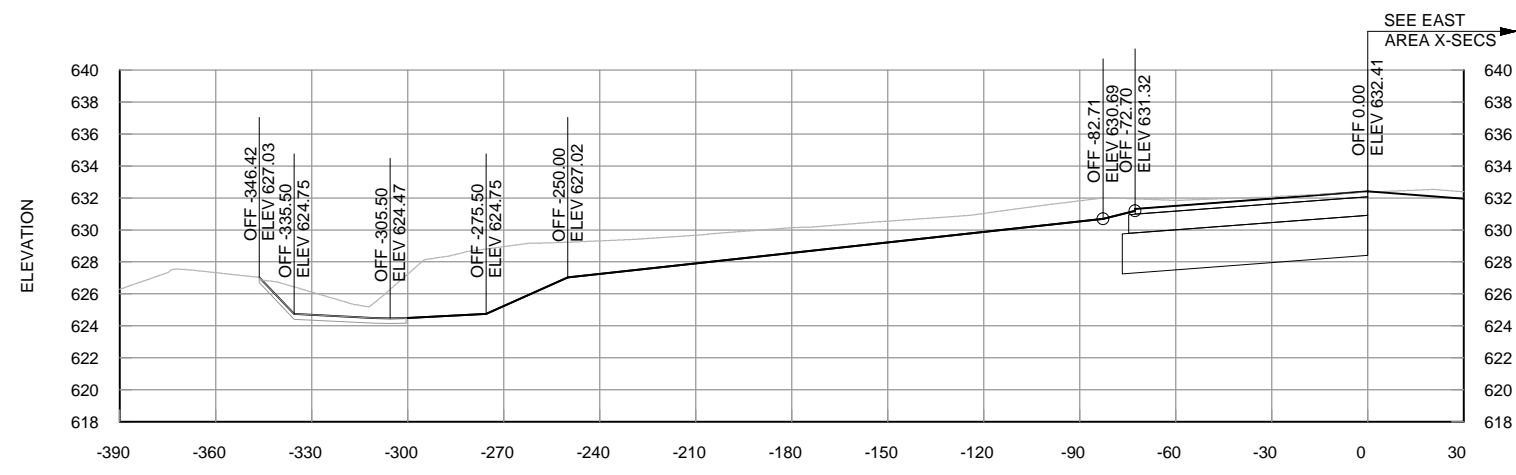

7+00

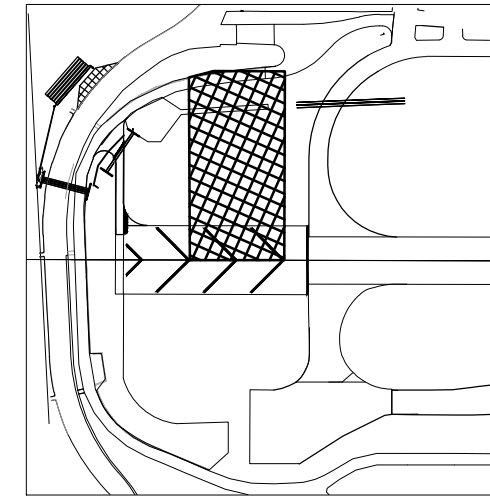

SITE MAP



REGISTRATION NO.
F-5713

RECORD DRAWINGS
03/10/2015

REV.	DATE	DESCRIPTION	BY



ADDISON AIRPORT
ADDISON, TEXAS

RUNWAY 33 RSA IMPROVEMENTS

WEST AREA CROSS SECTIONS II

JOB NO.: 13081100
DATE: NOV. , 2013
DESIGNED BY: BCB
DRAWN BY: BCB

BAR IS ONE INCH ON ORIGINAL DRAWING
IF NOT ONE INCH ON THIS SHEET, ADJUST SCALES ACCORDINGLY.

DRAWING NUMBER
WA-X2

SHEET NUMBER
60