
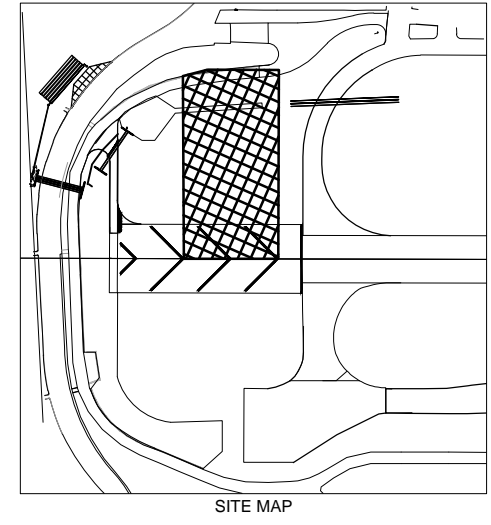


File: I:\2014\14081101 - ads emas construction\Drawings\RECORD\ADS_EMAS_EAX1_EX.dwg, Last Save: 10/15/2014 1:43 PM, Last saved by: Mmiccally
 Last Plotted by: Suarez, Javier, Plot Style: AECmono.ctb, Plot Scale: 1:1, Plot Date: 3/10/2015 5:01 PM, Plotter used: DWG To PDF, v3

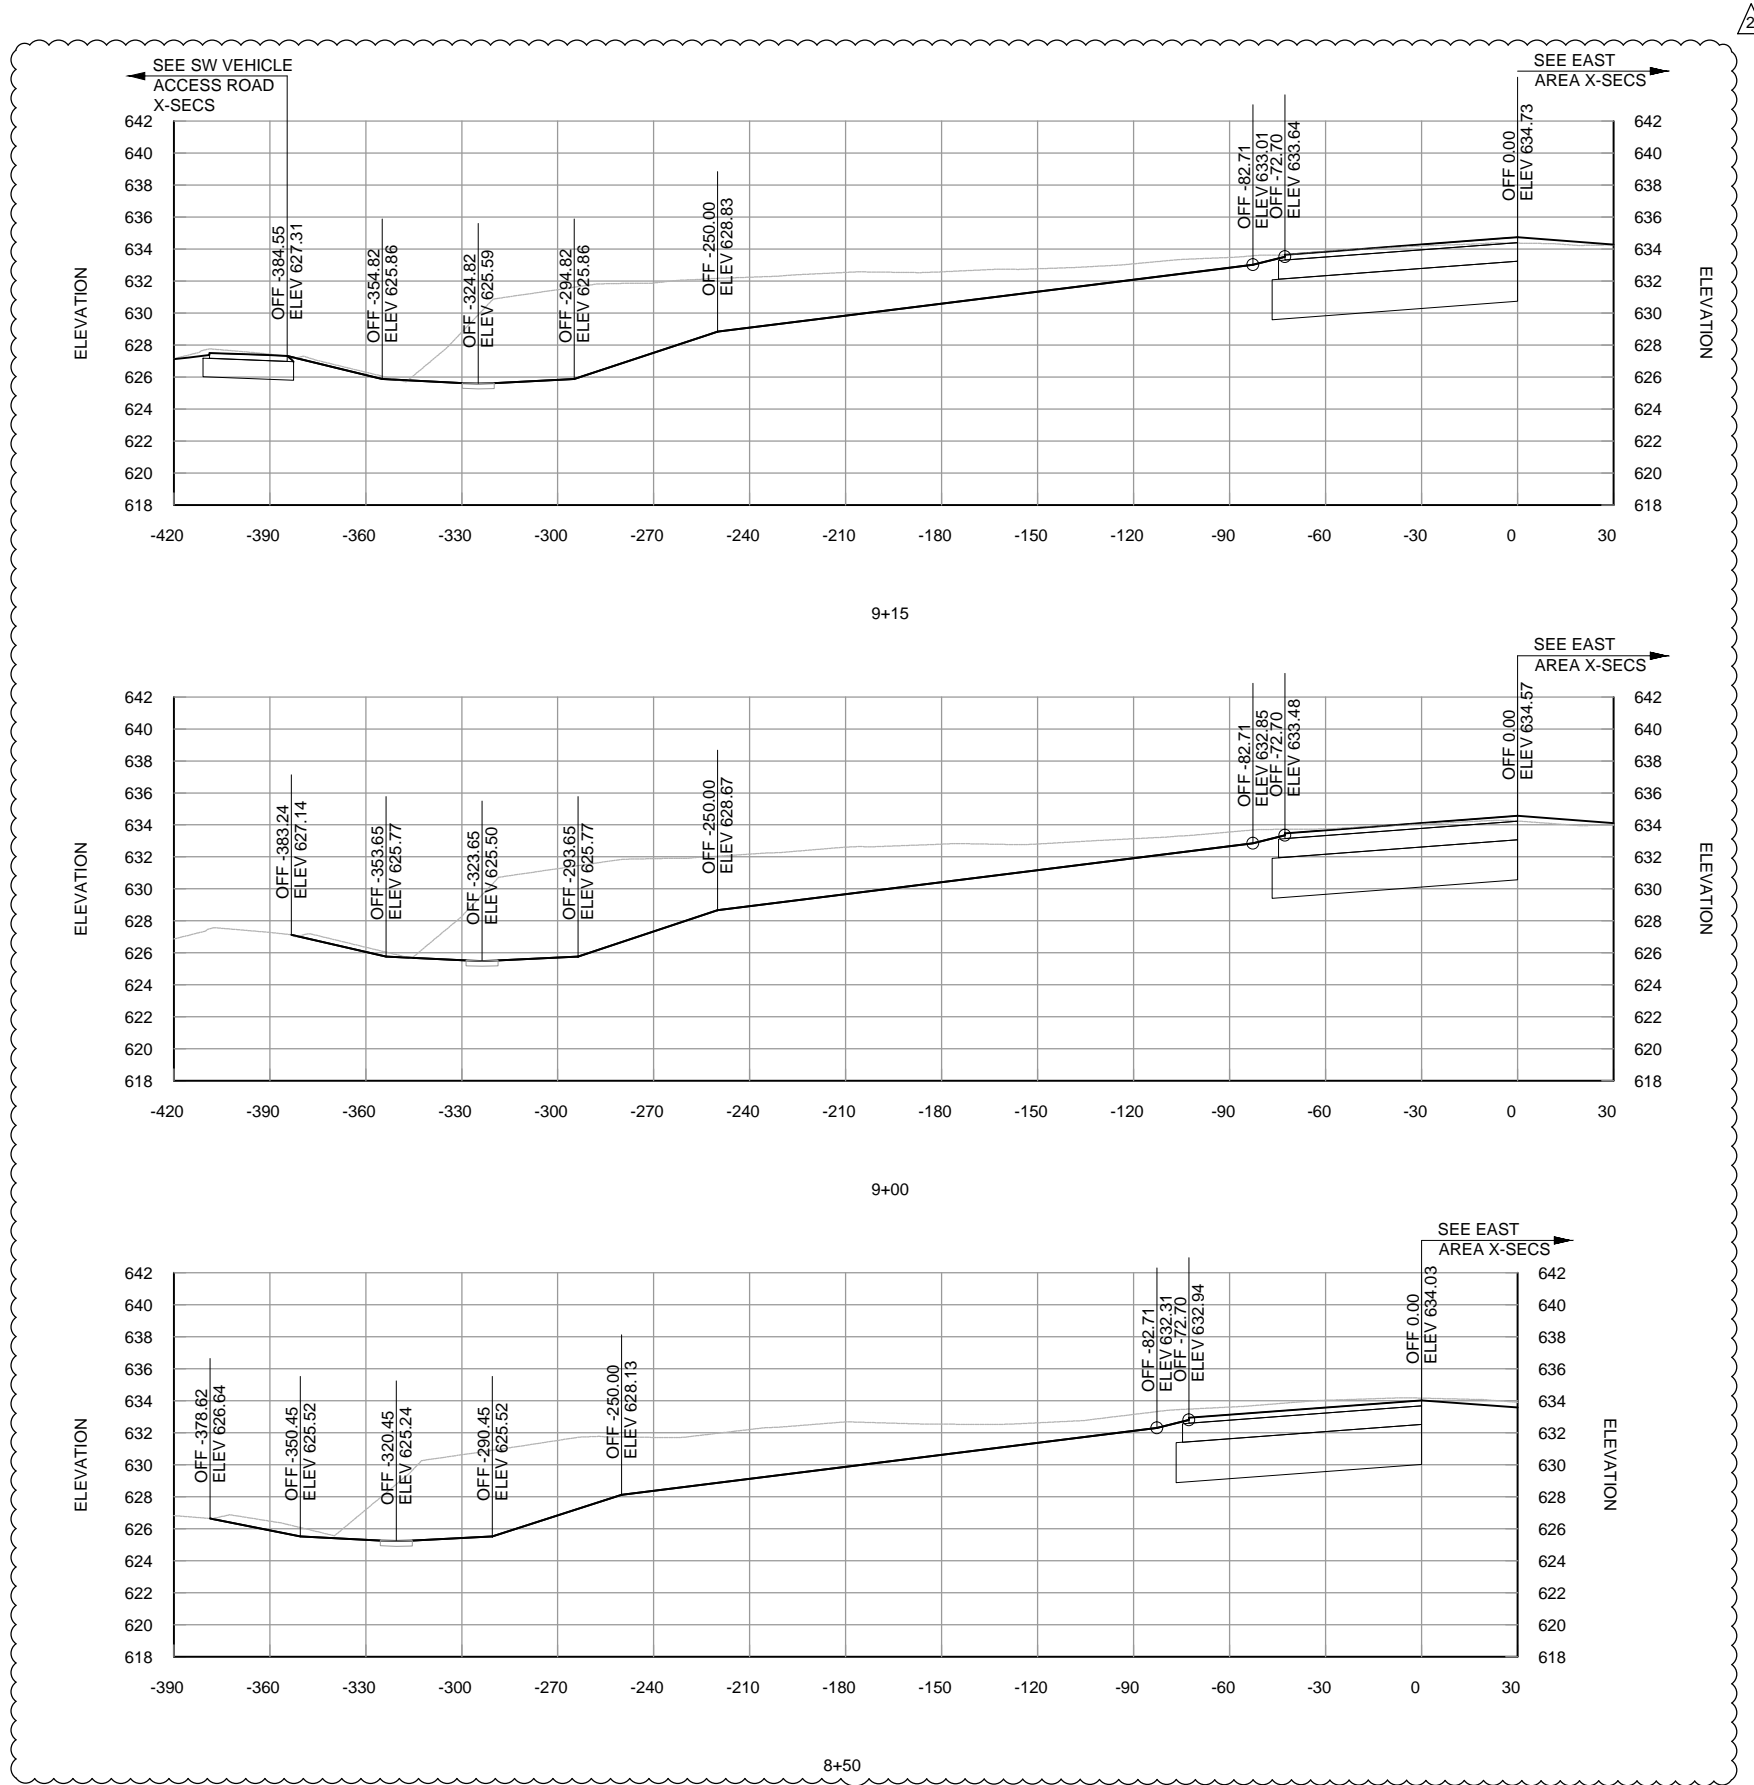

REGISTRATION NO.
F-5713

RECORD DRAWINGS
03/10/2015

REV.	DATE	DESCRIPTION	BY

Addison Airport
 ADDISON, TEXAS
RUNWAY 33 RSA IMPROVEMENTS

WEST AREA CROSS SECTIONS III

JOB NO.: 13081100
 DATE: NOV, 2013
 DESIGNED BY: BCB
 DRAWN BY: BCB

BAR IS ONE INCH ON ORIGINAL DRAWING
 IF NOT ONE INCH ON THIS SHEET, ADJUST SCALES ACCORDINGLY.

DRAWING NUMBER
WA-X3

SHEET NUMBER
61