
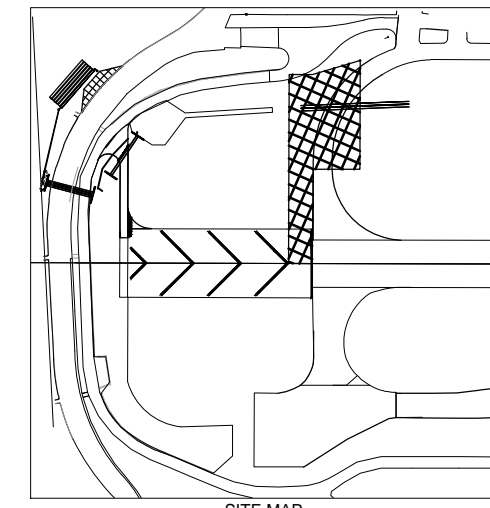


File: I:\2014\14081101 - ads emas construction\Drawings\RECORD\ADS\_EMAS\_EAX1\_EX.dwg Last Save: 10/15/2014 1:43 PM Last saved by: Mmccanally  
 Last plotted by: Suarez, Javier Plot Style: AECmono.ctb Plot Scale: 1:1 Plot Date: 3/10/2015 5:02 PM Plotter used: DWG To PDF.pc3

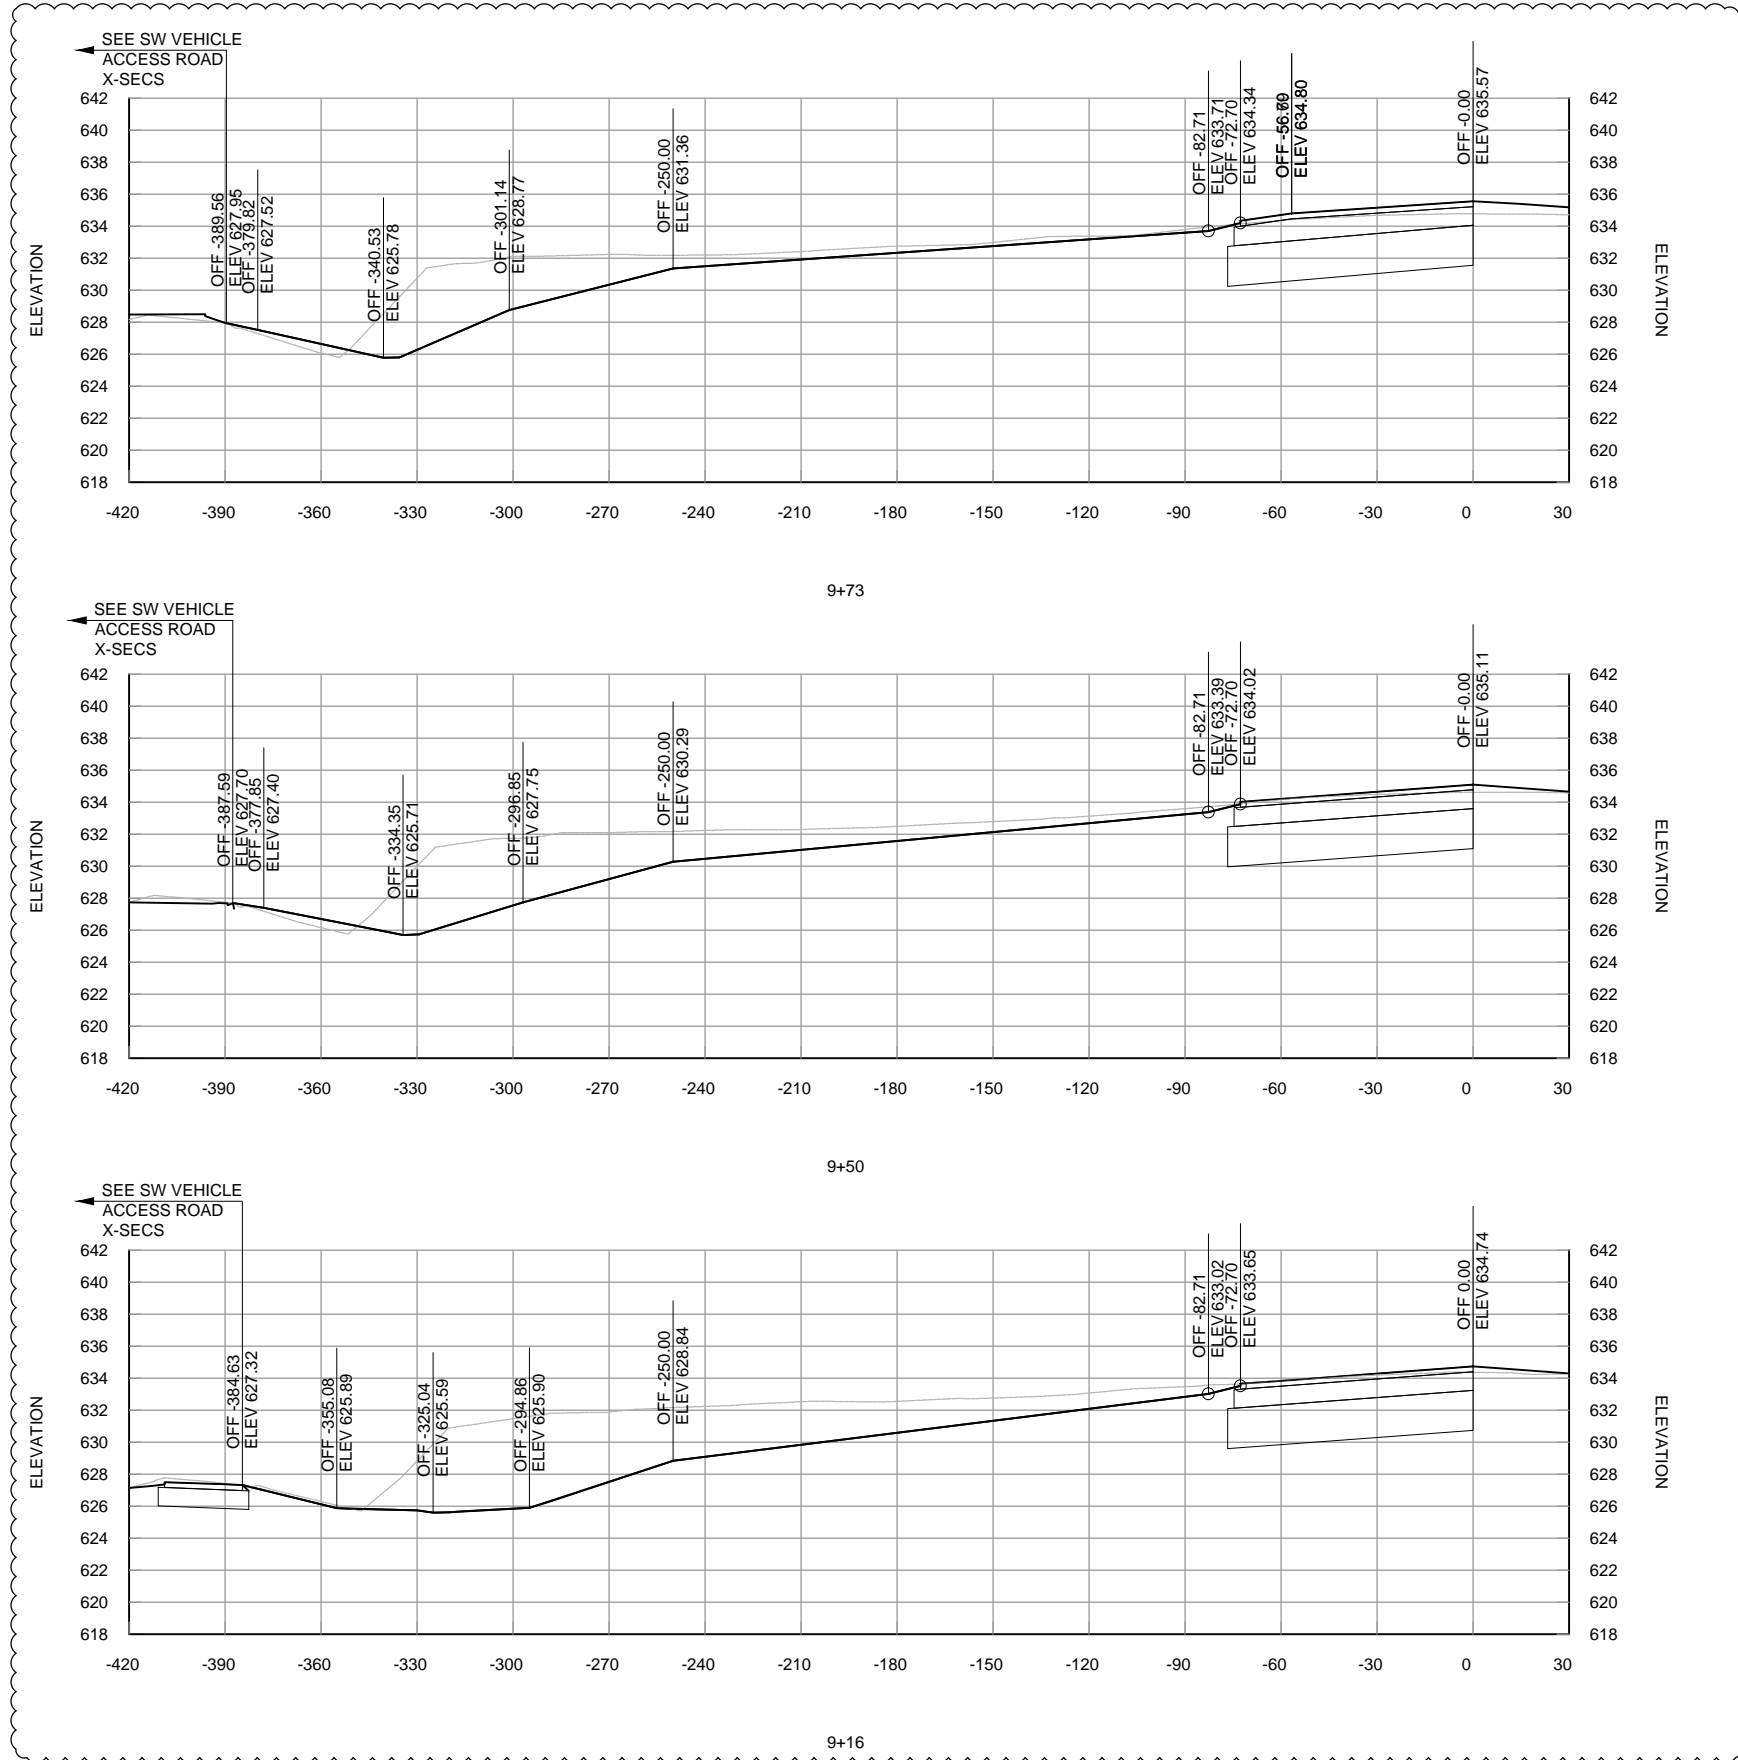

REGISTRATION NO.  
F-5713

**RECORD DRAWINGS**  
03/10/2015

REV.	DATE	DESCRIPTION	BY

**Addison Airport**  
ADDISON, TEXAS  
RUNWAY 33 RSA IMPROVEMENTS

WEST AREA CROSS SECTIONS IV

JOB NO.: 13081100  
DATE: NOV. , 2013  
DESIGNED BY: BCB  
DRAWN BY: BCB

BAR IS ONE INCH ON ORIGINAL DRAWING  
IF NOT ONE INCH ON THIS SHEET, ADJUST SCALES ACCORDINGLY.

DRAWING NUMBER  
**WA-X4**  
SHEET NUMBER  
**62**