

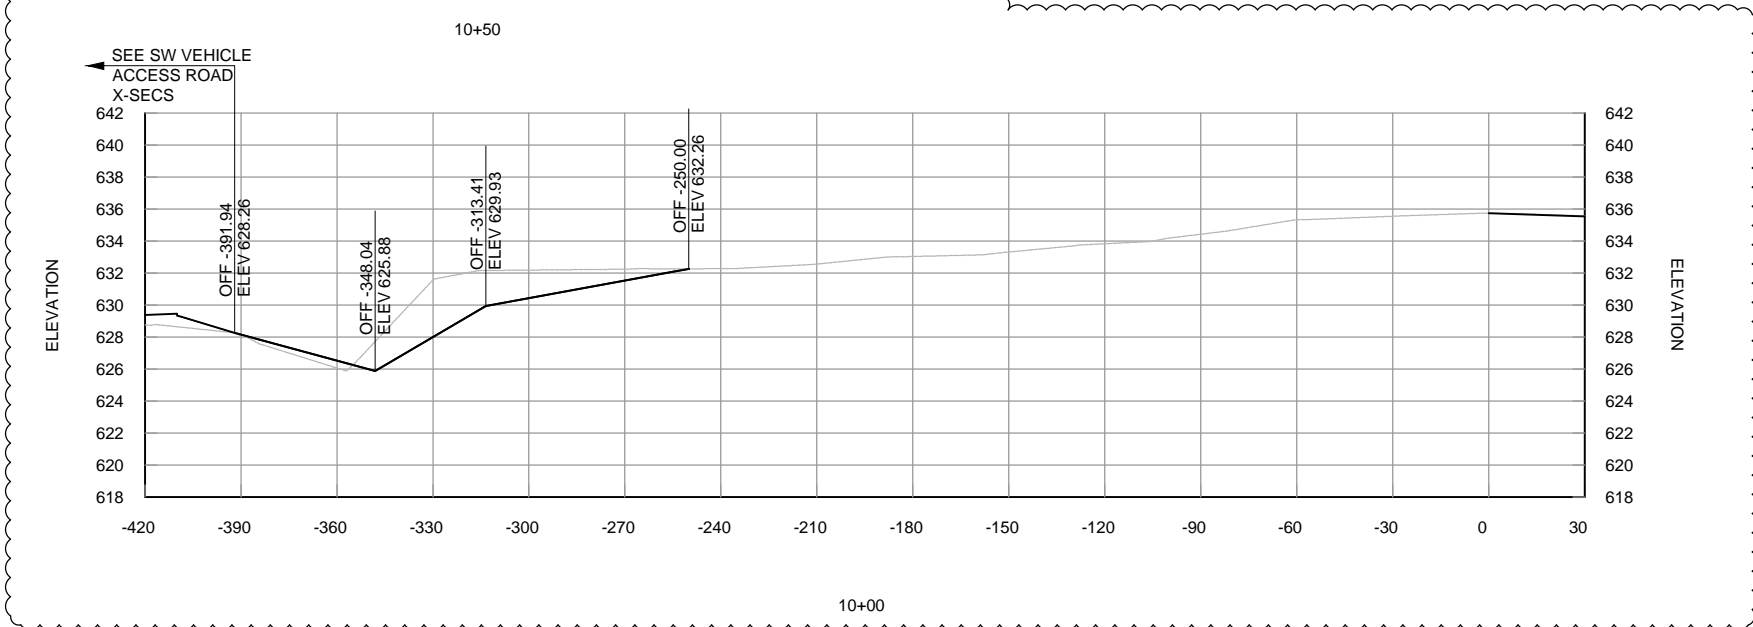


File: I:\2014\14081101 - ads emas construction\Drawings\RECORD\ADS\_EMAS\_EAX1\_EX.dwg, Last Save: 10/15/2014 1:43 PM, Last saved by: Mmiccally  
 Last plotted by: Suarez, Javier, Plot Style: AECmono.ctb, Plot Scale: 1:1, Plot Date: 3/10/2015 5:02 PM, Plotter used: DWG To PDF.pc3

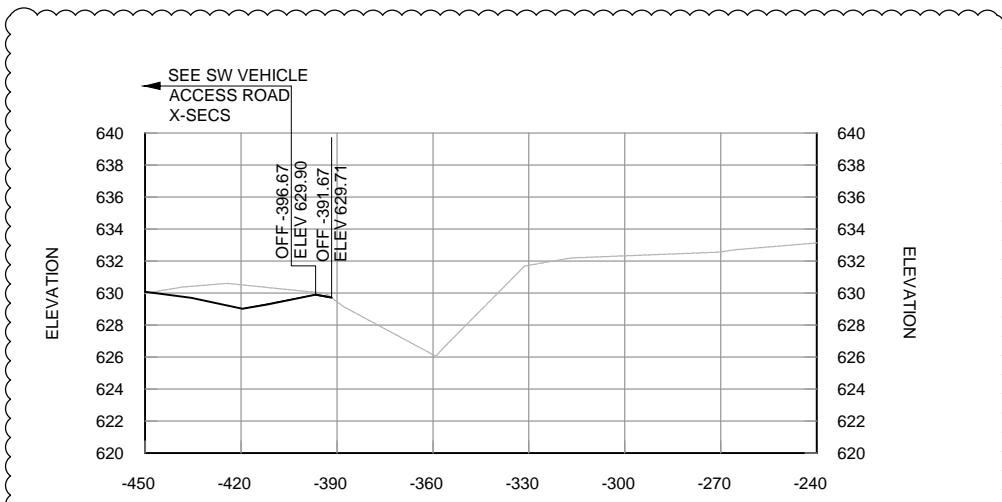

2

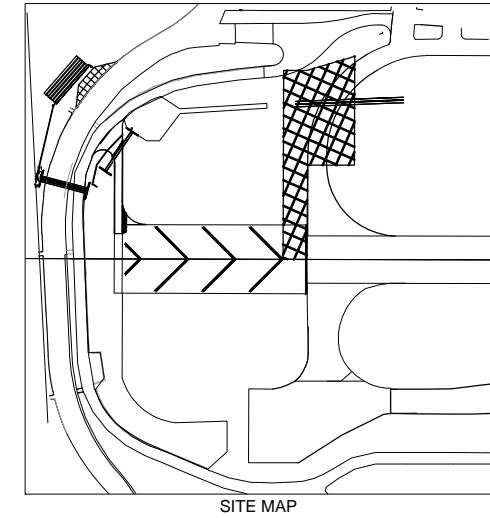

REGISTRATION NO.  
F-5713

**RECORD DRAWINGS**  
03/10/2015

REV.	DATE	DESCRIPTION	BY

**Addison Airport**  
 ADDISON AIRPORT  
 ADDISON, TEXAS  
 RUNWAY 33 RSA IMPROVEMENTS

WEST AREA CROSS SECTIONS V

JOB NO.: 13081100  
 DATE: NOV. , 2013  
 DESIGNED BY: BCB  
 DRAWN BY: BCB

BAR IS ONE INCH ON ORIGINAL DRAWING  
 0 1"  
 IF NOT ONE INCH ON THIS SHEET, ADJUST SCALES ACCORDINGLY.

DRAWING NUMBER  
**WA-X5**

SHEET NUMBER **63**