



REGISTRATION NO.  
F-5713

RECORD DRAWINGS  
03/10/2015

REV.	DATE	DESCRIPTION	BY



ADDISON AIRPORT  
ADDISON, TEXAS

RUNWAY 33 RSA IMPROVEMENTS


SOUTH AREA CROSS SECTIONS I

JOB NO.: 13081100  
DATE: NOV. , 2013  
DESIGNED BY: BCB  
DRAWN BY: BCB


BAR IS ONE INCH ON ORIGINAL DRAWING  
IF NOT ONE INCH ON THIS SHEET, ADJUST SCALES ACCORDINGLY.

DRAWING NUMBER  
SA-X1


SHEET NUMBER  
65

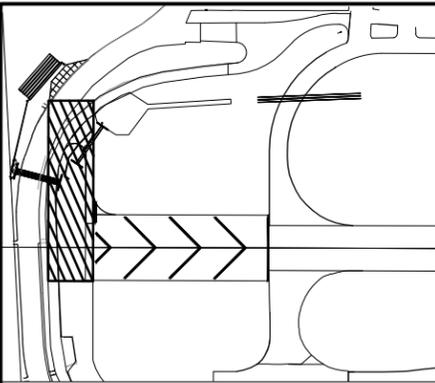


SITE MAP

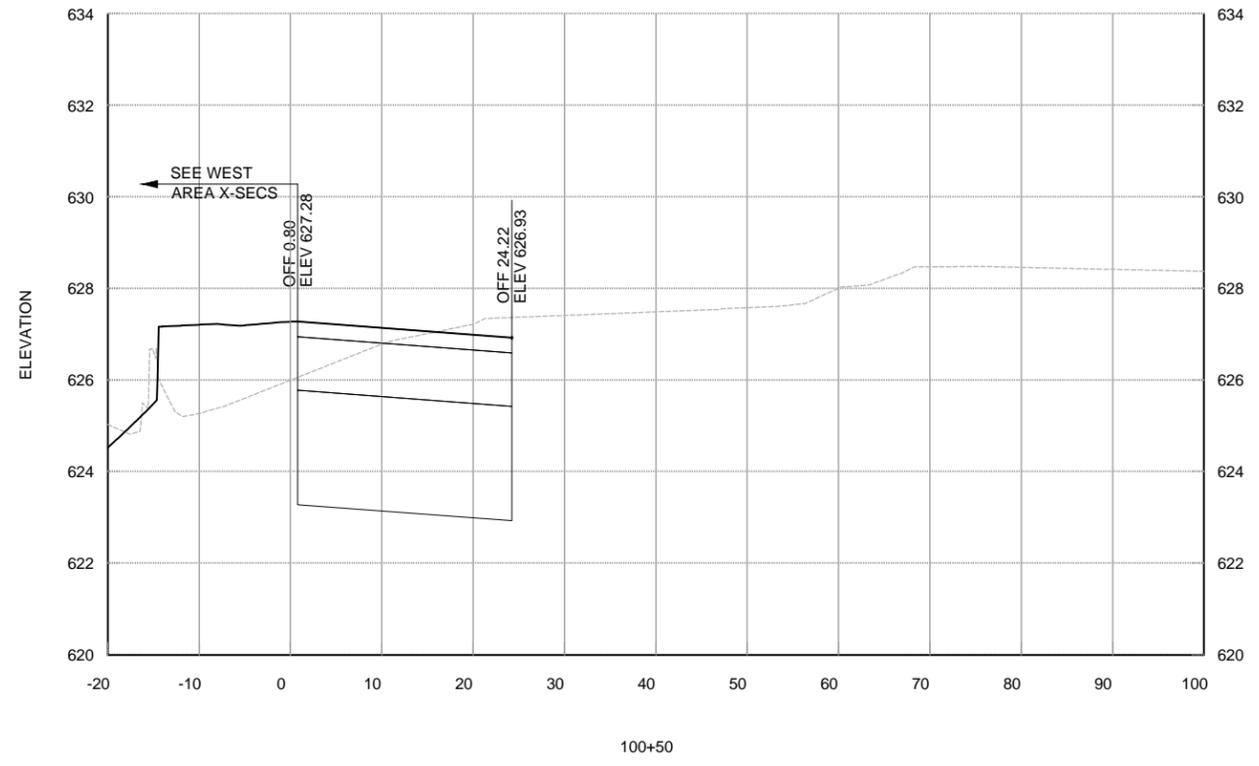


100+50

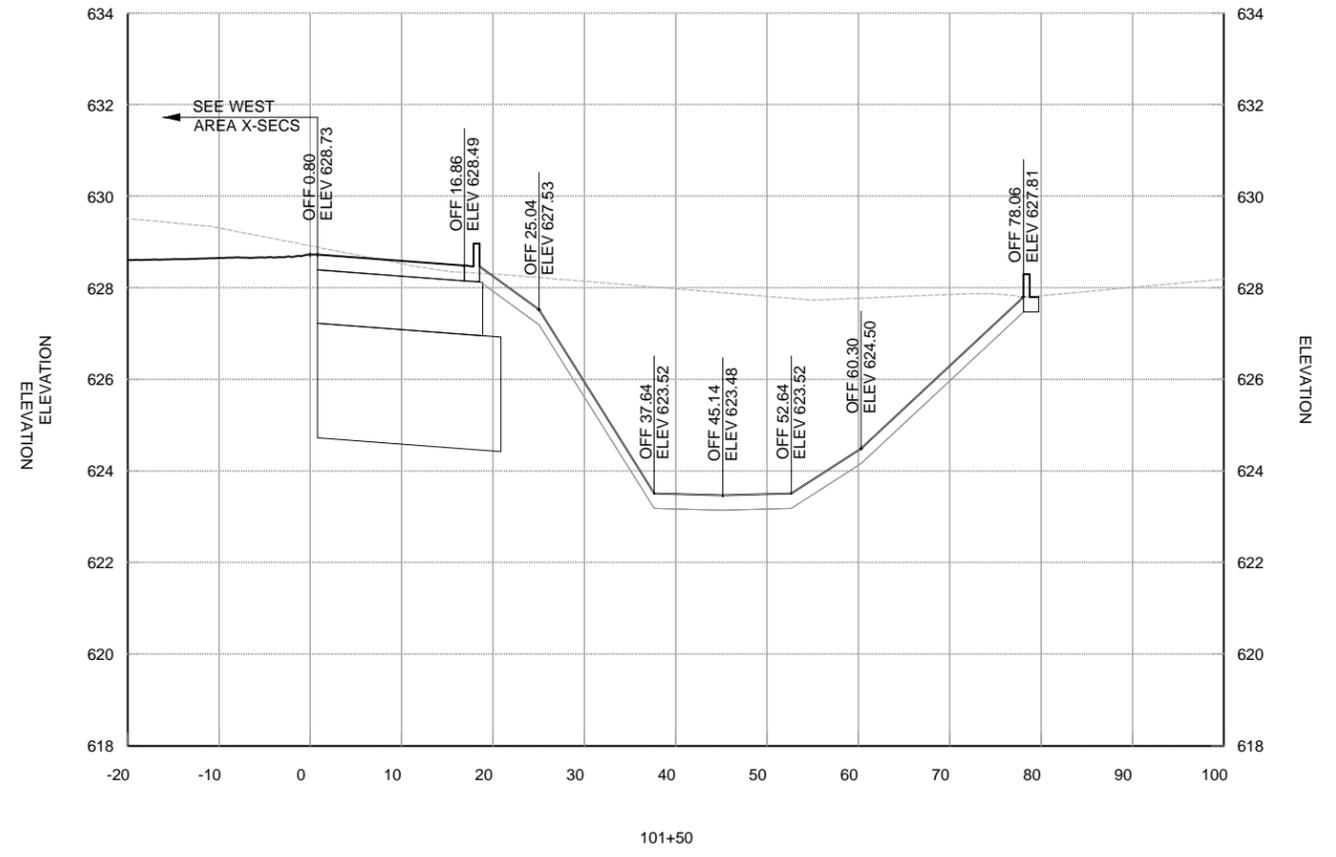

101+50

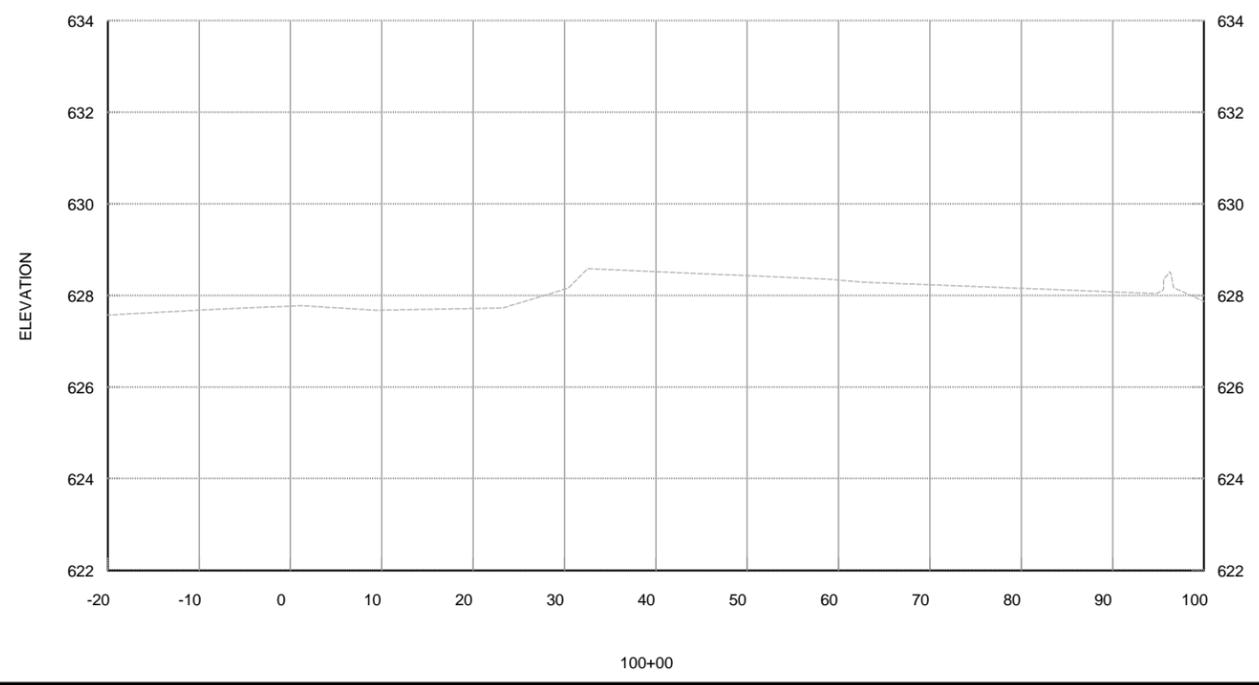

100+00

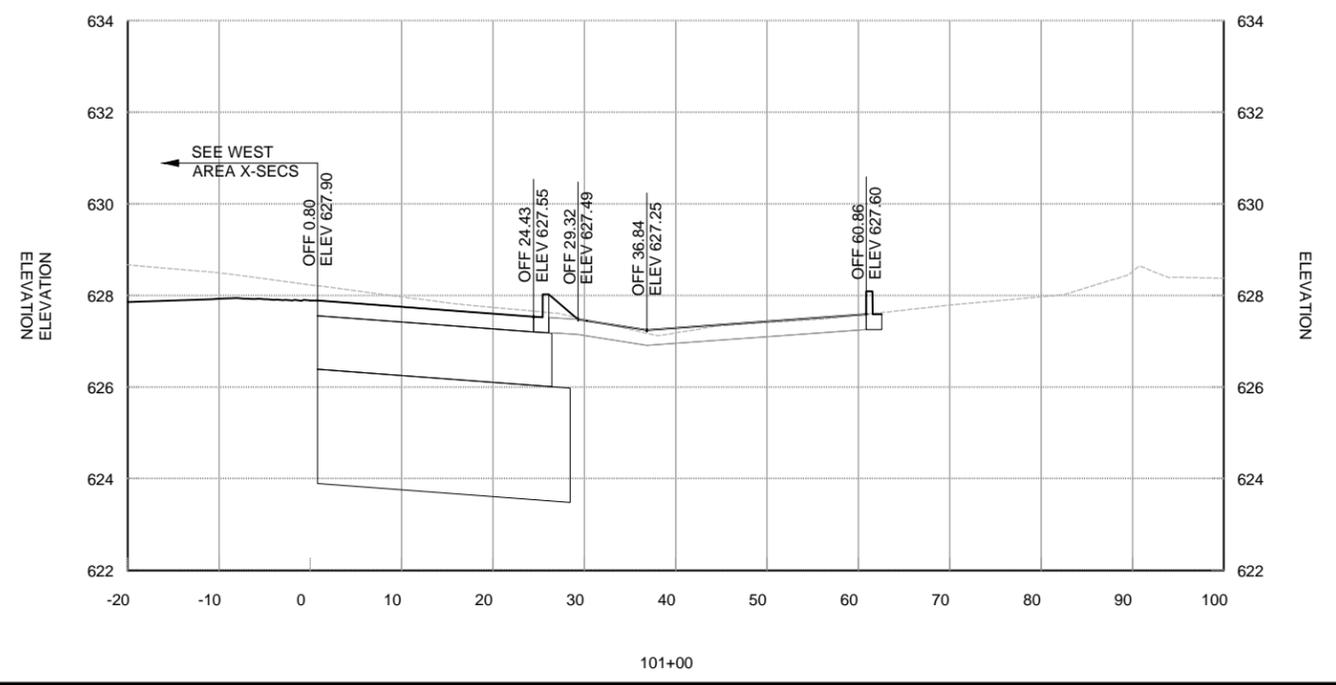

101+00

File: I:\2014\14081101 - ads emas construction\Drawings\RECORD\ADS\_EMAS\_EAX1\_EX.dwg Last Save: 10/15/2014 1:43 PM Last saved by: Mmiccally  
Last plotted by: Suarez, Javier Plot Style: AECmono.ctb Plot Date: 3/10/2015 5:02 PM Plotter used: DWG To PDF.pc3