




File: I:\2014\14081101 - ads emas construction\Drawings\RECORD\ADS_EMAS_EAX1_EX.dwg Last Save: 10/15/2014 1:43 PM Last saved by: Mmiccally
 Last plotted by: Suarez, Javier Plot Style: AECmono.ctb Plot Date: 3/10/2015 5:02 PM Plotter used: DWG To PDF.pc3

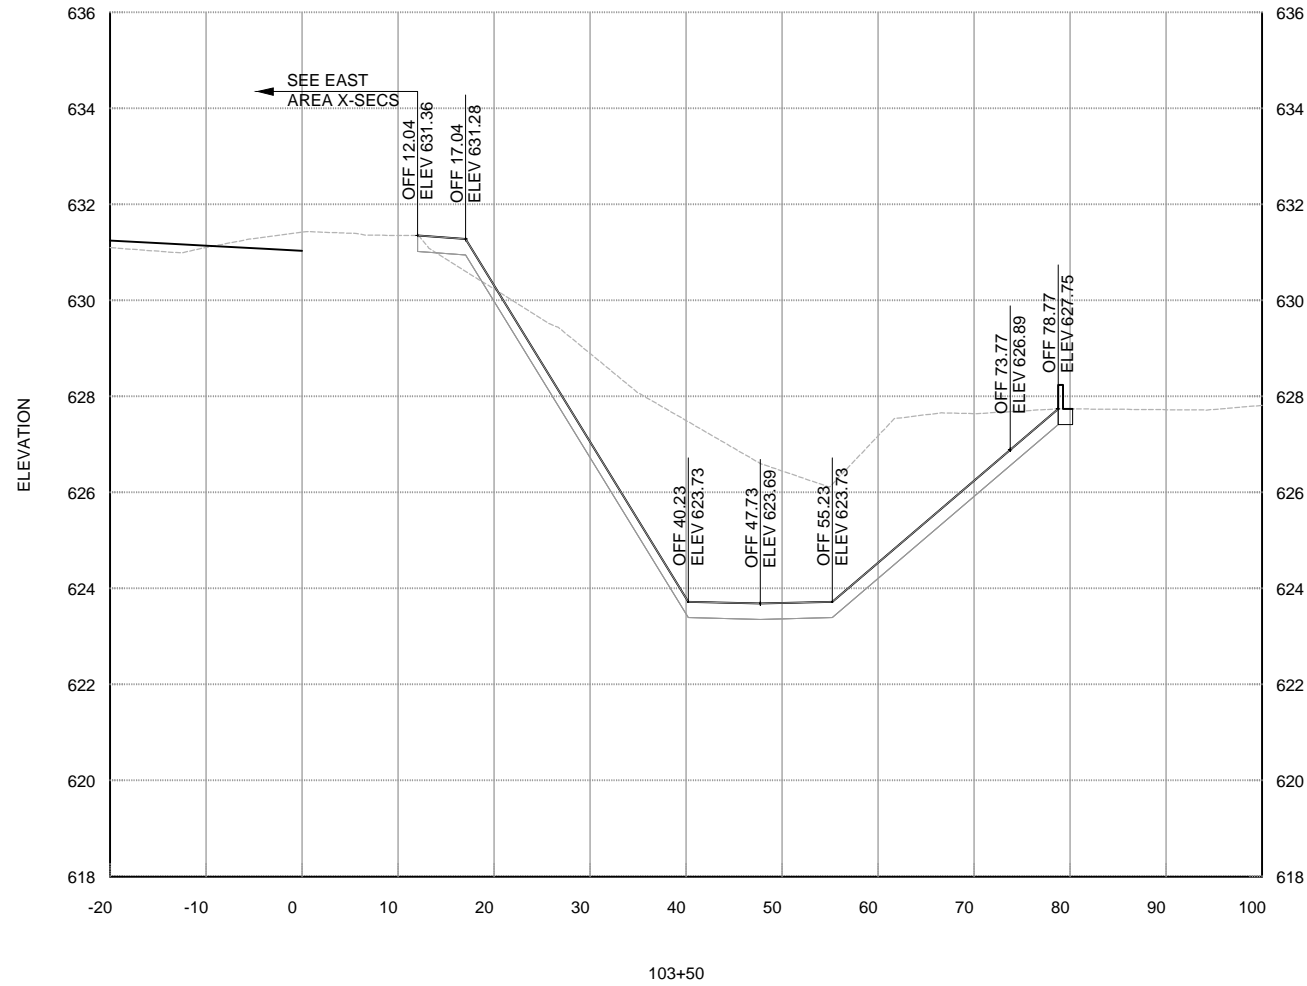

103+50

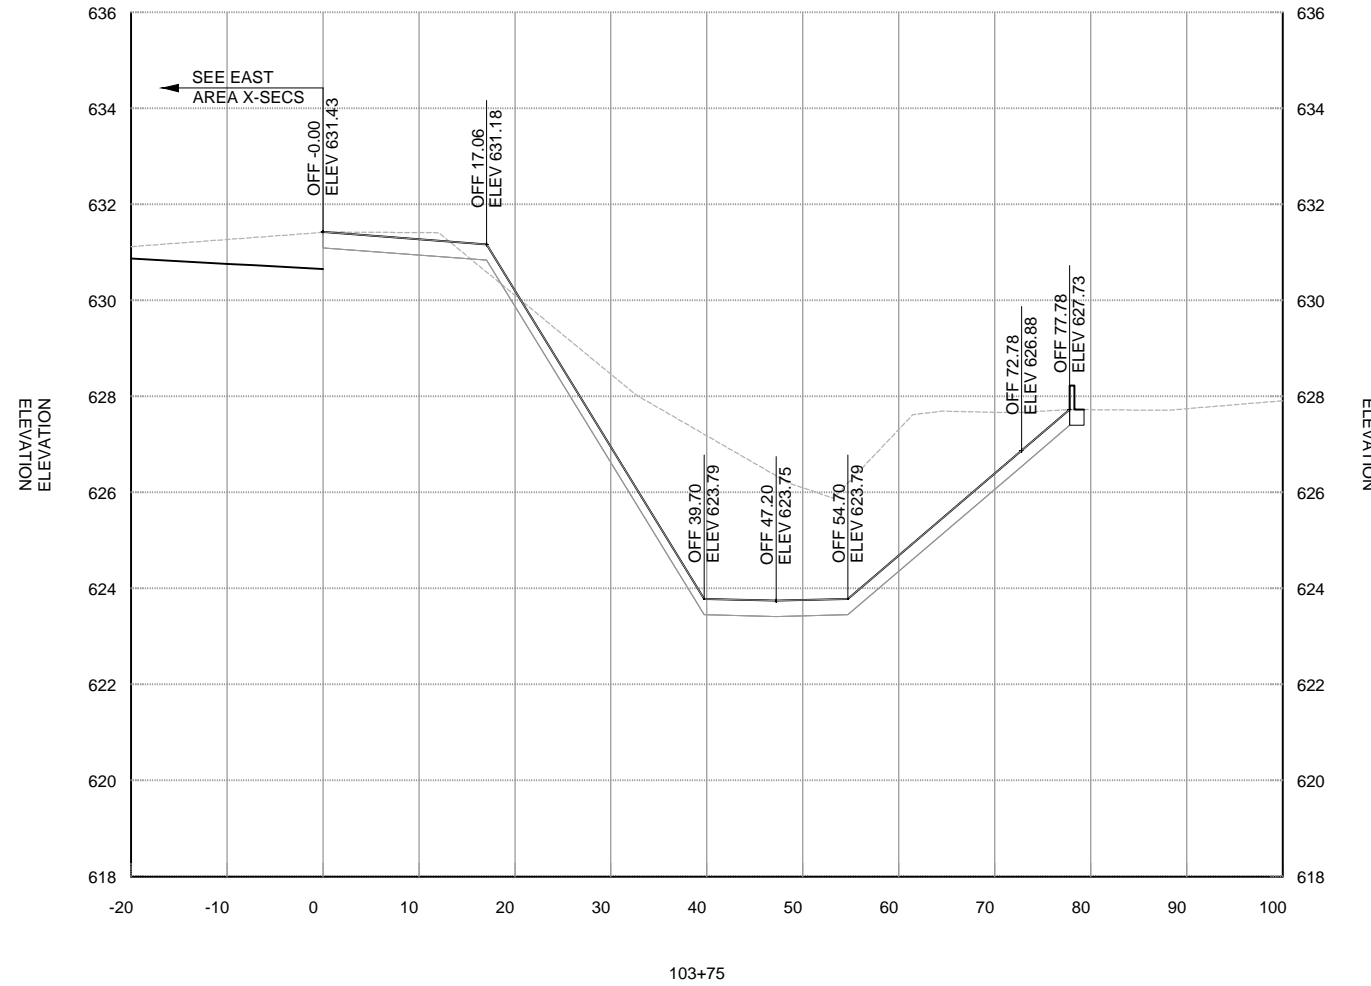

103+75

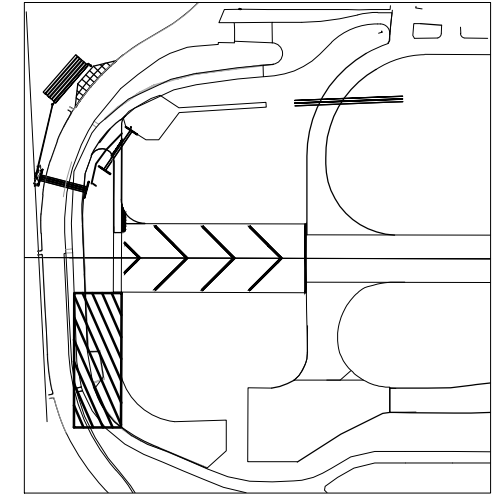

SITE MAP



REGISTRATION NO.
F-5713

RECORD DRAWINGS
03/10/2015

REV.	DATE	DESCRIPTION	BY



ADDISON AIRPORT
ADDISON, TEXAS

RUNWAY 33 RSA IMPROVEMENTS

SOUTH AREA CROSS SECTIONS IV

JOB NO.: 13081100
DATE: NOV, 2013
DESIGNED BY: BCB
DRAWN BY: BCB

BAR IS ONE INCH ON ORIGINAL DRAWING
IF NOT ONE INCH ON THIS SHEET, ADJUST SCALES ACCORDINGLY.

DRAWING NUMBER
SA-X4

SHEET NUMBER
68