
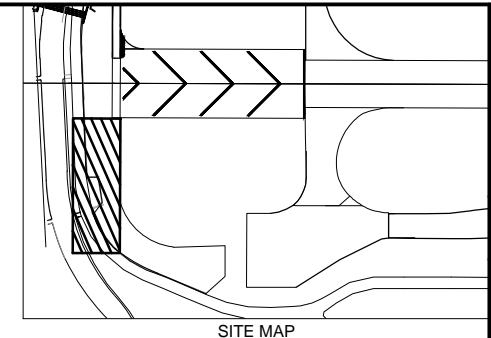
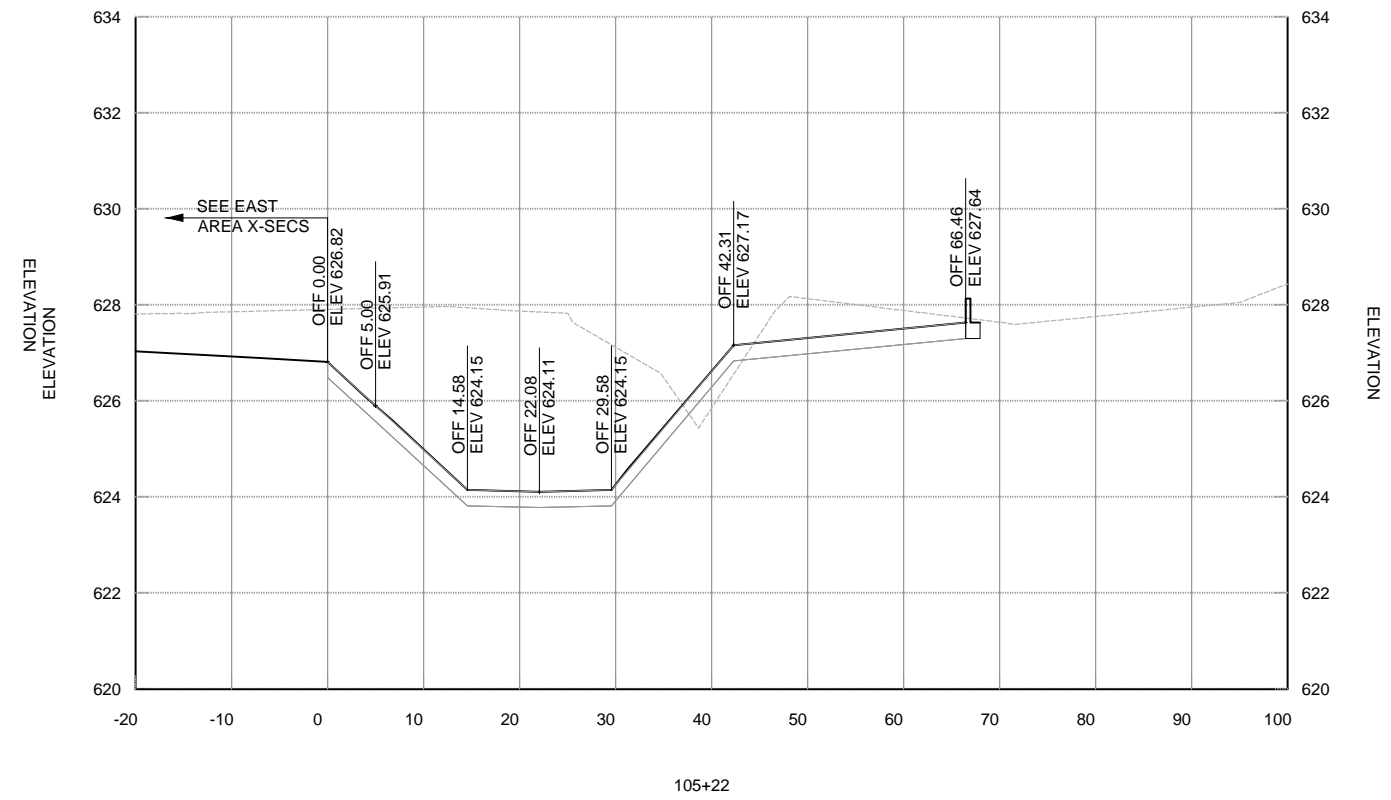
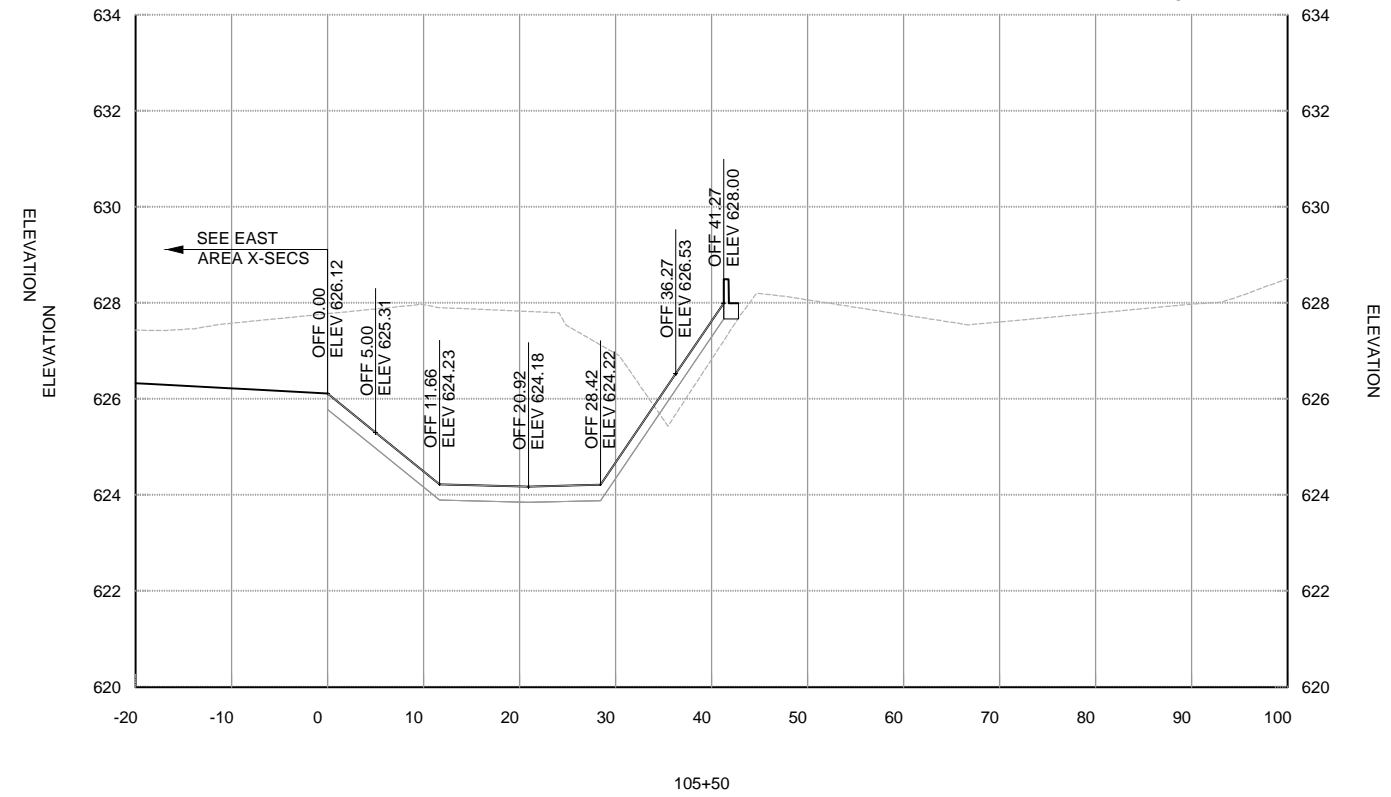
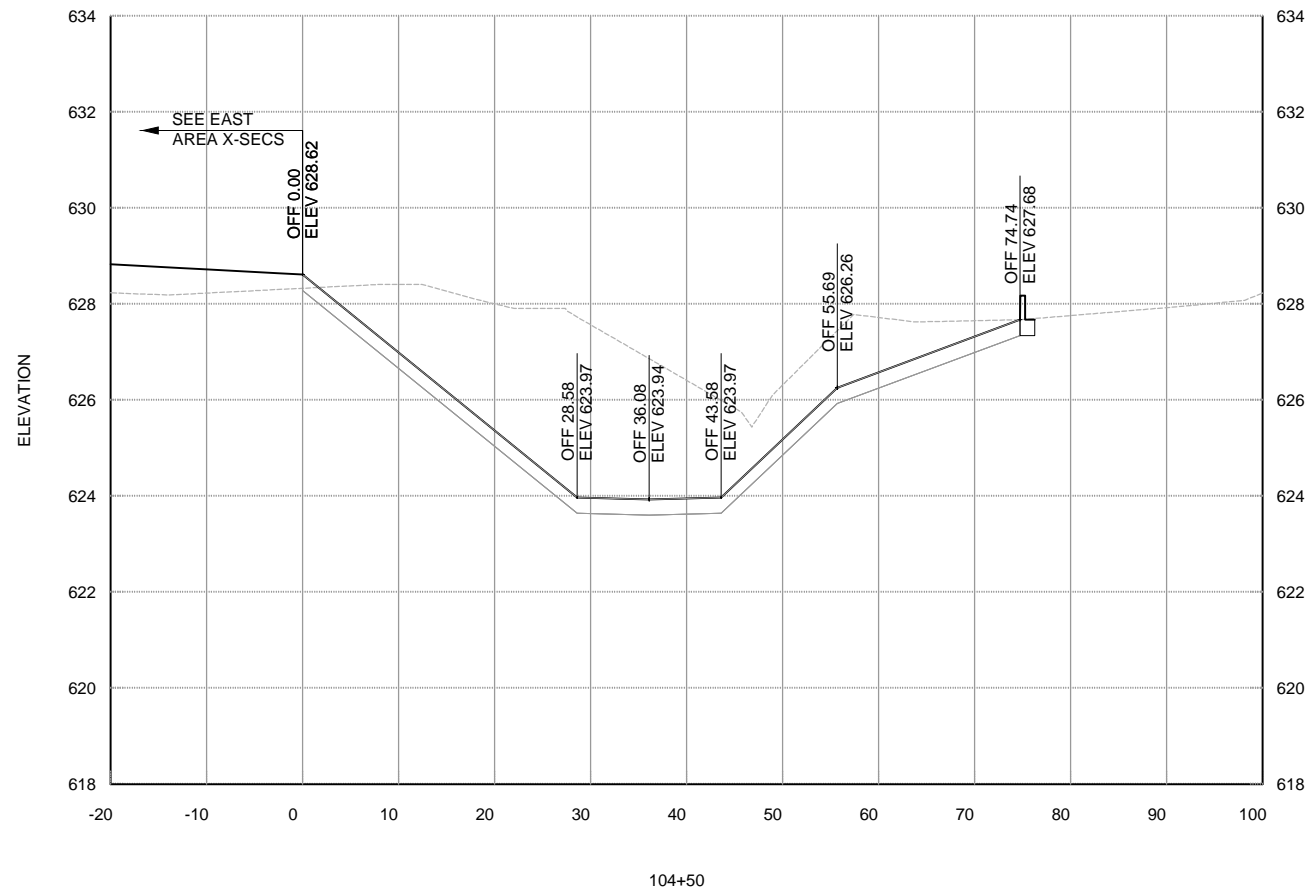


File: I:\2014\14081101 - ads emas construction\Drawings\RECORD\ADS\_EMAS\_EAX1\_EX.dwg, Last Save: 10/15/2014 1:43 PM, Last saved by: Mmiccally  
 Last plotted by: Suarez, Javier, Plot Style: AECmono.ctb, Plot Date: 3/10/2015 6:03 PM, Plotter used: DWG To PDF.pc3

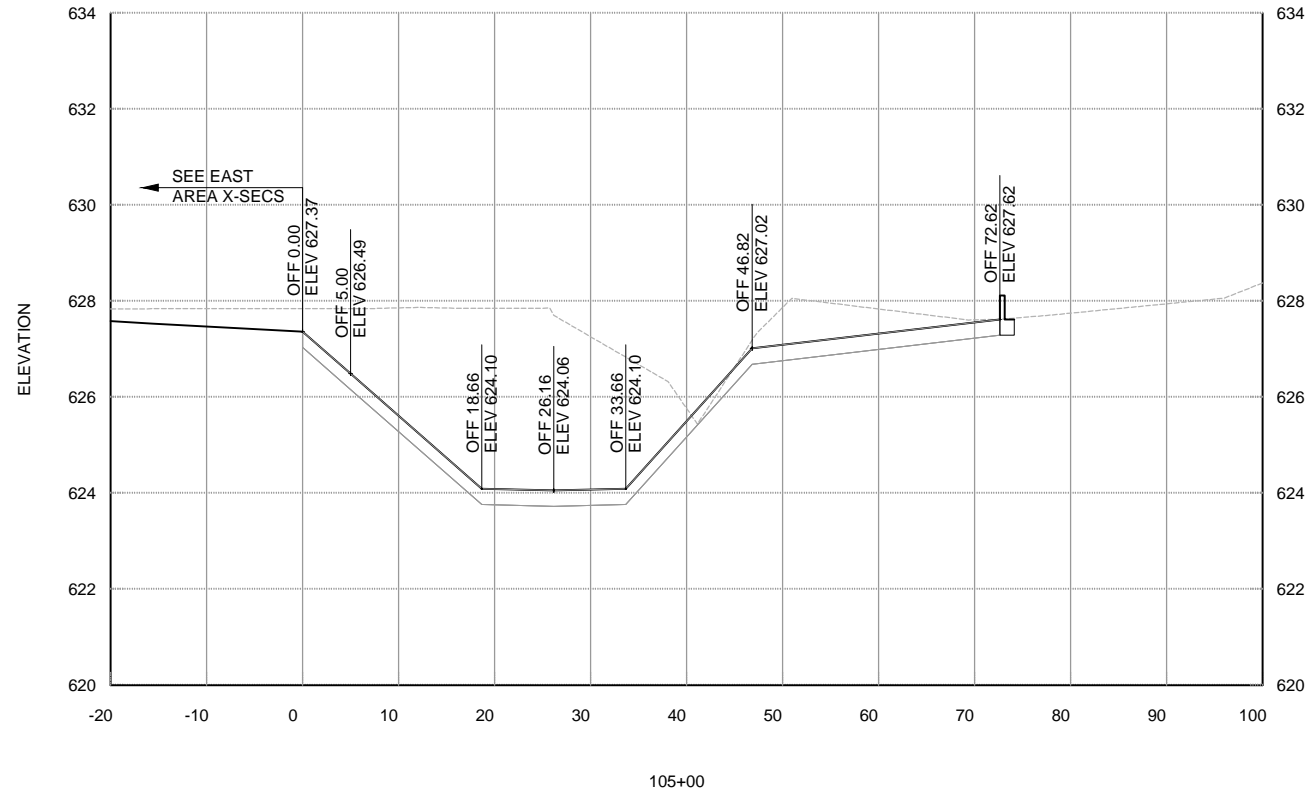

REGISTRATION NO.  
F-5713

RECORD DRAWINGS  
03/10/2015

REV.	DATE	DESCRIPTION	BY

**Addison Airport**  
 ADDISON AIRPORT  
 ADDISON, TEXAS

SOUTH AREA CROSS SECTIONS VI

JOB NO.: 13081100  
 DATE: NOV, 2013  
 DESIGNED BY: BCB  
 DRAWN BY: BCB

BAR IS ONE INCH ON ORIGINAL DRAWING  
 IF NOT ONE INCH ON THIS SHEET, ADJUST SCALES ACCORDINGLY.

DRAWING NUMBER  
**SA-X6**

SHEET NUMBER  
**70**

RUNWAY 33 RSA IMPROVEMENTS