
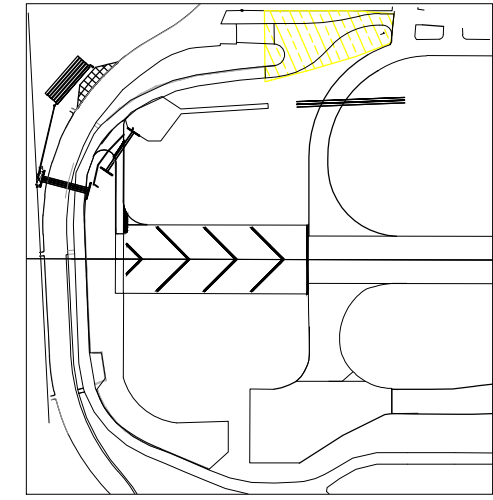
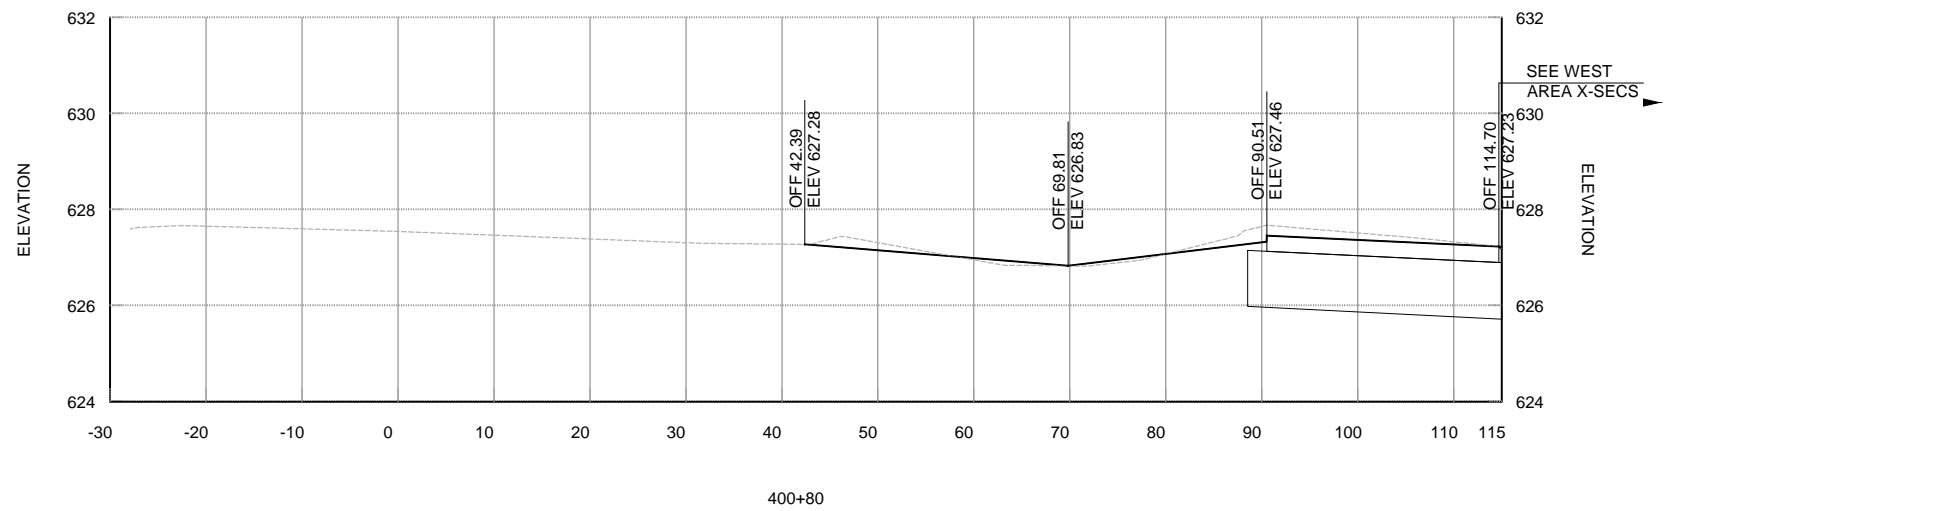
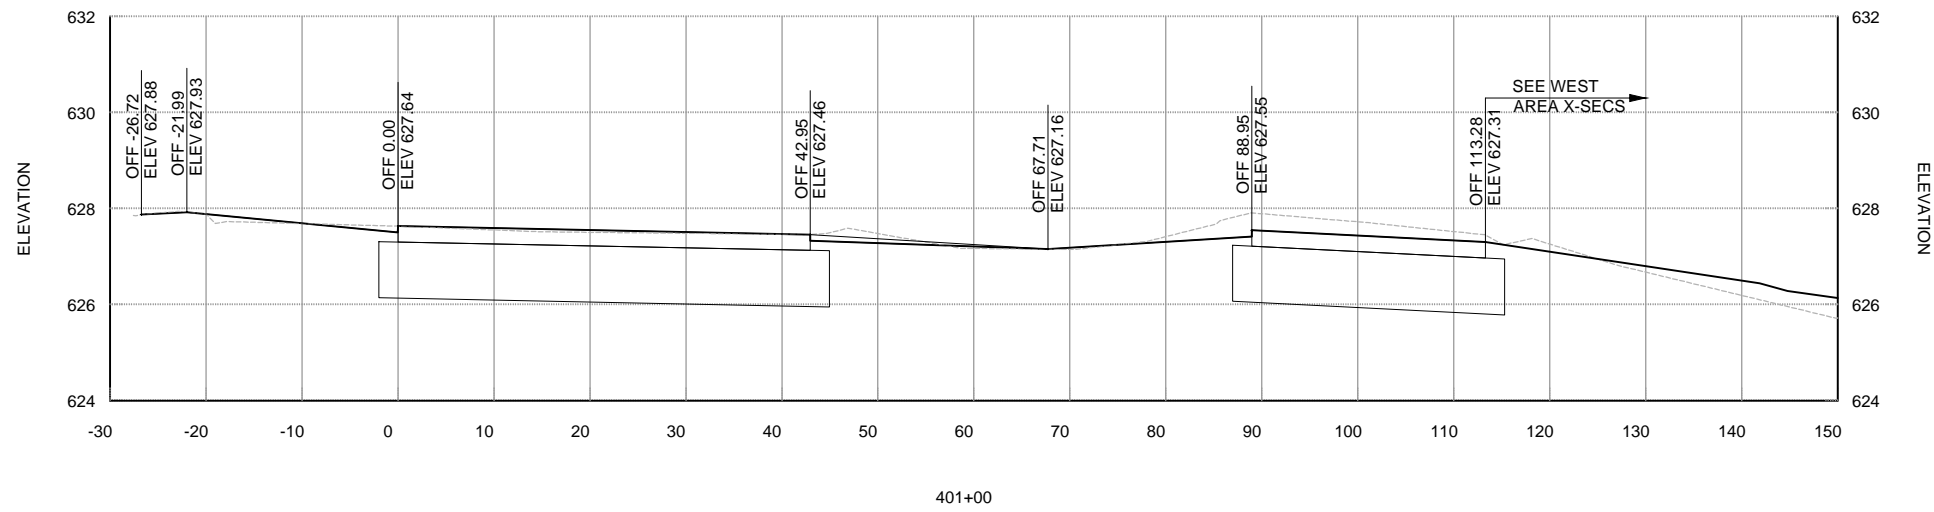


File: I:\2014\14081101 - ads emas construction\Drawings\RECORD\ADS_EMAS_EAX1_EX.dwg Last Save: 10/15/2014 1:43 PM Last saved by: Mmiccally
 Last plotted by: Suarez, Javier Plot Style: AECmono.ctb Plot Scale: 1:1 Plot Date: 3/10/2015 5:03 PM Plotter used: DWG To PDF.pc3

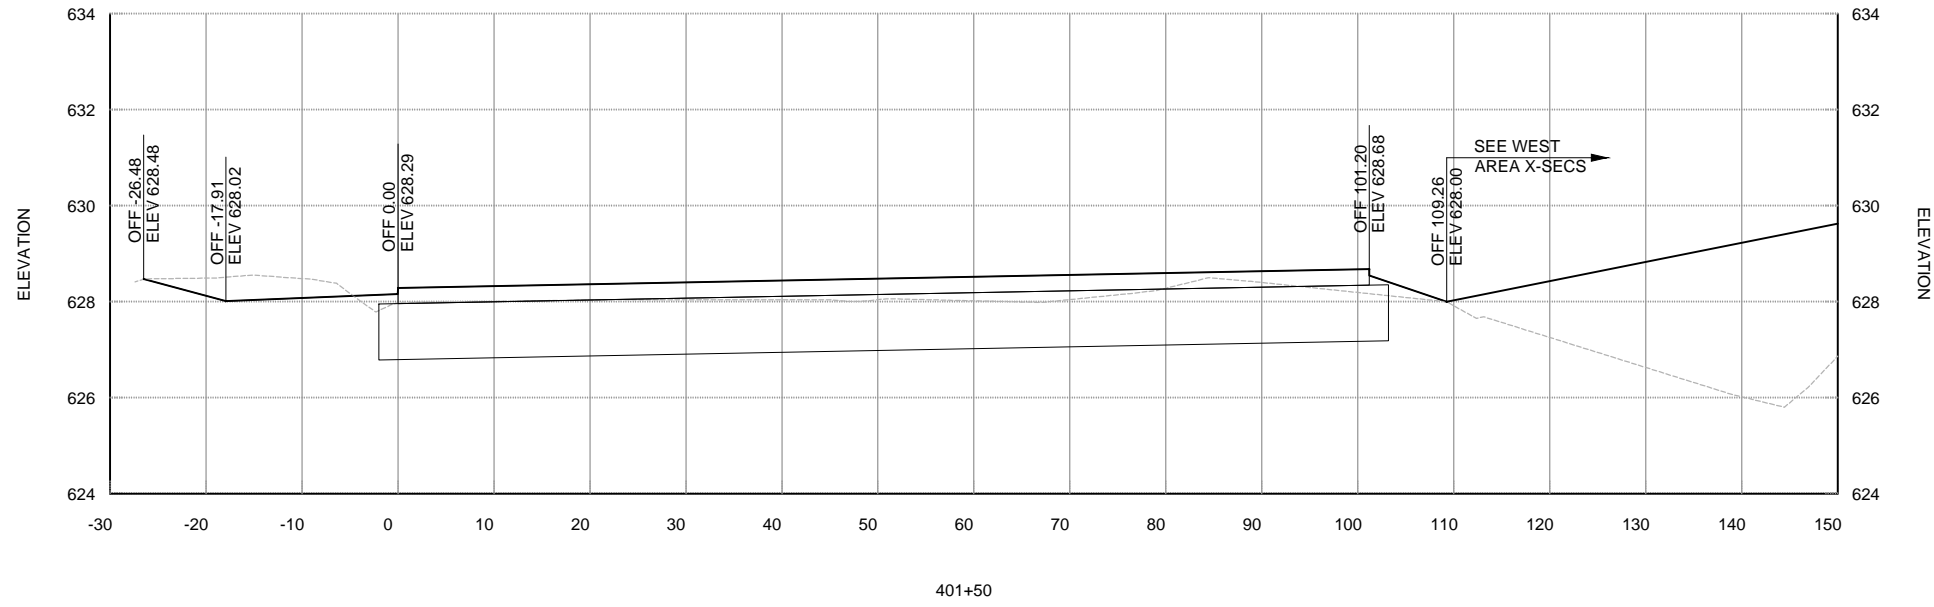

REGISTRATION NO.
F-5713

RECORD DRAWINGS
03/10/2015

REV.	DATE	DESCRIPTION	BY

Addison Airport
 ADDISON, TEXAS
 RUNWAY 33 RSA IMPROVEMENTS

SOUTHWEST
 VEHICLE ACCESS
 ROAD CROSS
 SECTIONS I

JOB NO.: 13081100
 DATE: NOV. , 2013
 DESIGNED BY: BCB
 DRAWN BY: BCB

BAR IS ONE INCH ON ORIGINAL DRAWING
 IF NOT ONE INCH ON THIS SHEET, ADJUST SCALES ACCORDINGLY.

DRAWING NUMBER
AR-X1
 SHEET NUMBER **71**