

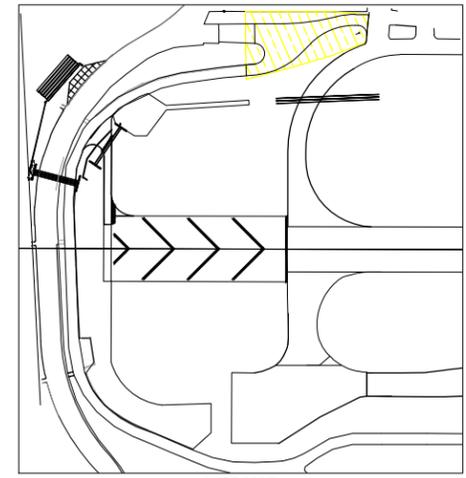


File: I:\2014\14081101 - ads emas construction\Drawings\RECORD\ADS_EMAS_EAX1_EX.dwg, Last Save: 10/15/2014 1:43 PM, Last saved by: Mmiccally
 Last plotted by: Suarez, Javier, Plot Style: AECmono.ctb, Plot Date: 3/10/2015 5:03 PM, Plotter used: DWG To PDF, p33

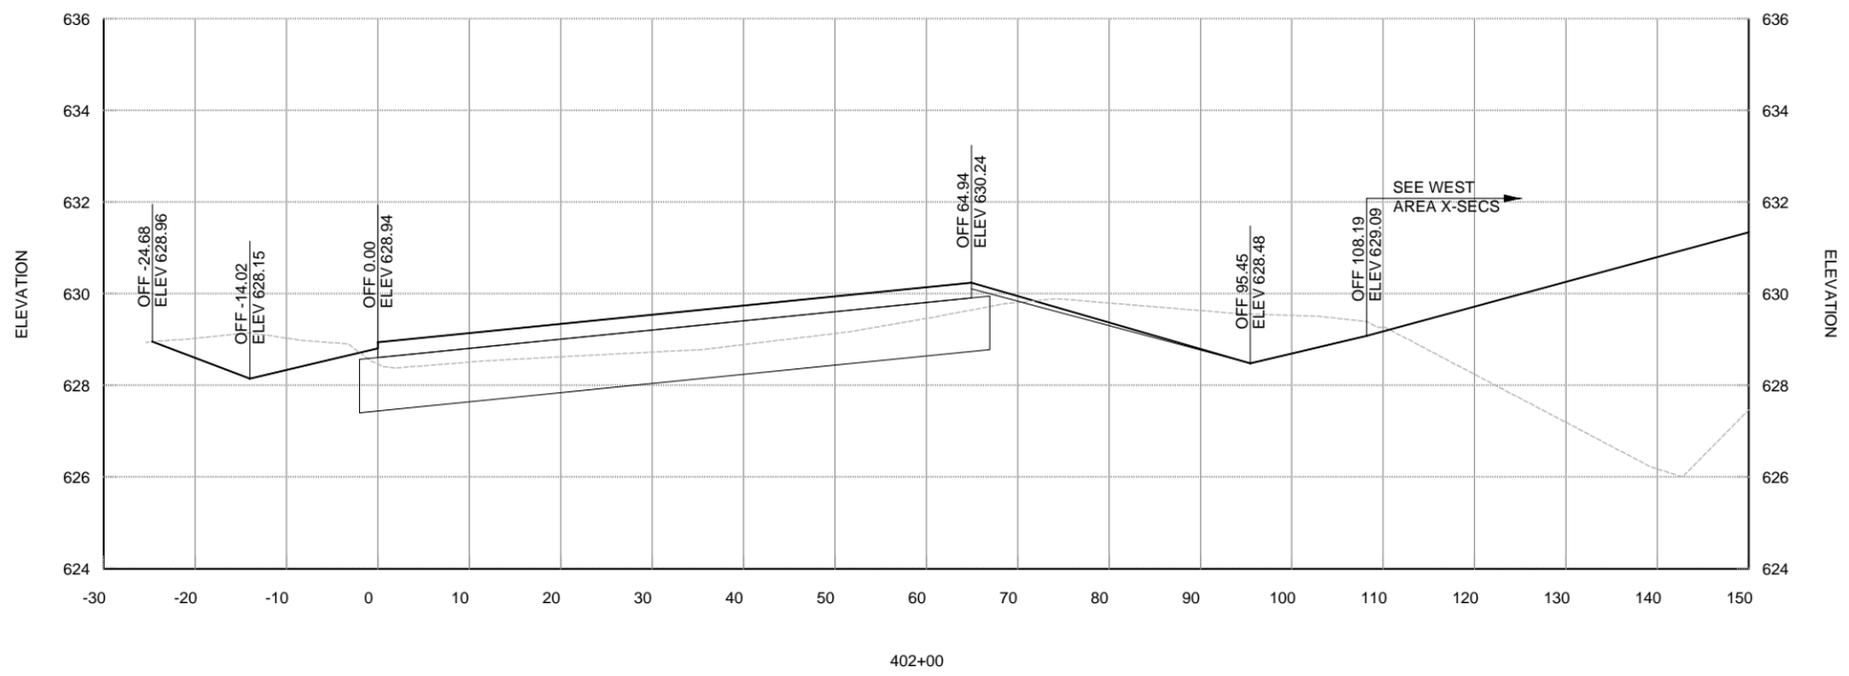

SITE MAP

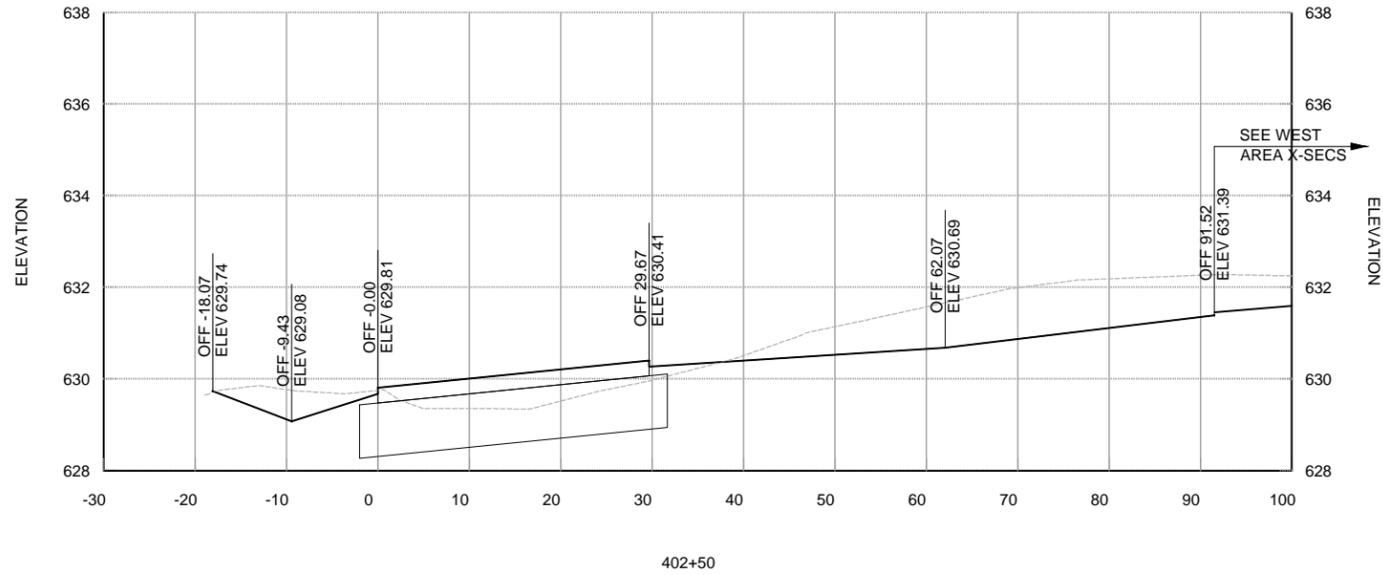

REGISTRATION NO.
F-5713

RECORD DRAWINGS
03/10/2015

REV.	DATE	DESCRIPTION	BY



ADDISON AIRPORT
ADDISON, TEXAS
RUNWAY 33 RSA IMPROVEMENTS

SOUTHWEST
VEHICLE ACCESS
ROAD CROSS
SECTIONS II

JOB NO.: 13081100
DATE: NOV. , 2013
DESIGNED BY: BCB
DRAWN BY: BCB

BAR IS ONE INCH ON ORIGINAL DRAWING
IF NOT ONE INCH ON THIS SHEET, ADJUST SCALES ACCORDINGLY.

DRAWING NUMBER
AR-X2

SHEET NUMBER 72