
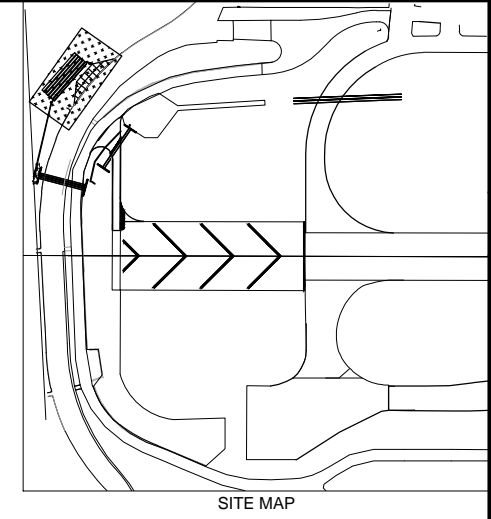


File: I:\2014\14081101 - ads emas construction\Drawings\RECORD\ADS\_EMAS\_EAX1\_EX.dwg Last Save: 10/15/2014 1:43 PM Last saved by: Mmiccally  
 Last plotted by: Suarez, Javier Plot Style: AECmono.ctb Plot Date: 3/10/2015 5:04 PM Plotter used: DWG To PDF.pc3

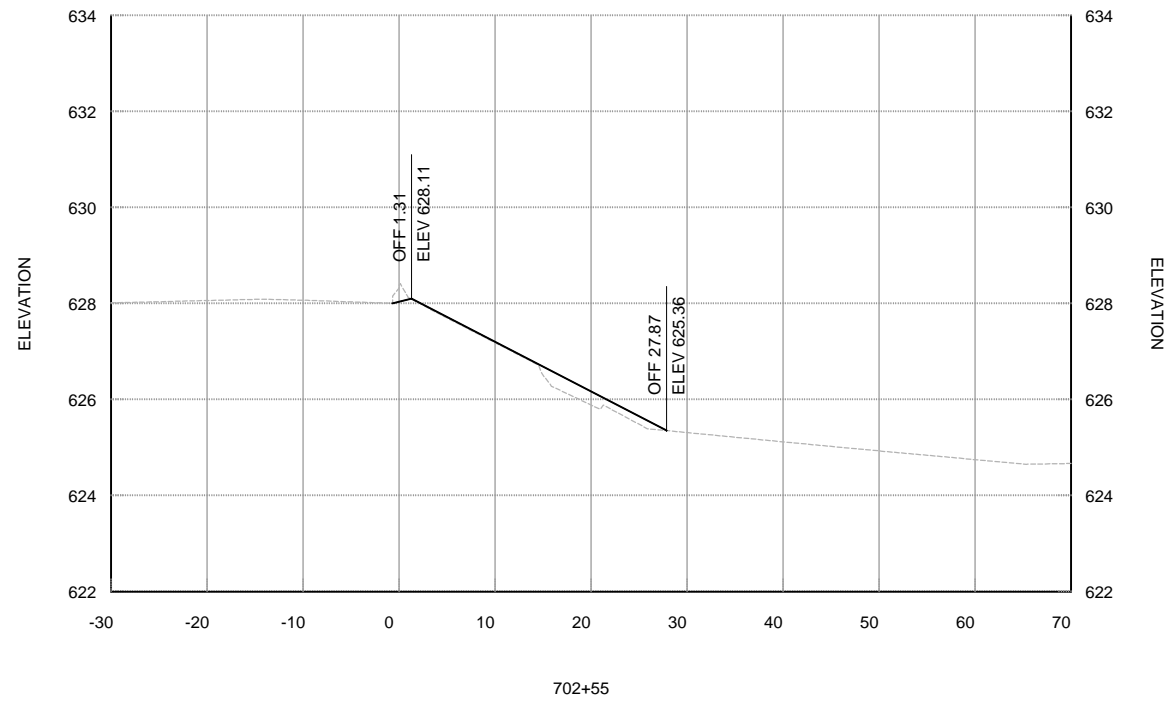

REGISTRATION NO.  
F-5713

RECORD DRAWINGS  
03/10/2015

REV.	DATE	DESCRIPTION	BY

**Addison Airport**  
ADDISON, TEXAS

**RUNWAY 33 RSA IMPROVEMENTS**

RAINWATER  
HARVESTING SYSTEM  
ACCESS CROSS  
SECTIONS III

JOB NO.: 13081100  
DATE: NOV. , 2013  
DESIGNED BY: BCB  
DRAWN BY: BCB

BAR IS ONE INCH ON ORIGINAL DRAWING  
0 1"  
IF NOT ONE INCH ON THIS SHEET, ADJUST SCALES ACCORDINGLY.

DRAWING NUMBER  
**RW-03**

SHEET NUMBER **76**