



LEGEND

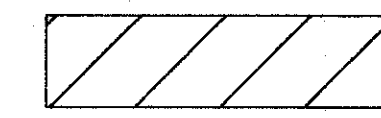


EXIST. PAVEMENT TO BE MILLED


RECONSTRUCTED WITH PROJECT A.I.P. 3-48-0063-05
TAXIWAY "H"

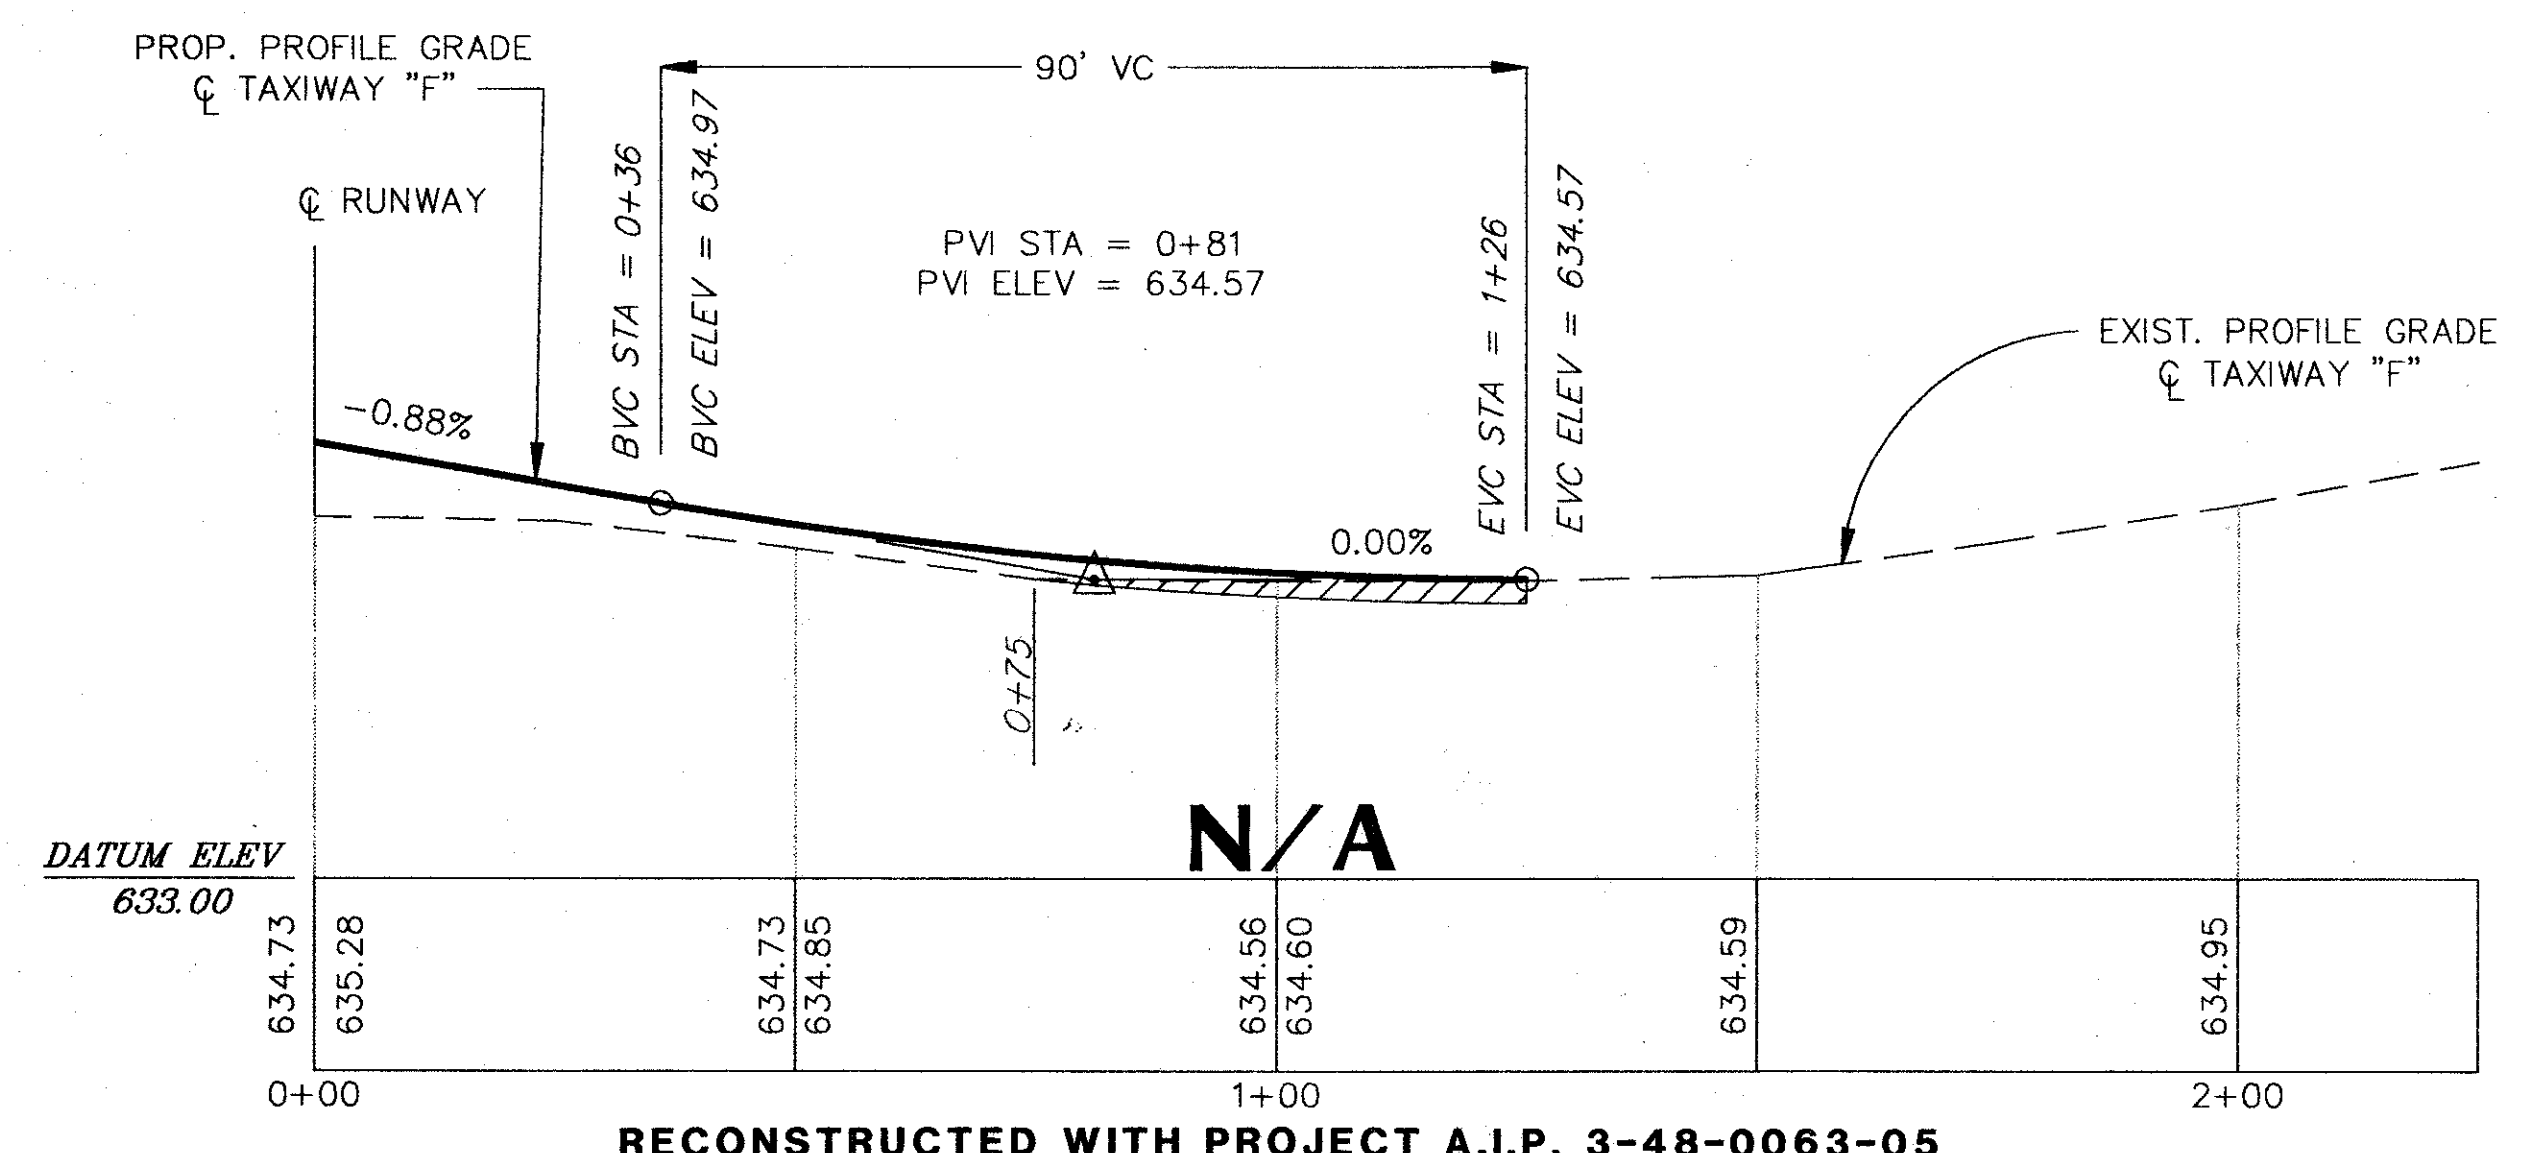


RECONSTRUCTED WITH PROJECT A.I.P. 3-48-0063-05
TAXIWAY "F"

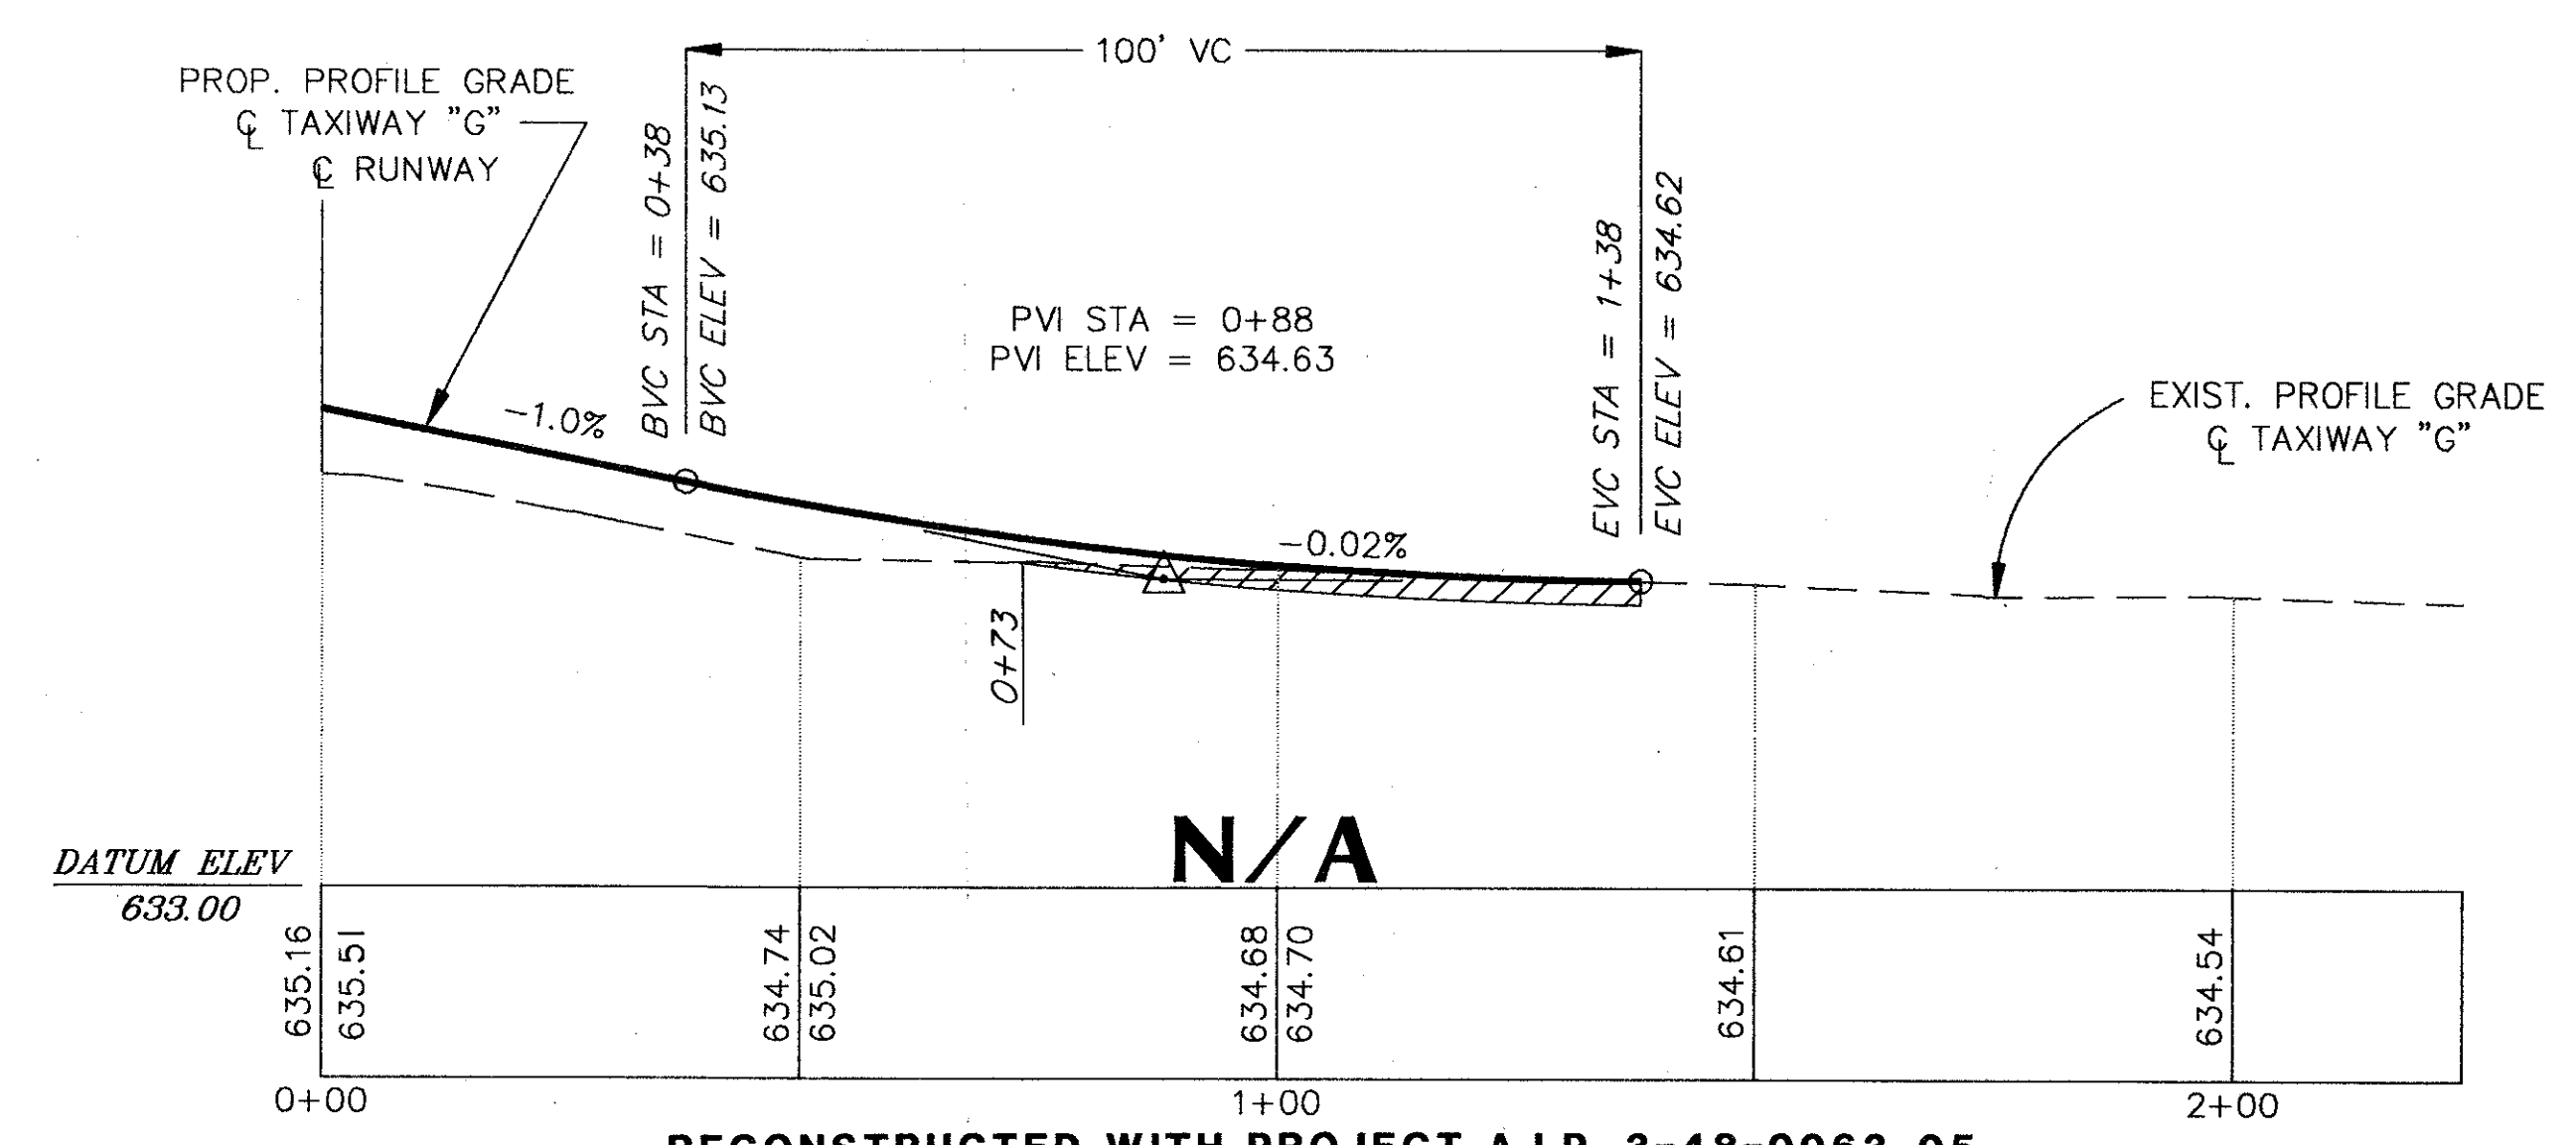

RECONSTRUCTED WITH PROJECT A.I.P. 3-48-0063-05
TAXIWAY "G"

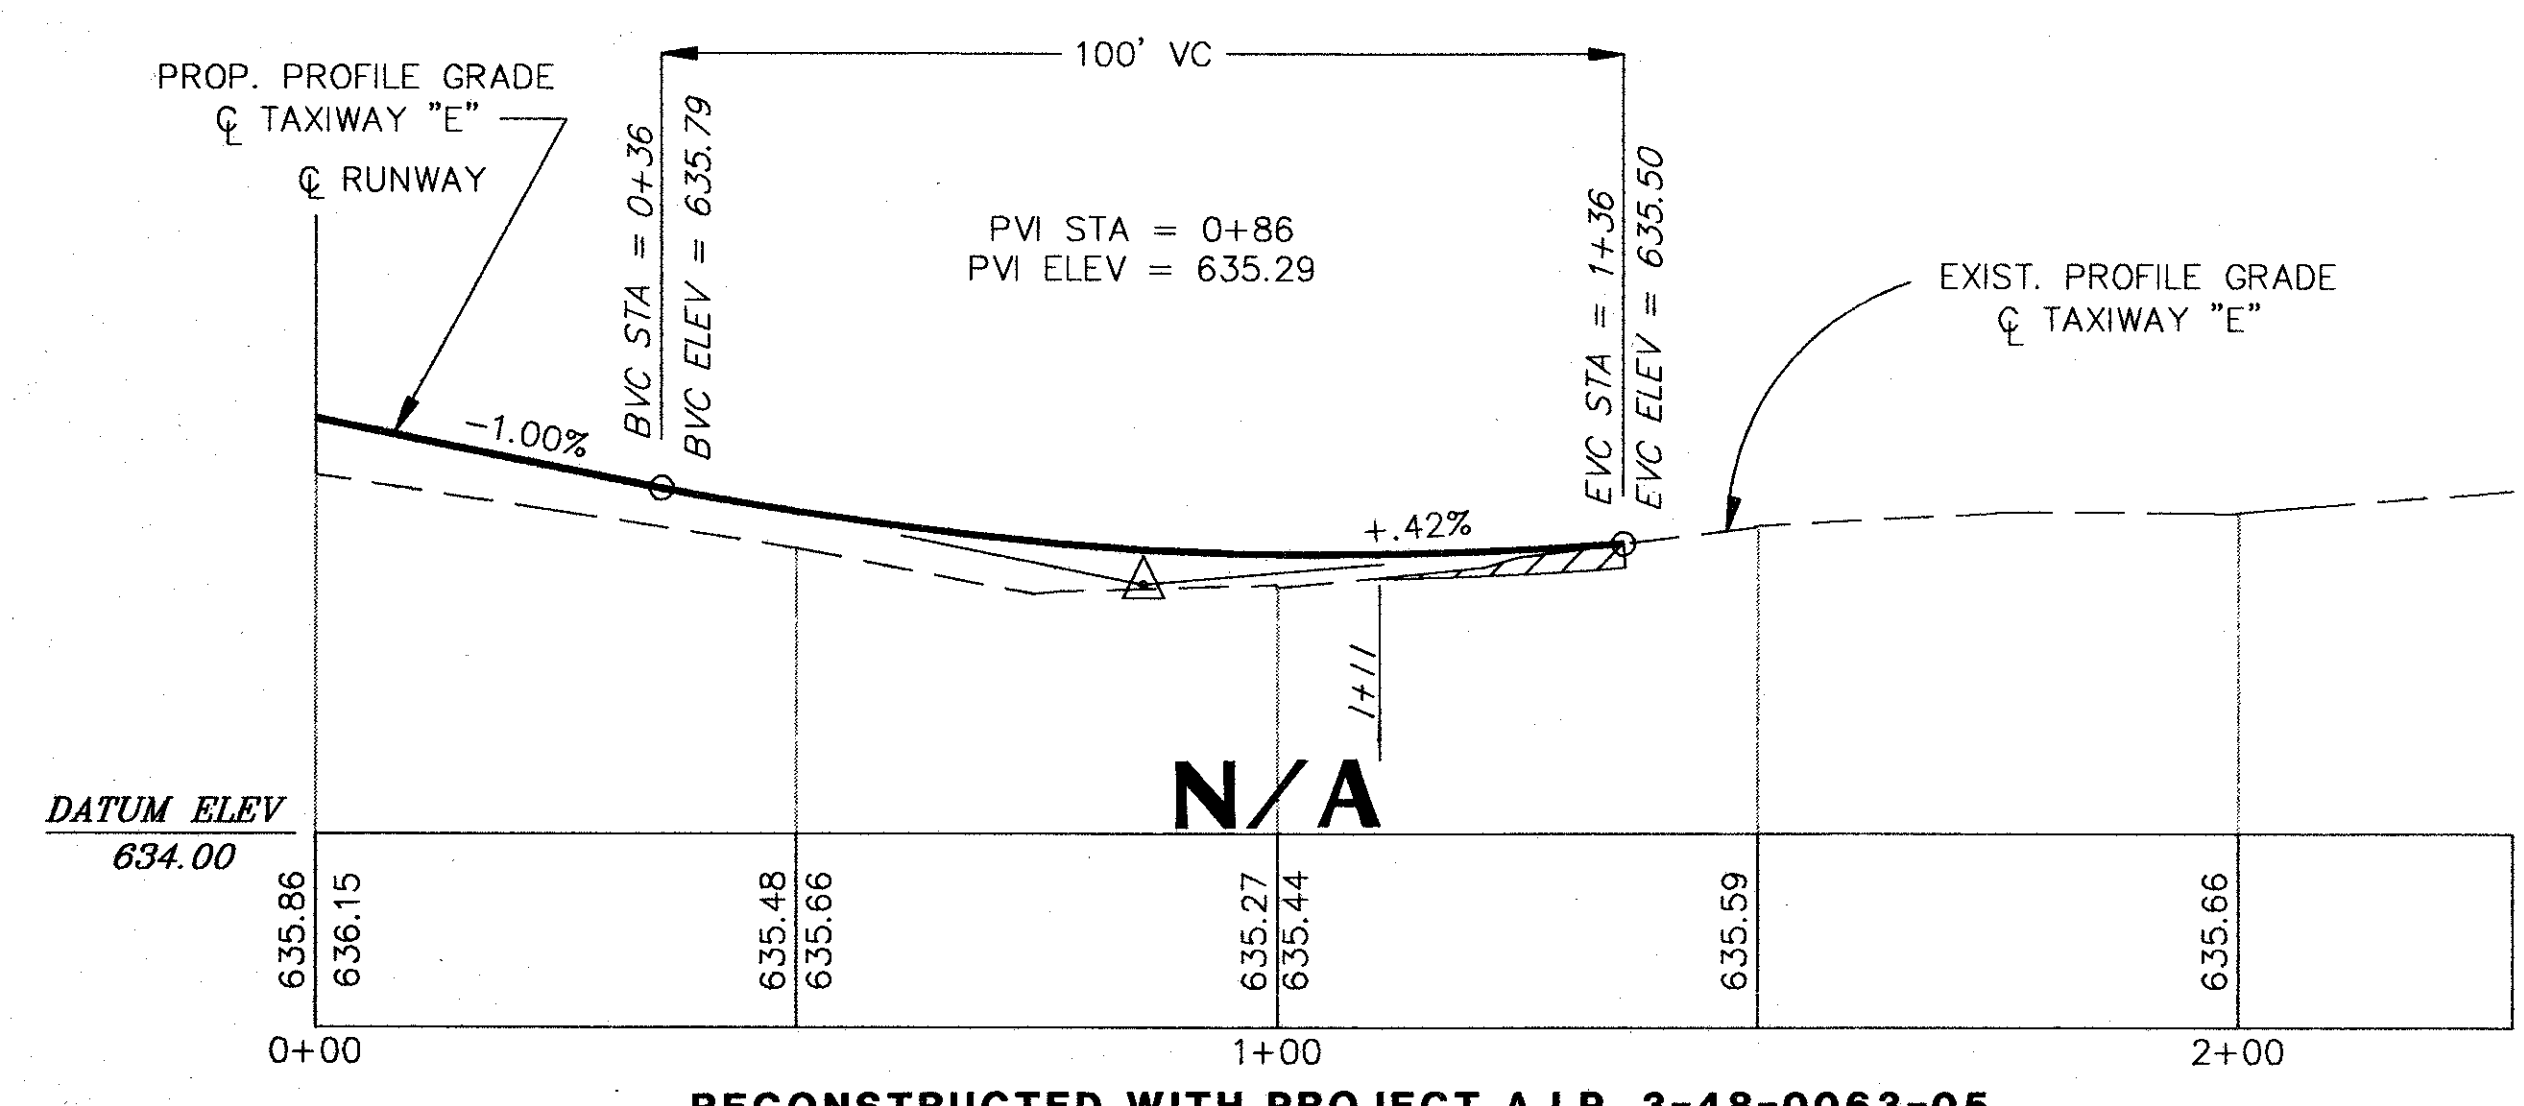


RECONSTRUCTED WITH PROJECT A.I.P. 3-48-0063-05
TAXIWAY "E"

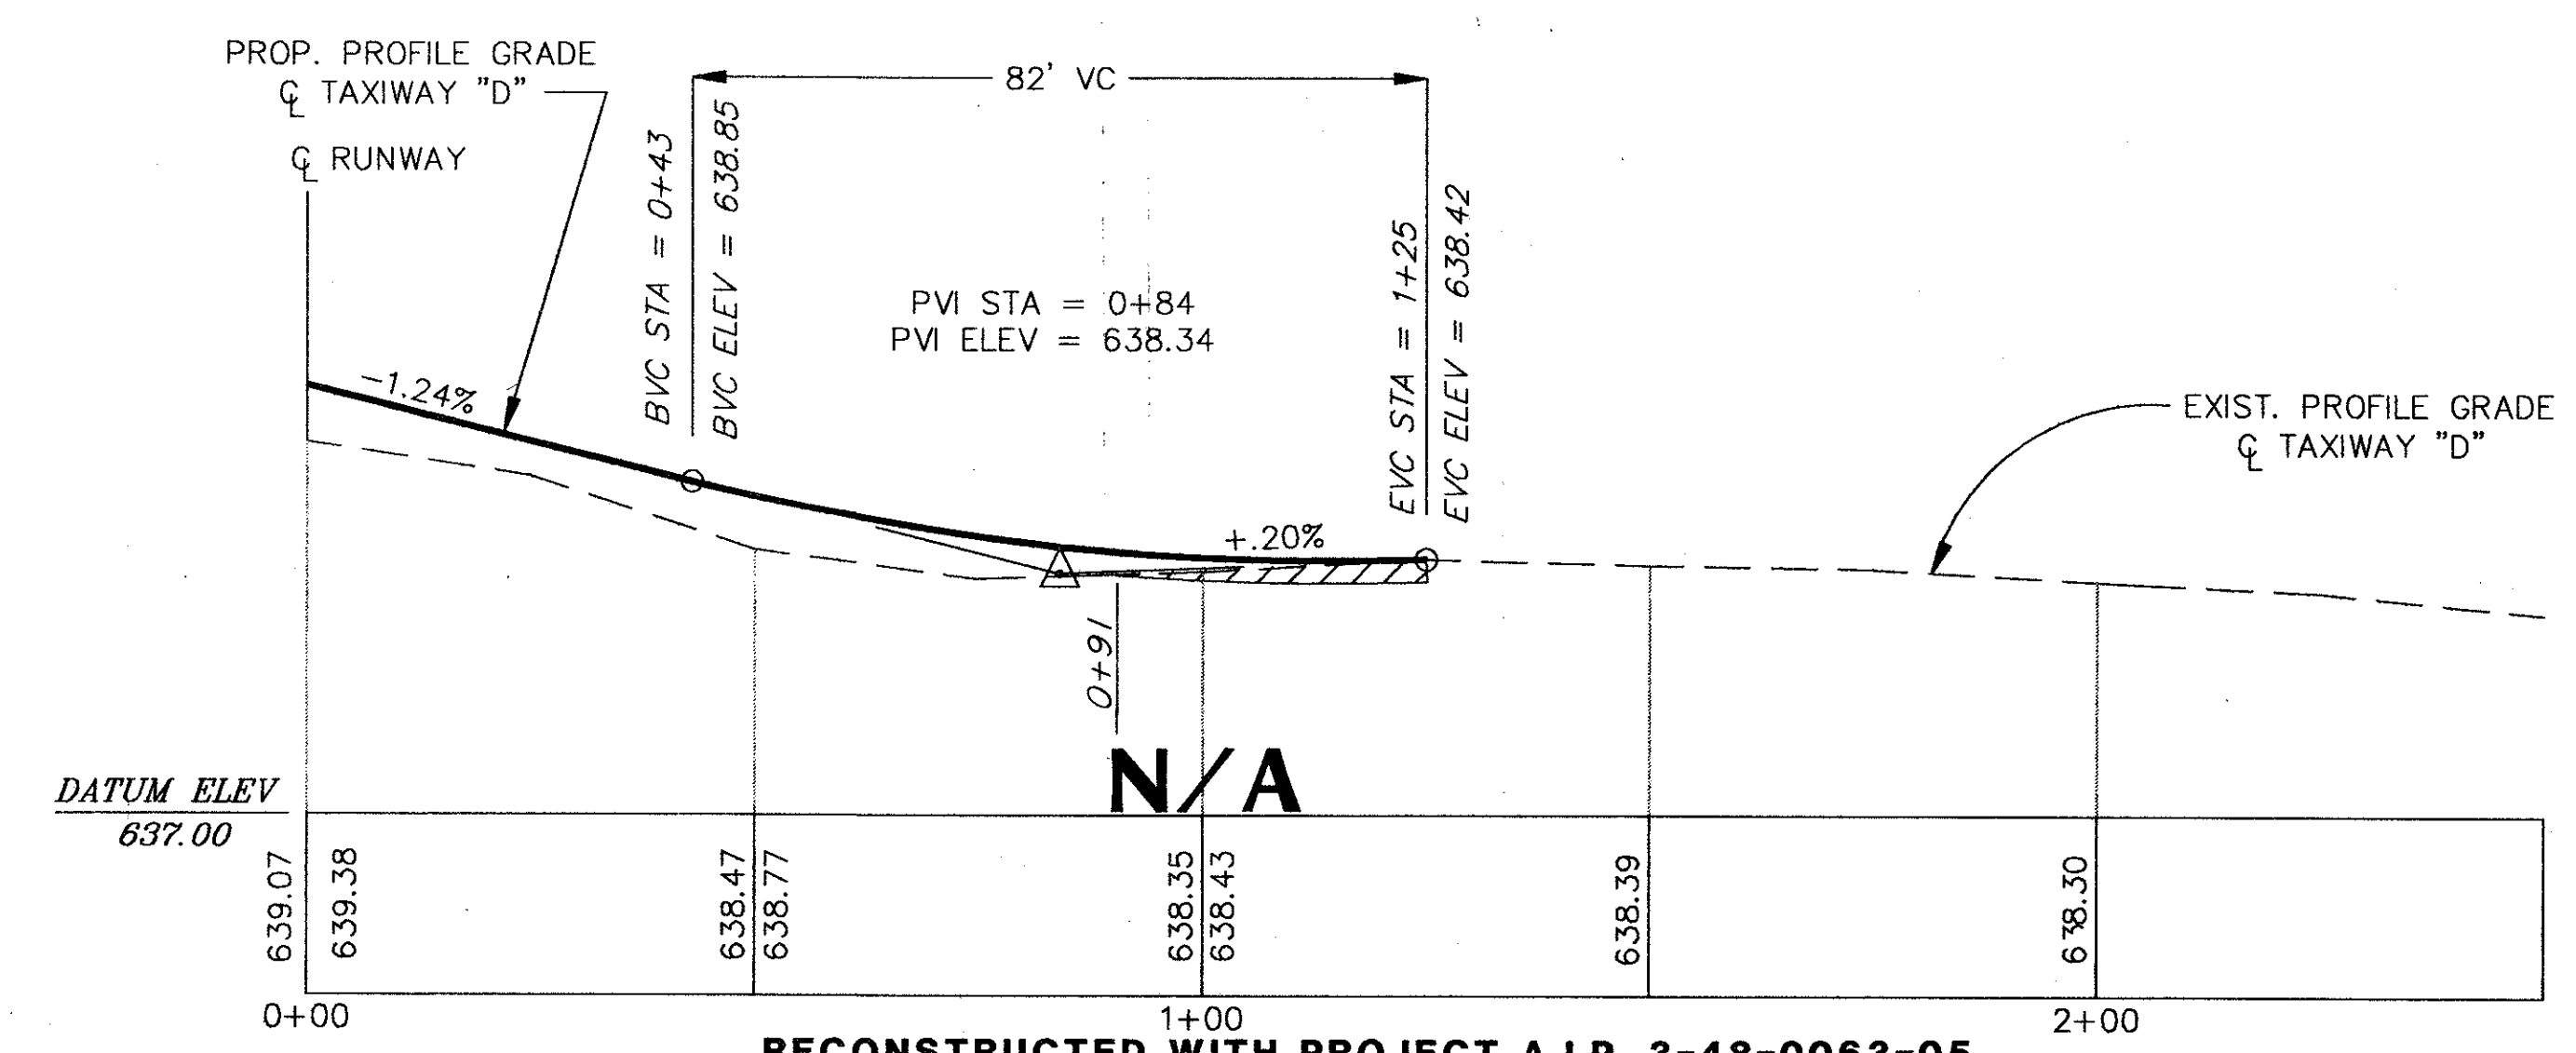

RECONSTRUCTED WITH PROJECT A.I.P. 3-48-0063-05
TAXIWAY "D"

AS BUILT
NOV 10 1993

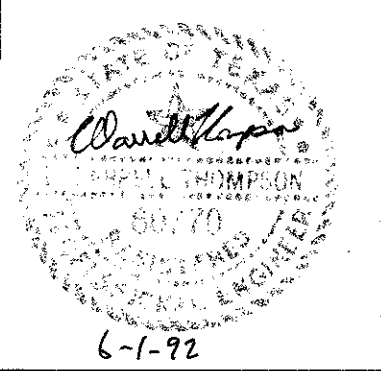

DESIGN: J.C.	A.I.P. NO: 3-48-0063-04-92	Date	Revisions	By
DRAWN: M.G.	BID NO: 92-29			
CHECKED: D.T.	JOB NO: Y8024.30			
SCALE: 1" = 20' HORIZ. 1" = 1' VERT.				

Greiner
Greiner, Inc.
Fort Worth, Texas
Engineers, Architects
and Planners



ADDISON AIRPORT

RUNWAY REHABILITATION
TAXIWAY PROFILES

SHEET 10
DATE: JUNE 1993

Copyright © Greiner, Inc. 1992. All Rights Reserved