



MATCH LINE STA. 29+00

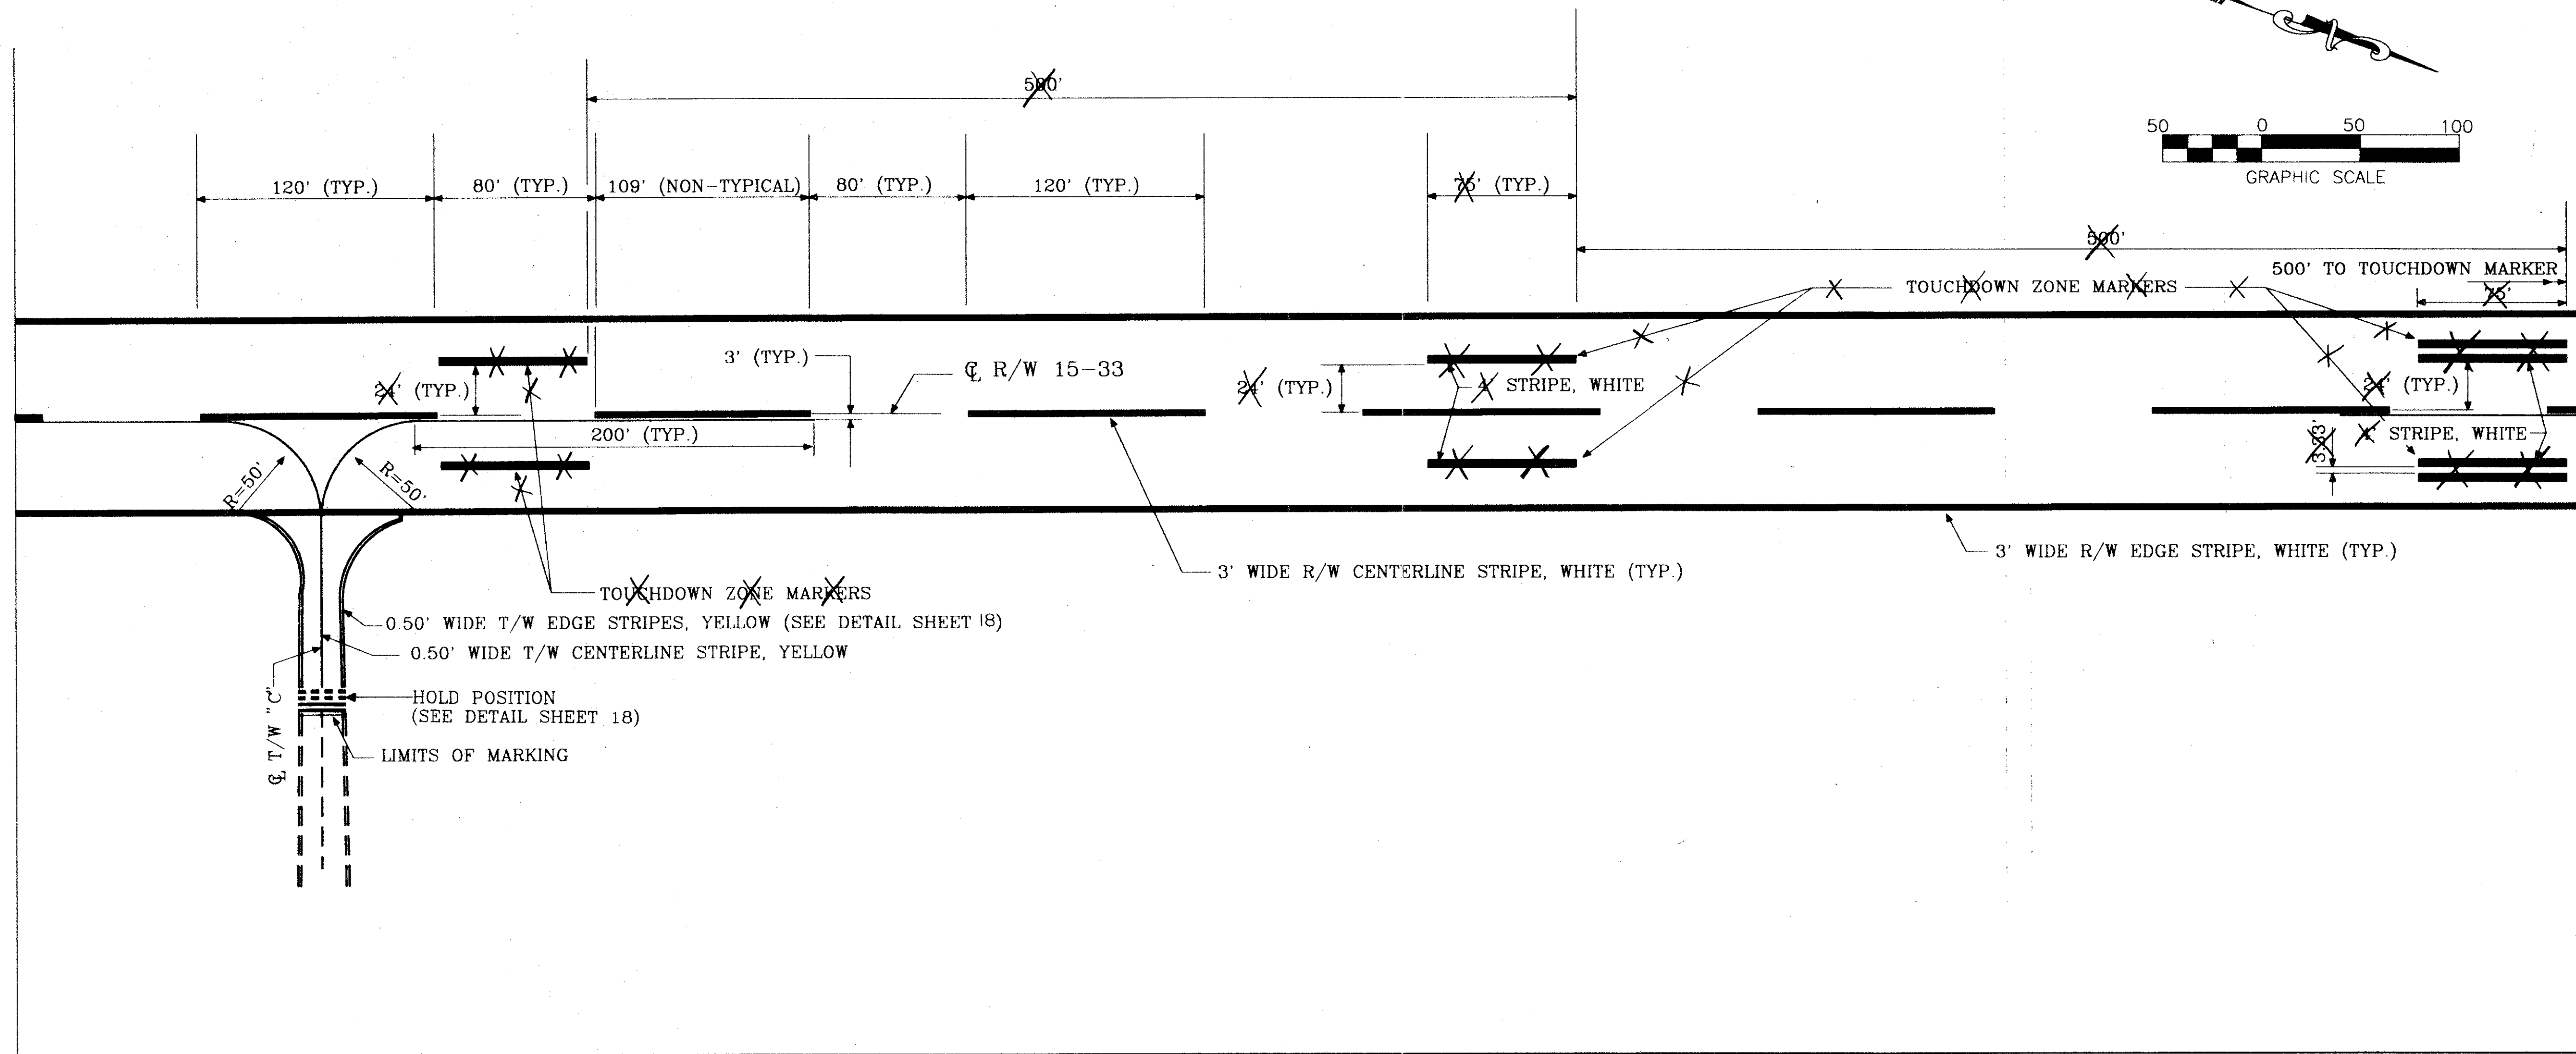


MATCH LINE STA. 42+00

MATCH LINE STA. 42+00

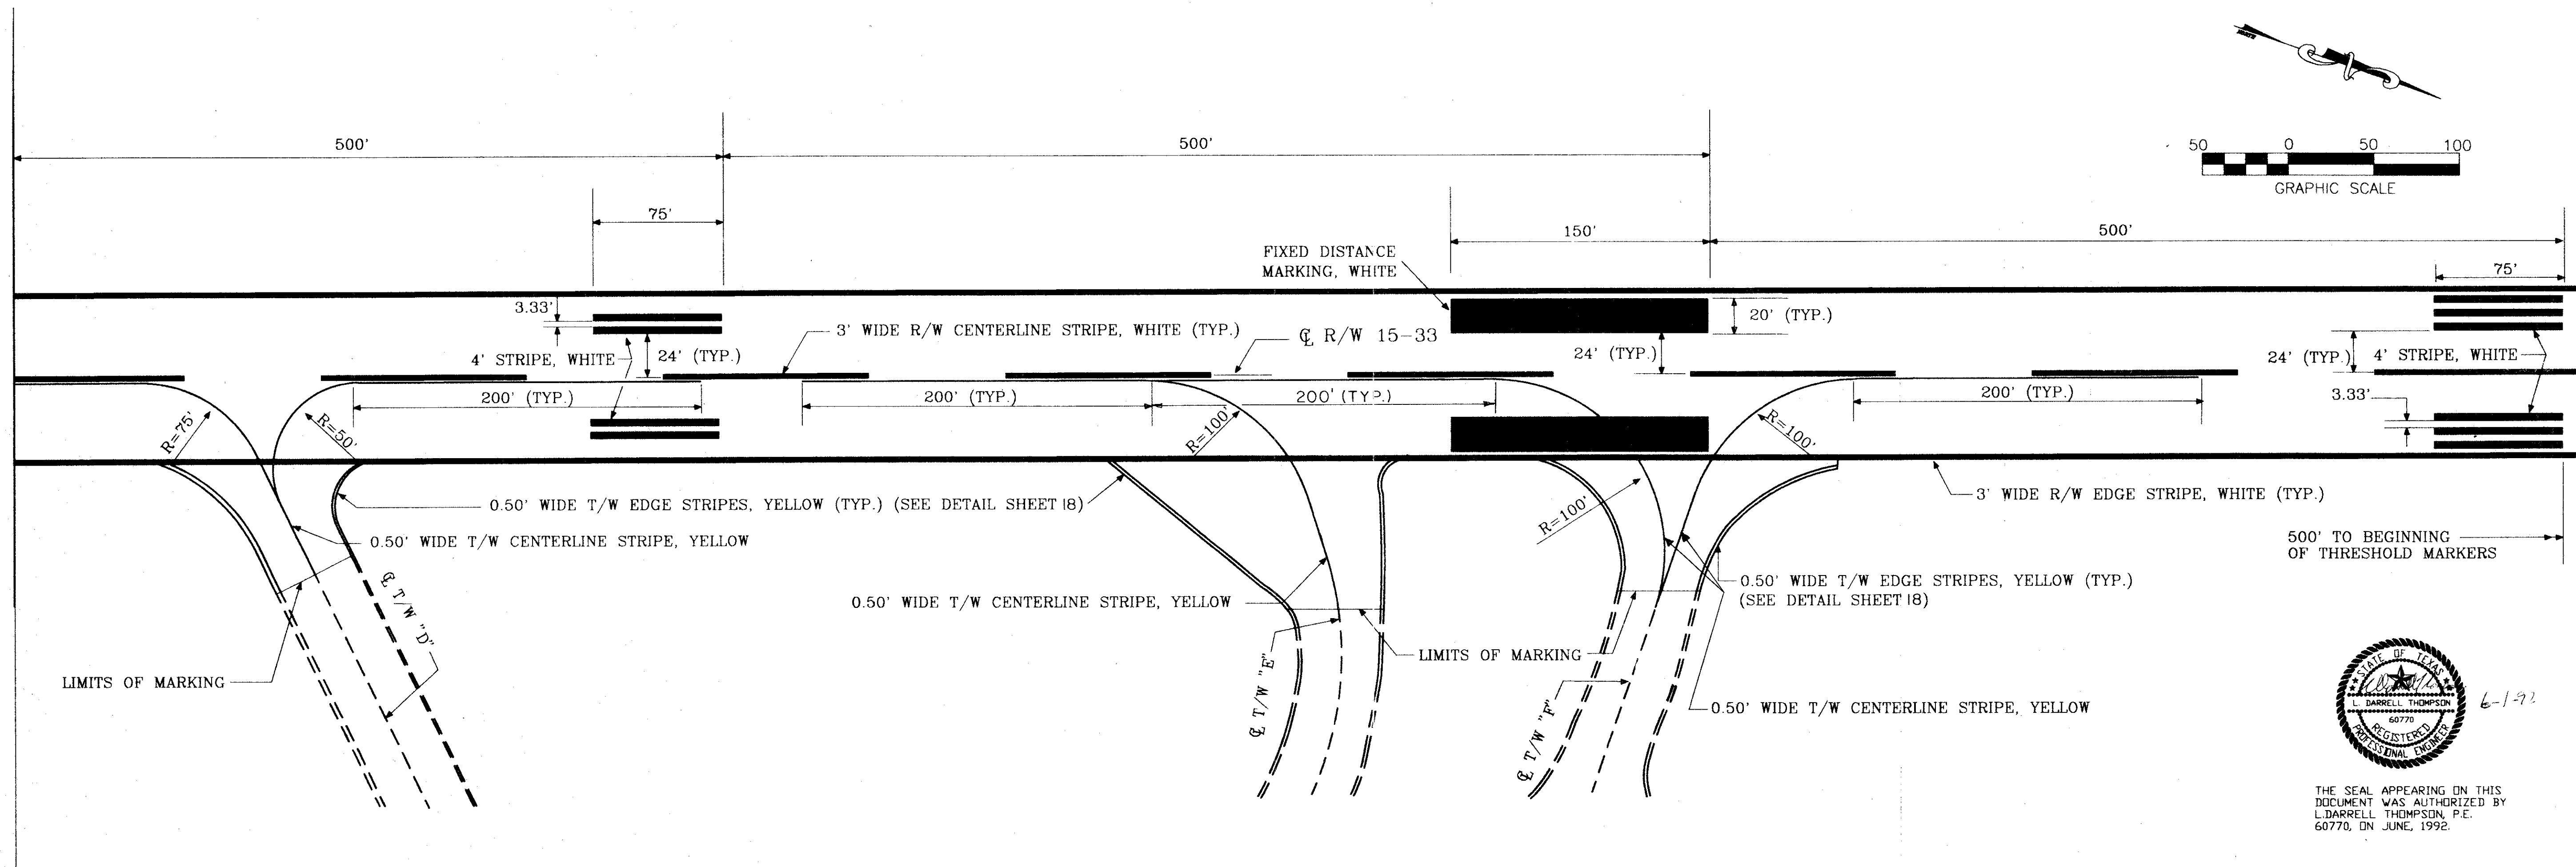

MATCH LINE STA. 57+00

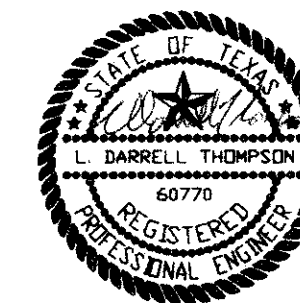

THE SEAL APPEARING ON THIS DOCUMENT WAS AUTHORIZED BY L. DARRELL THOMPSON, P.E. 60770, ON JUNE, 1992.

AS-BUILT

11-10-93

DESIGN: K.F.C.	A.I.P. NO: 3-48-0063-04-92	Date	Revisions	By
DRAWN: J.B.H.	BID NO: 92-29			
CHECKED: D.T.	JOB NO: Y8024.30			
SCALE: 1"=50'				

Greiner
Greiner, Inc.
Fort Worth, Texas

Engineers, Architects
and Planners



ADDISON AIRPORT

PAVEMENT MARKING PLAN AND DETAILS

SHEET
17

STA. 29+00 TO STA. 57+00

DATE: JUNE, 1992