


LEGEND

- R ● NEW ELEVATED R/W END LIGHTS (360° RED)
- ⊙ NEW ELEVATED R/W EDGE LIGHTS (360° WHITE)
- W ⊙ A NEW ELEVATED R/W EDGE LIGHTS (180° WHITE/AMBER)
- G ⊙ B NEW ELEVATED R/W THRESHOLD LIGHTS (180° GREEN/BLANK)
- NEW ELEVATED T/W EDGE LIGHTS (360° BLUE)
- NEW MANDATORY R/W GUIDANCE SIGNS AT EXISTING HOLDLINE
- NEW T/W EDGE LIGHT CIRCUIT (TW-1)
- NEW R/W EDGE LIGHT CIRCUIT (RW-1)
- ⊕ NEW ELECTRICAL PULLBOX
- ⊞ NEW ELECTRICAL HANDHOLE
- ⊞ MH NEW ELECTRICAL MANHOLE
- NEW 1 - 4" CONDUIT UNDER PAVEMENT
- EXISTING R/W LIGHTING CIRCUIT (TO BE ABANDONED)
- ⊞ EXISTING MALS R LIGHTS TO BE ADJUSTED TO NEW ELEVATION
- ≡≡≡ EXISTING HOLDLINE MARKING

MATCHLINE STA 12+00

AS BUILT
NOV 10 1993

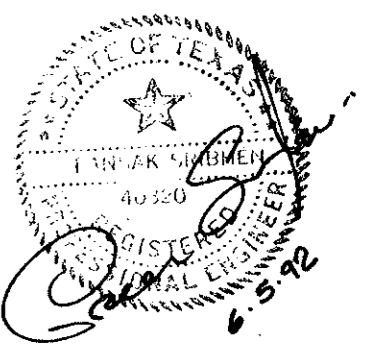

LP - 1

C:\DGN\ADS\ADSBORDR.DGN