


LEGEND

- NEW ELEVATED R/W END LIGHTS (360° RED)
- ⊙ NEW ELEVATED R/W EDGE LIGHTS (360° WHITE)
- ⊙A NEW ELEVATED R/W EDGE LIGHTS (180° WHITE/AMBER)
- ⊙B NEW ELEVATED R/W THRESHOLD LIGHTS (180° GREEN/BLANK)
- NEW ELEVATED T/W EDGE LIGHTS (360° BLUE)
- NEW MANDATORY R/W GUIDANCE SIGNS AT EXISTING HOLDLINE
- NEW T/W EDGE LIGHT CIRCUIT (TW-1)
- NEW R/W EDGE LIGHT CIRCUIT (RW-1)
- Ⓟ NEW ELECTRICAL PULLBOX
- Ⓜ NEW ELECTRICAL HANDHOLE
- ⓂH NEW ELECTRICAL MANHOLE
- NEW 1 - 4" CONDUIT UNDER PAVEMENT
- EXISTING R/W LIGHTING CIRCUIT (TO BE ABANDONED)
- ⊠ EXISTING MALSRL LIGHTS TO BE ADJUSTED TO NEW ELEVATION
- ≡≡≡ EXISTING HOLDLINE MARKING

AS BUILT

NOV 10 1993

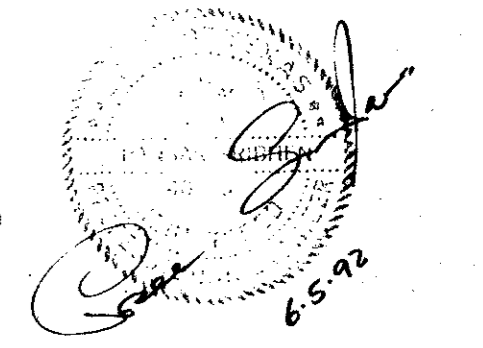

LP - 3

C:\DON\ADS\ADSBORDR.DGN

DESIGN: D. WHITAKER, P.E.
 DRAWN: PSA ENGINEERING
 CHECKED: P. SRIBHEN, P.E.
 SCALE: 1"=40'

A.I.P. NO. 3-48-0063-04-92			
BID NO. 92-29	11-8-93	AS-BUILT REVISIONS	J.R.H.
JOB NO. PSA 9205	Date	Revisions	By

Greiner Fort Worth, Texas
 Engineers, Architects
 and Planners

In Association With
ASA ENGINEERING
 DALLAS, TEXAS



ADDISON AIRPORT

AIRFIELD LIGHTING IMPROVEMENTS
 R/W LIGHTING LAYOUT/CIRCUIT PLAN

SHEET 22
 DATE: JAE, 1992