




VAULT SITE PLAN & ATC CABLE ROUTING PLAN
NOT TO SCALE

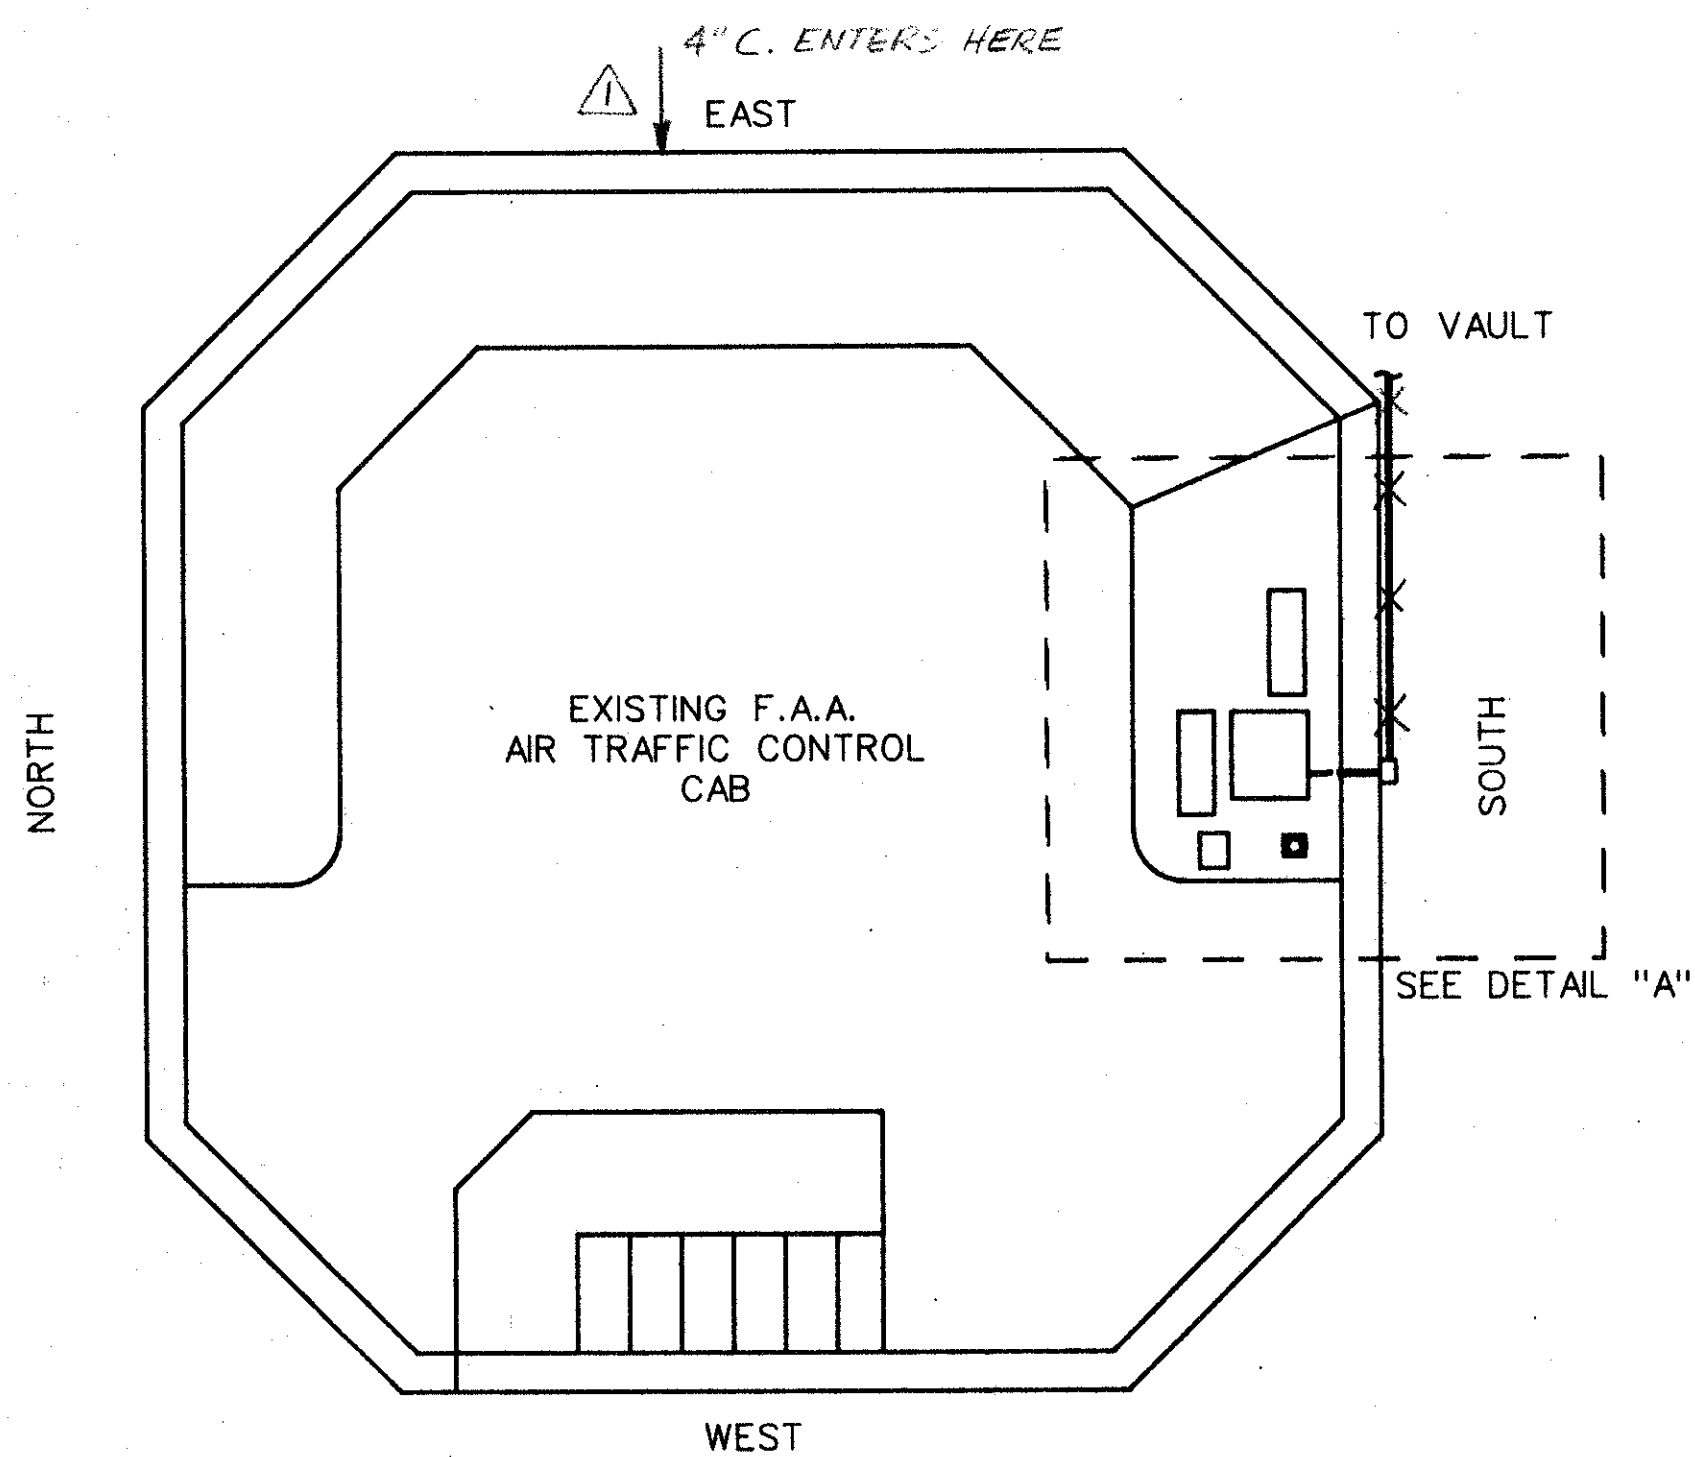

TOWER CAB MODIFICATION
NOT TO SCALE

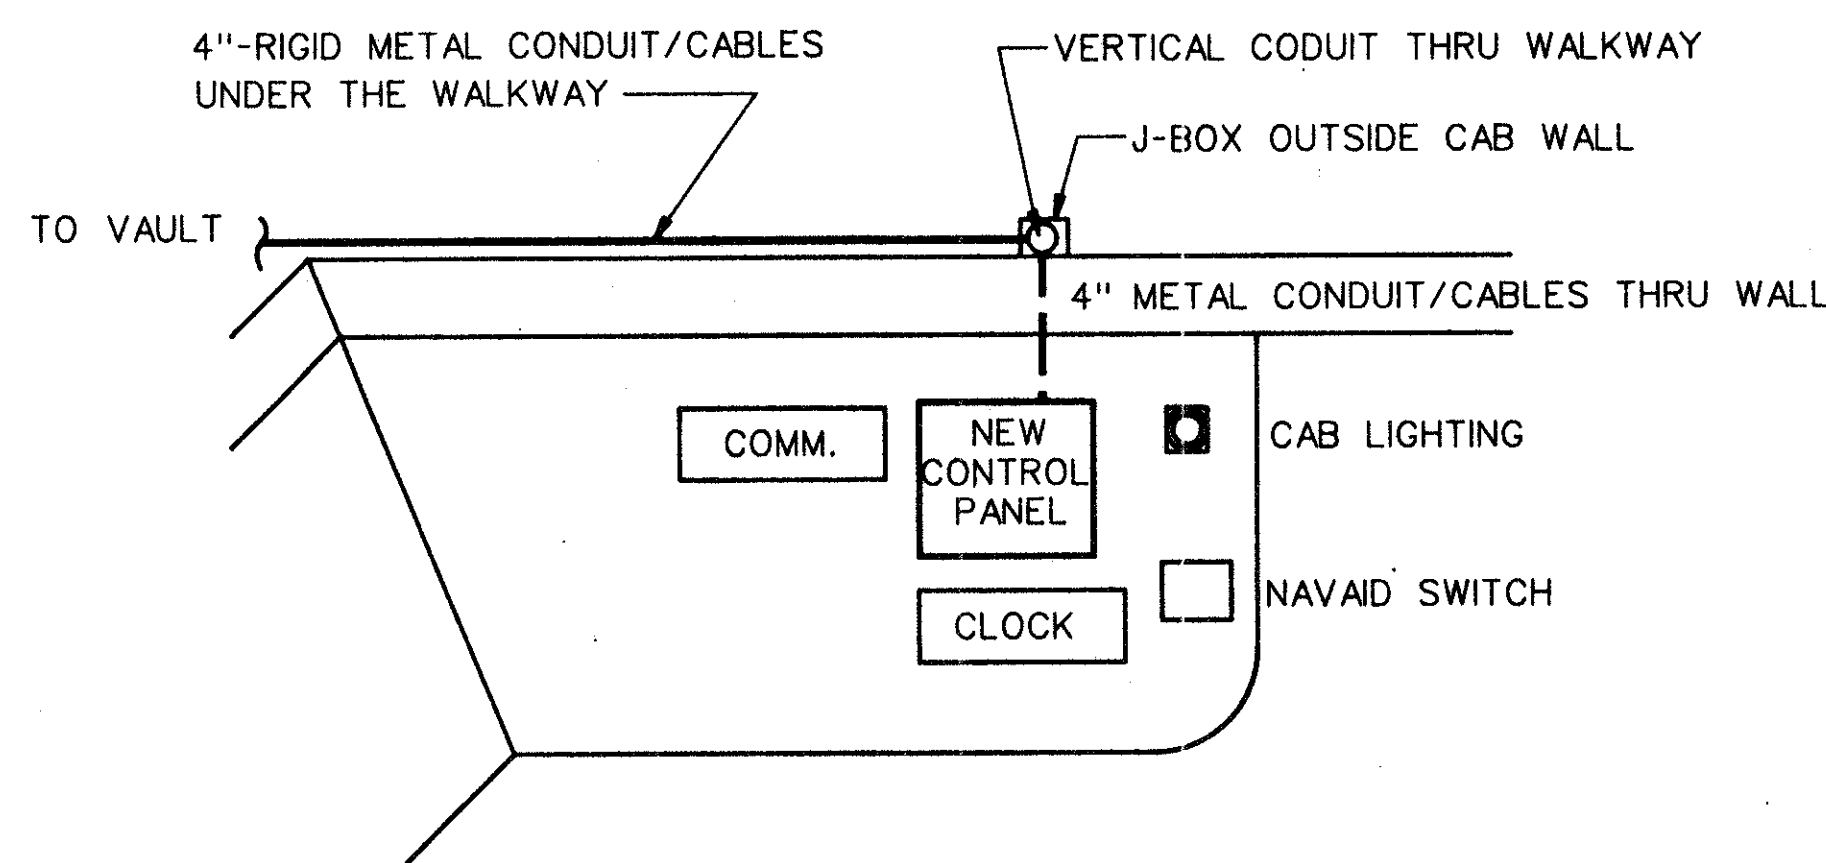


DETAIL "A"
NOT TO SCALE

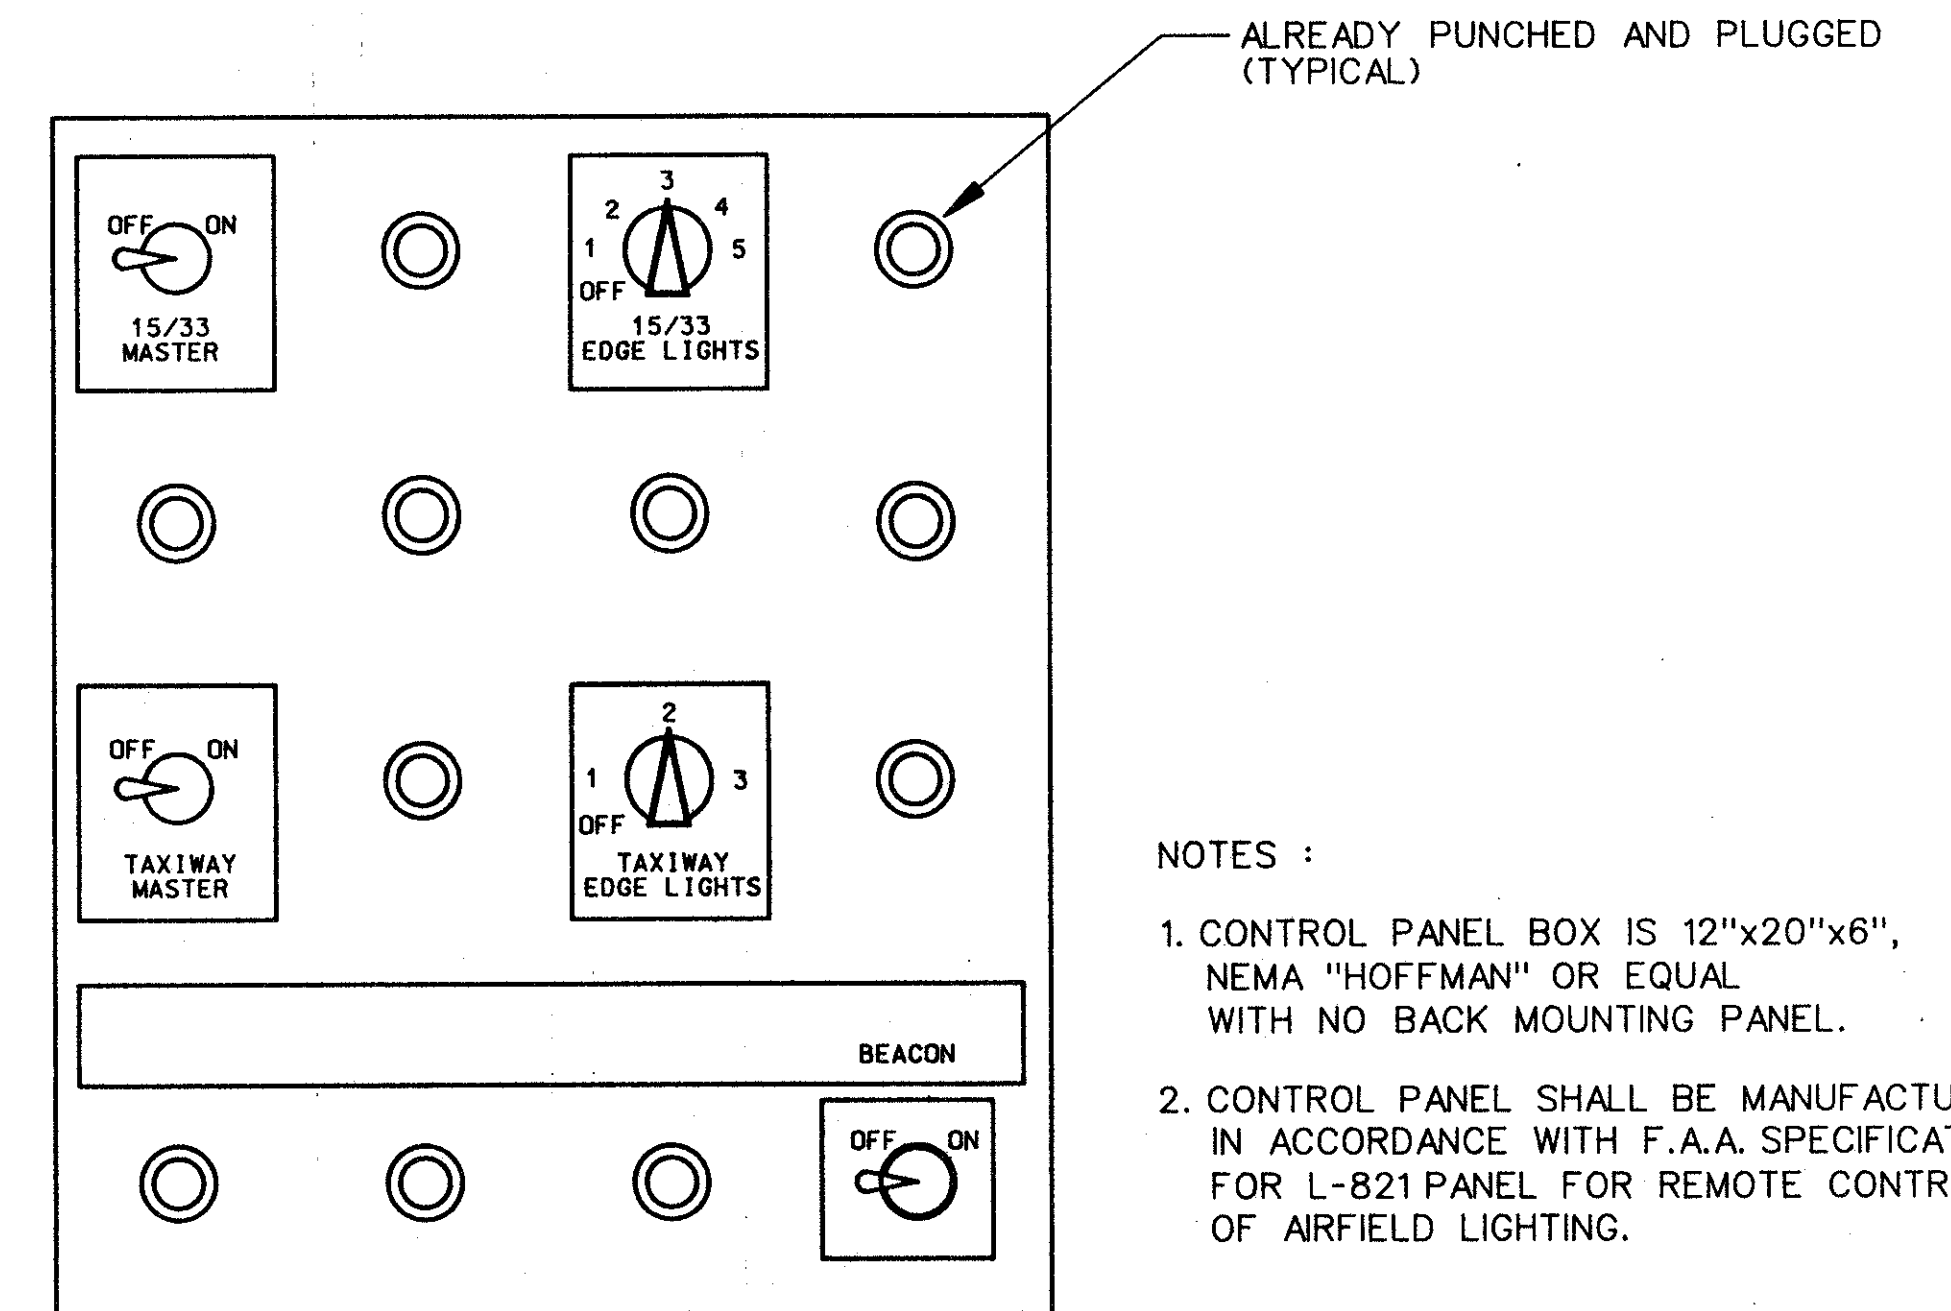

- NOTES :
- CONTROL PANEL BOX IS 12"x20"x6", NEMA "HOFFMAN" OR EQUAL WITH NO BACK MOUNTING PANEL.
 - CONTROL PANEL SHALL BE MANUFACTURED IN ACCORDANCE WITH F.A.A. SPECIFICATIONS. FOR L-821 PANEL FOR REMOTE CONTROL OF AIRFIELD LIGHTING.

AIRFIELD LIGHTING CONTROL PANEL
NOT TO SCALE

AS BUILT
NOV 10 1993

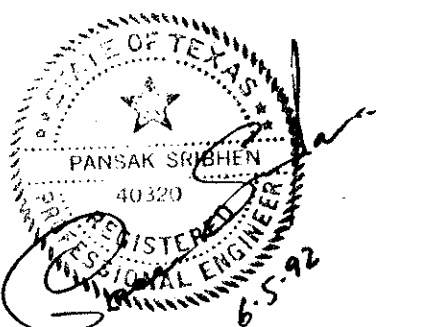

LP - 7

DESIGN: G. DABNEY, P.E.	A.I.P. NO. 3-48-0063-04-92		
DRAWN: PSA ENGINEERING	BID NO. 92-29	11-8-93	AS-BUILT REVISIONS
CHECKED: P. SRIBHEN, P.E.	JOB NO. PSA 9205	Date	Revisions
SCALE:		By	

Greiner Fort Worth, Texas
Engineers, Architects
and Planners

In Association With
ASA ENGINEERING
DALLAS, TEXAS



ADDISON AIRPORT

A.T.C. TOWER CONTROL PANEL

SHEET 26
DATE: JAN, 1992