


INTERNALLY LIGHTED
MANDATORY GUIDANCE SIGN
(DOUBLE PANELS)



NOTES:

- 1.) BASIC UNIT IS 73" X 24" WIDE X 14.4" DEEP AND IS CONSTRUCTED OF ALUMINUM POLYCARBONATE PLASTIC. THE ALUMINUM TOP IS REMOVABLE FOR LEGEND PANEL CHANGES.
- 2.) LIGHT SHALL BE PROVIDED BY STANDARD FLORESCENT 60W/120V LAMPS.
- 3.) MOUNTING WILL BE WITH ONE SLIPFITTER AND FRANGE COUPLING.
- 4.) SIGN SHALL HAVE WHITE LETTERING WITH RED BACKGROUND.
- 5.) GUIDANCE SIGNS SHALL CONFORM TO FAA ADVISORY CIRCULAR AC-150/5345-44B, FAA CLASS 2/SIZE 2, L-858 SIGN.
- 6.) GUIDANCE SIGNS SHALL BE DOUBLE SIDED.
- 7.) SIGN FACE SHALL DISPLAY AS SHOWN ON THE PLANS. SIGN FACES ON OPPOSIT SIDE ARE BLANK (BLACK COLOR)

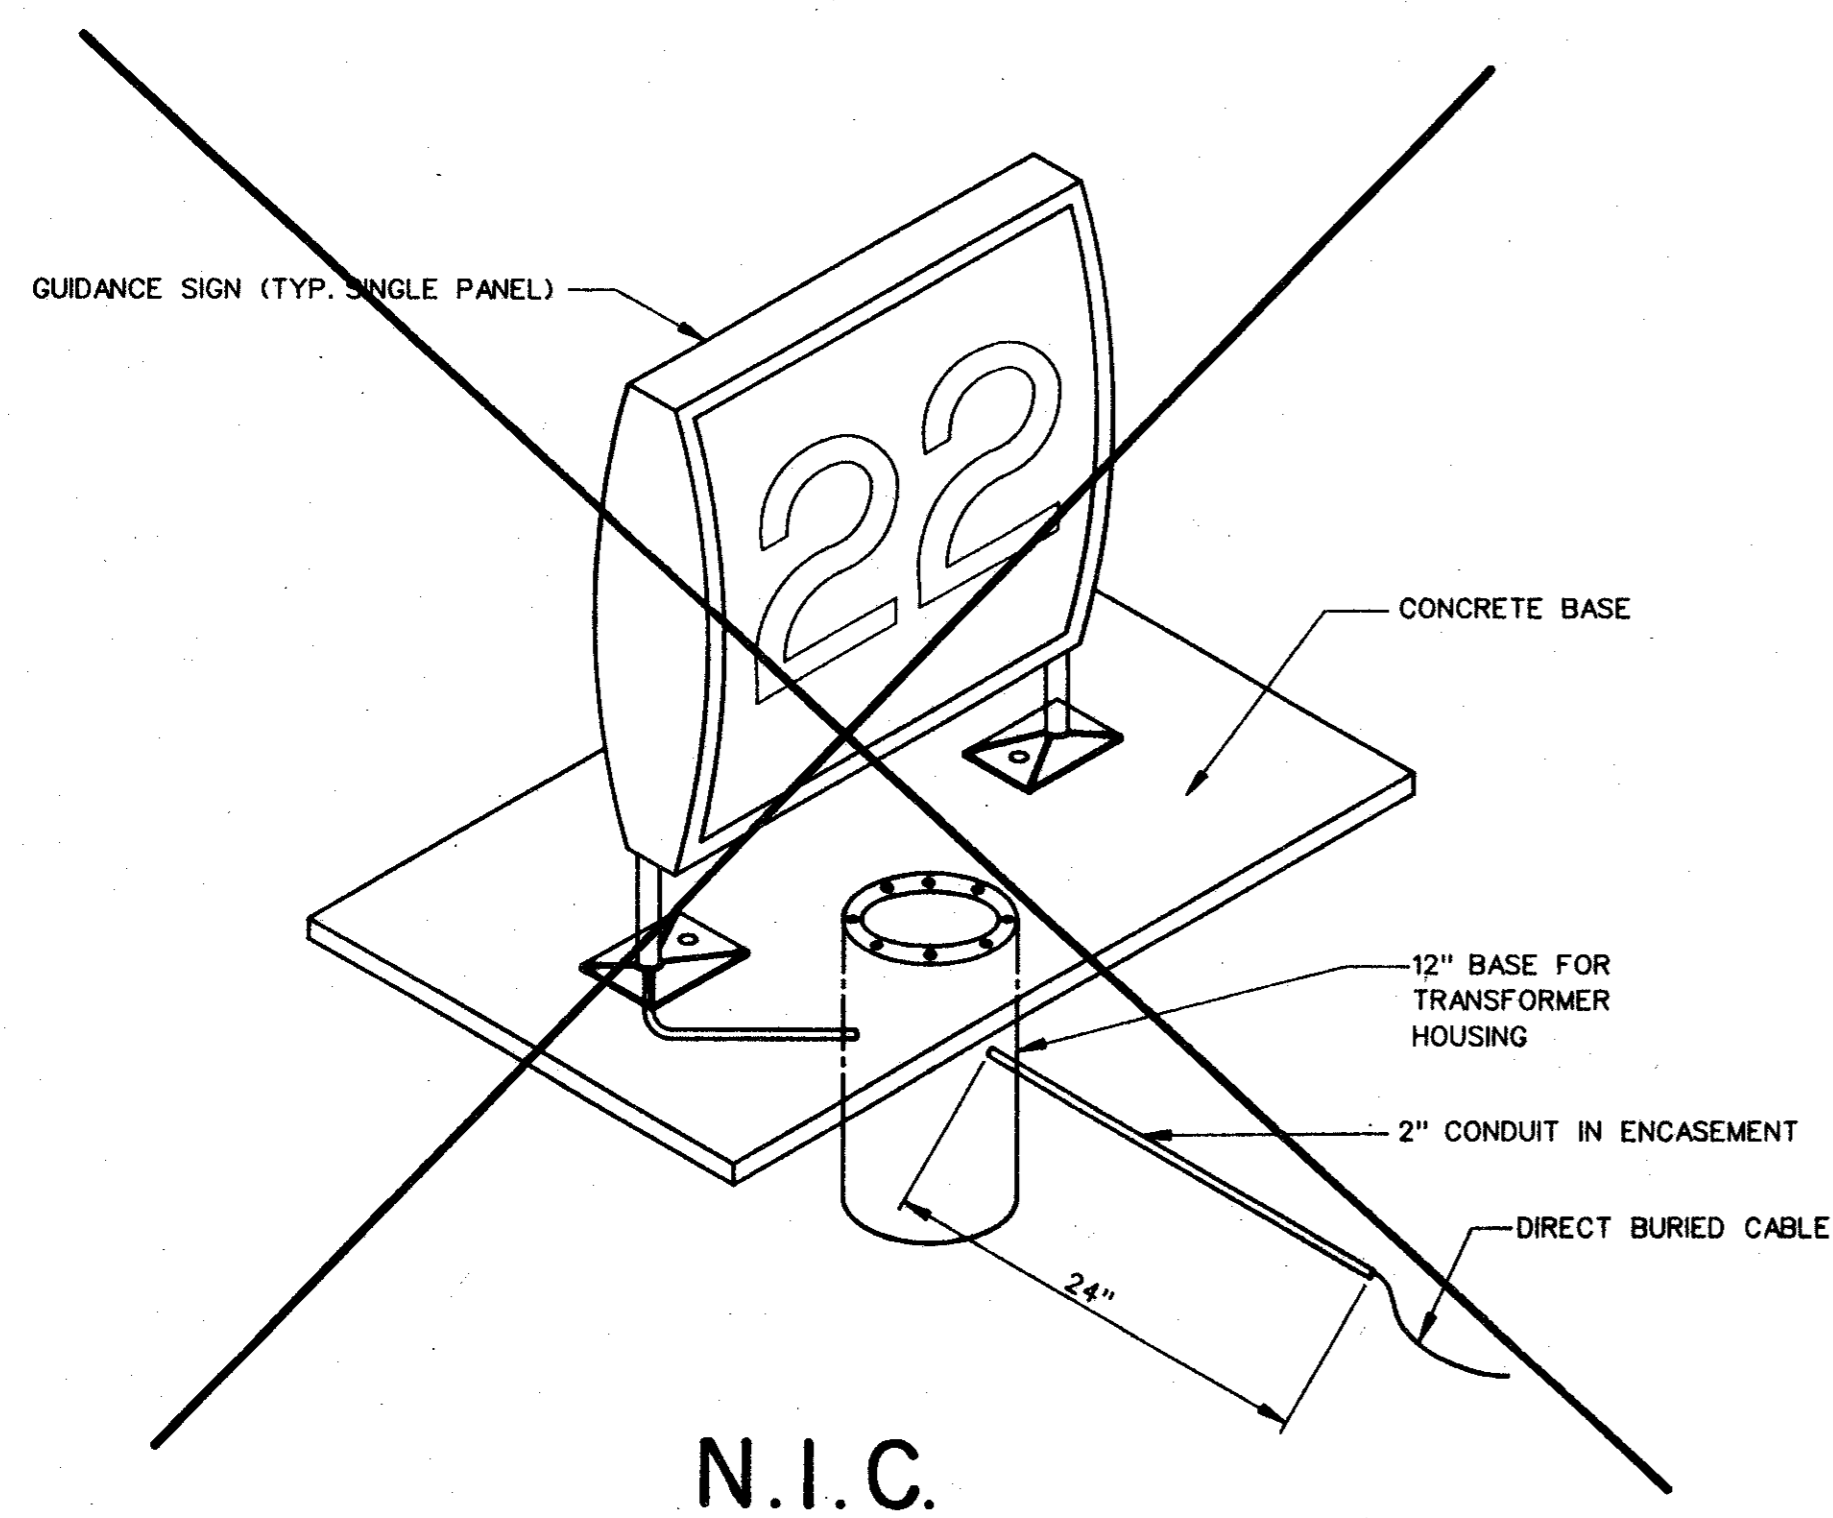

AS BUILT

NOV 10 1993

LD-3

