




WEST ELEVATION
SCALE : 1/4" = 1'

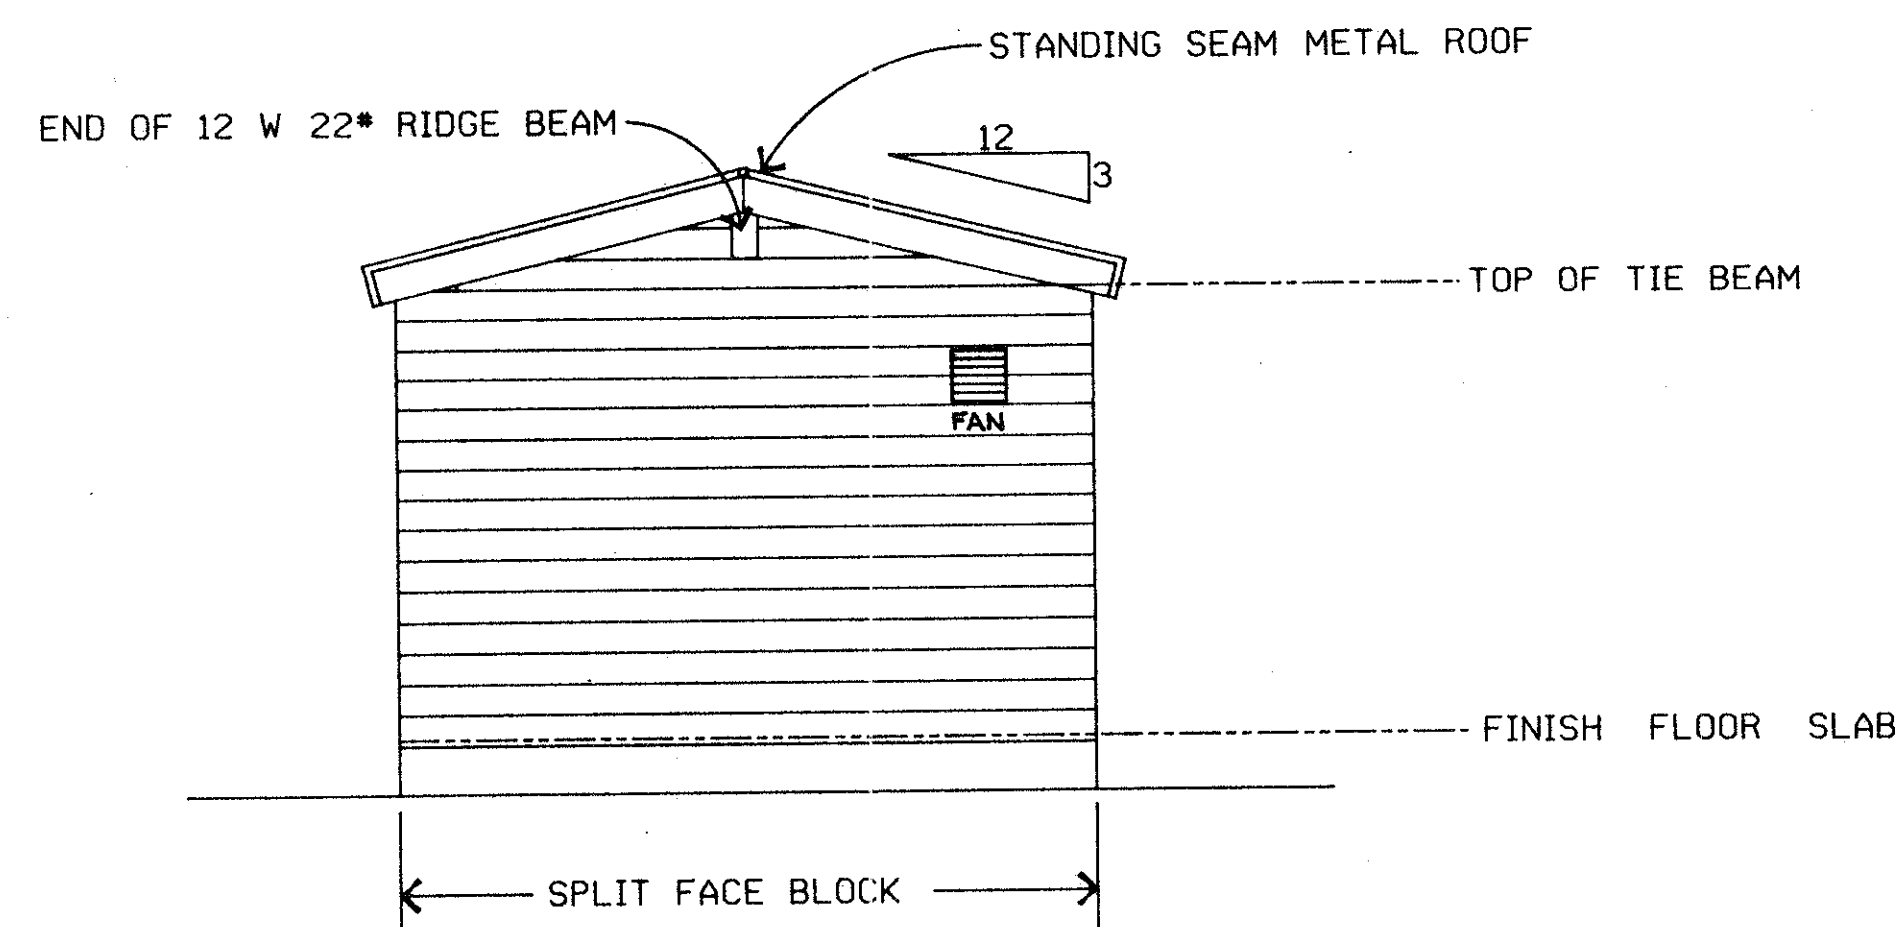


SOUTH ELEVATION
SCALE : 1/4" = 1'

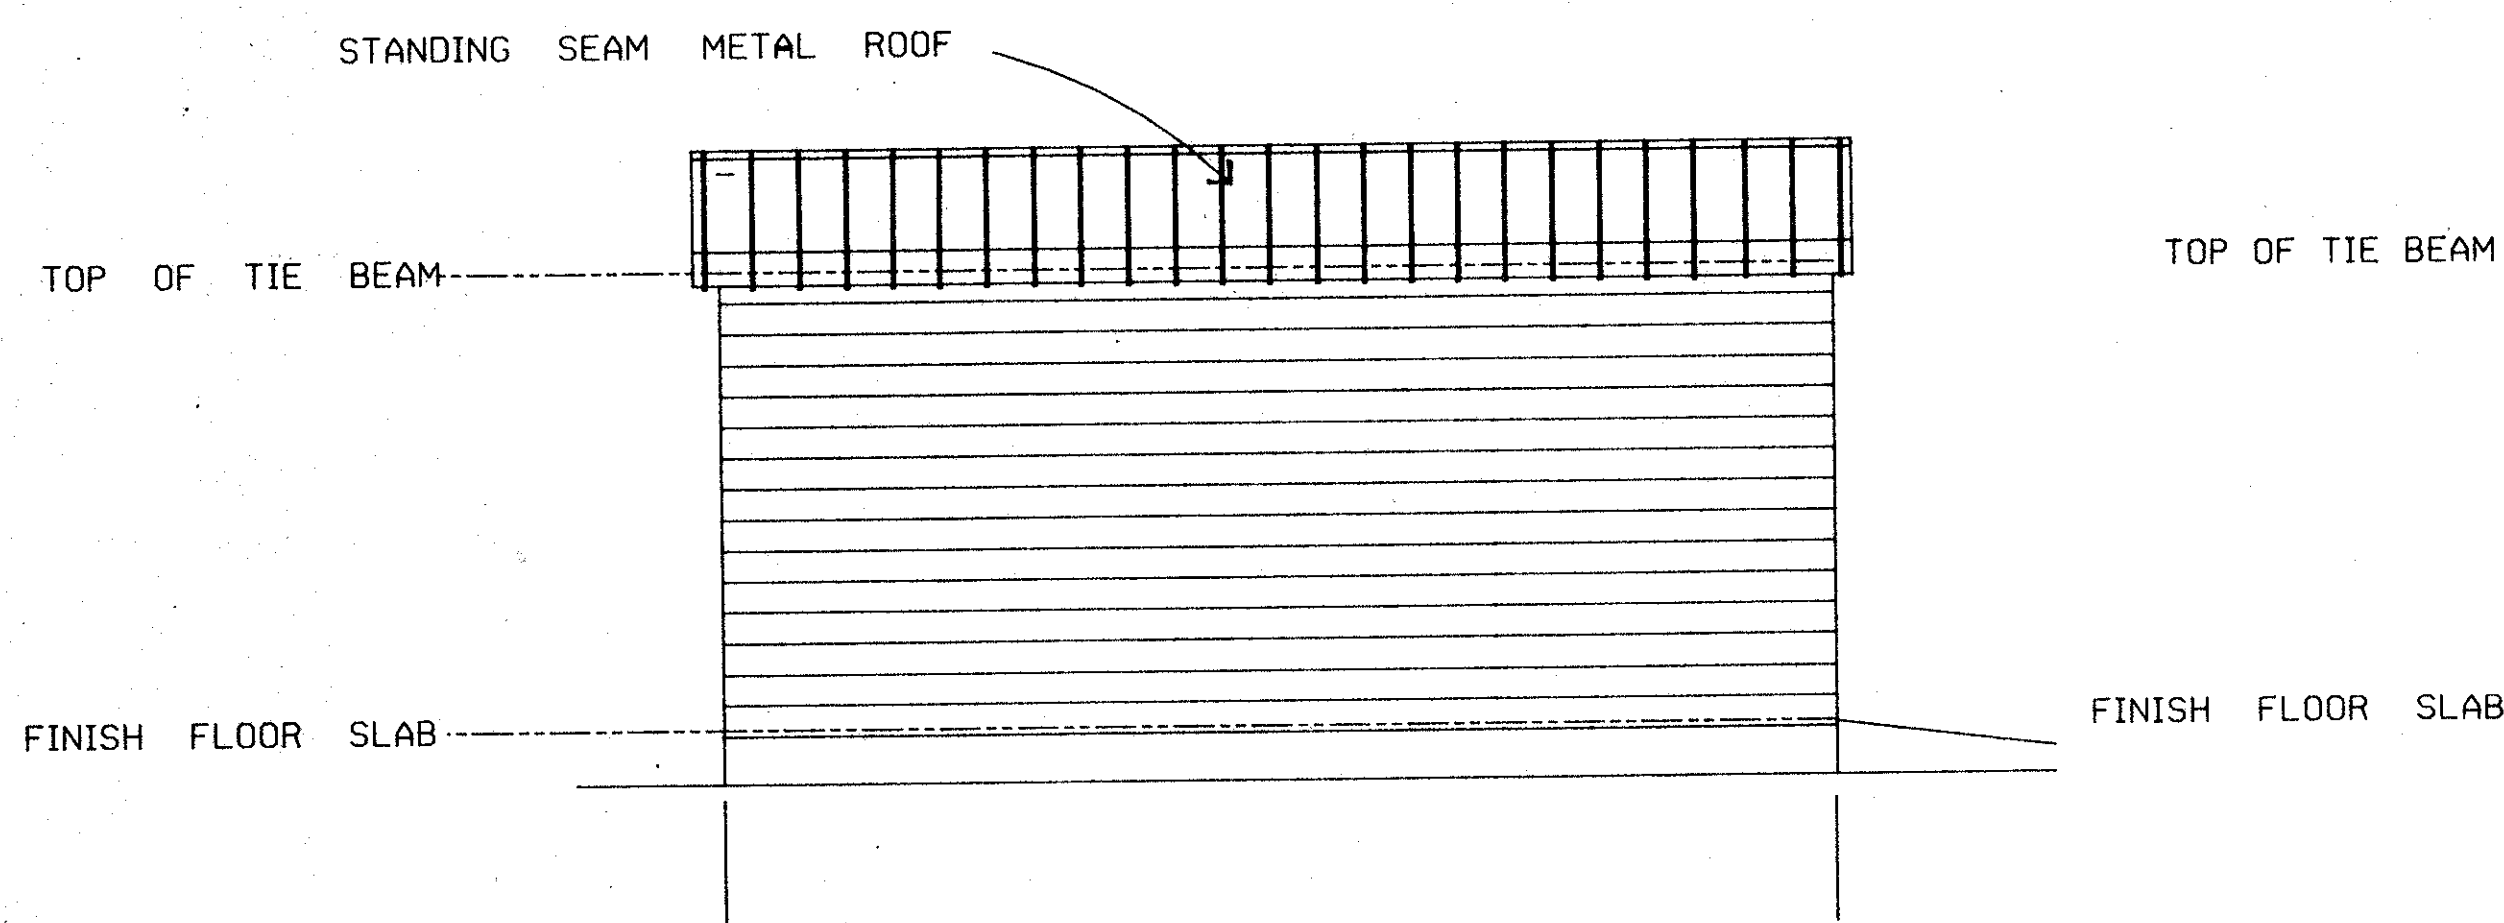

EAST ELEVATION
SCALE : 1/4" = 1'

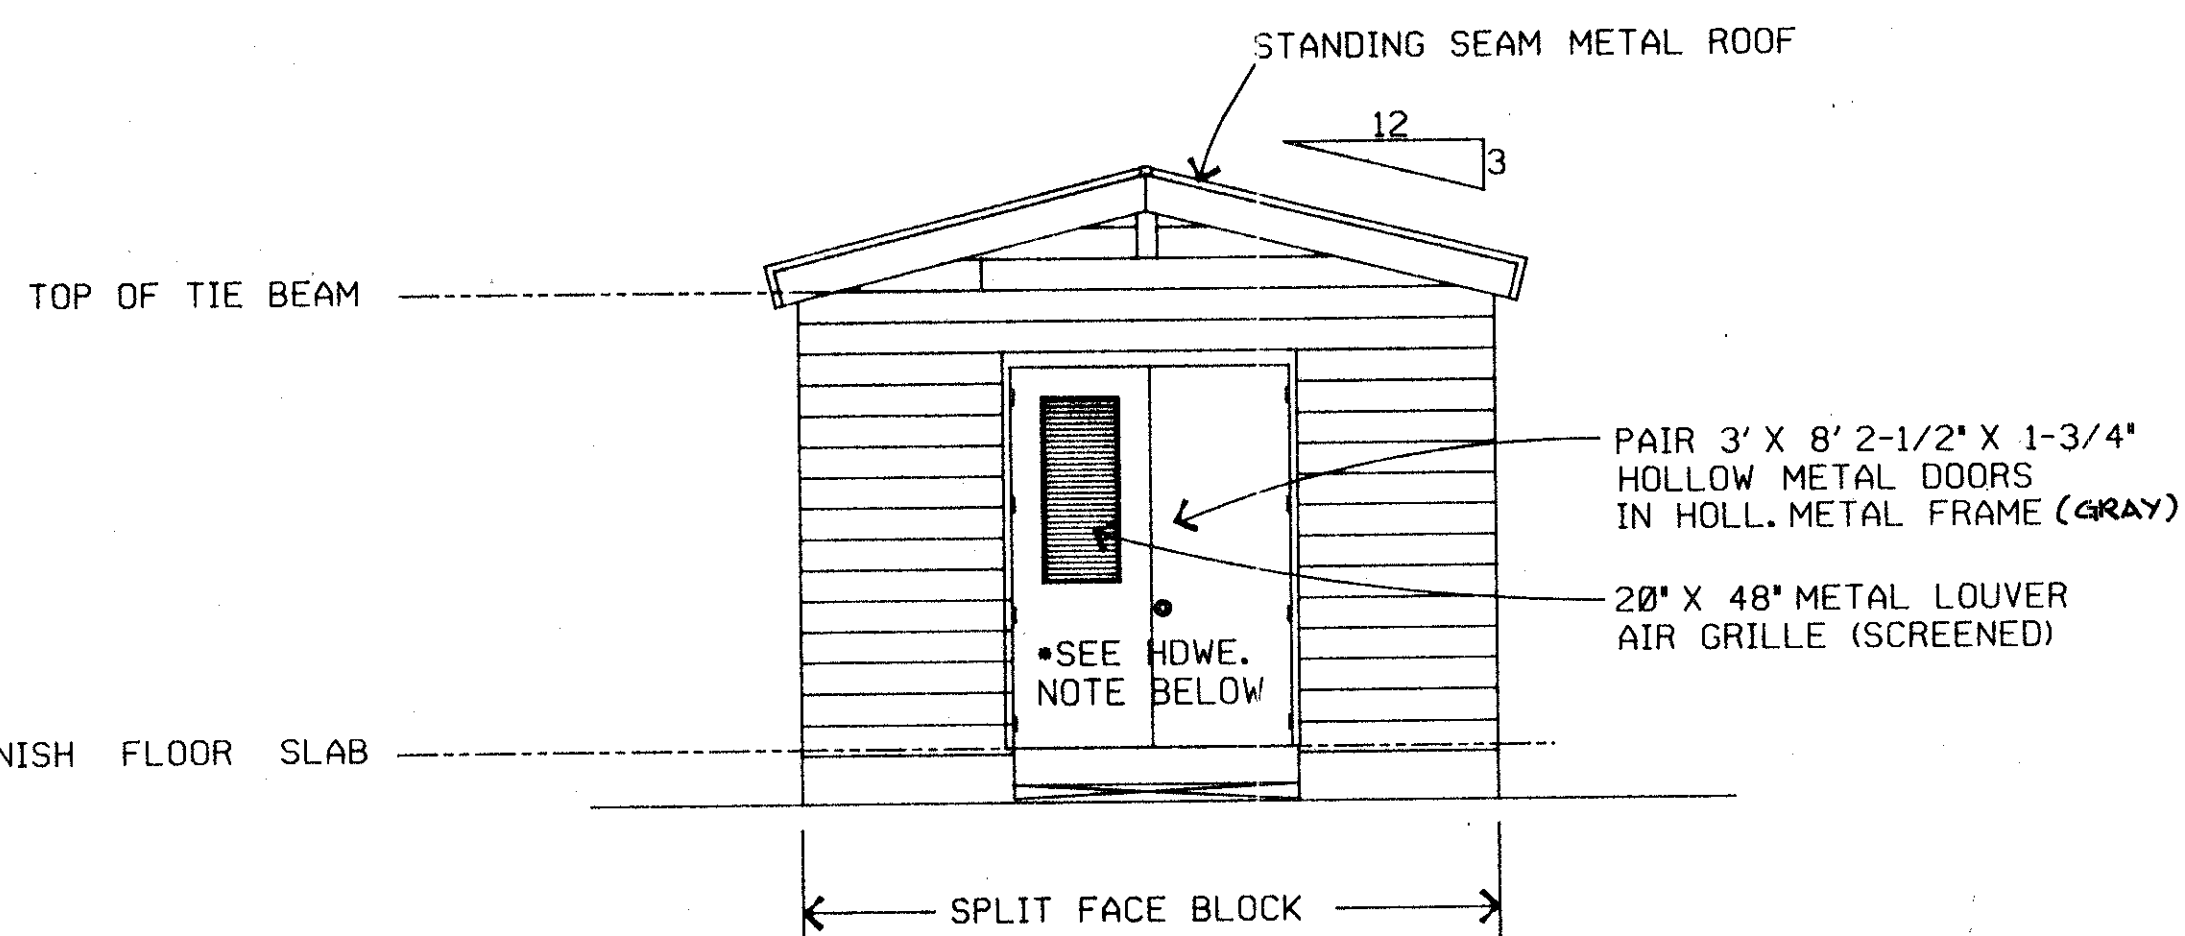

NORTH ELEVATION
SCALE : 1/4" = 1'

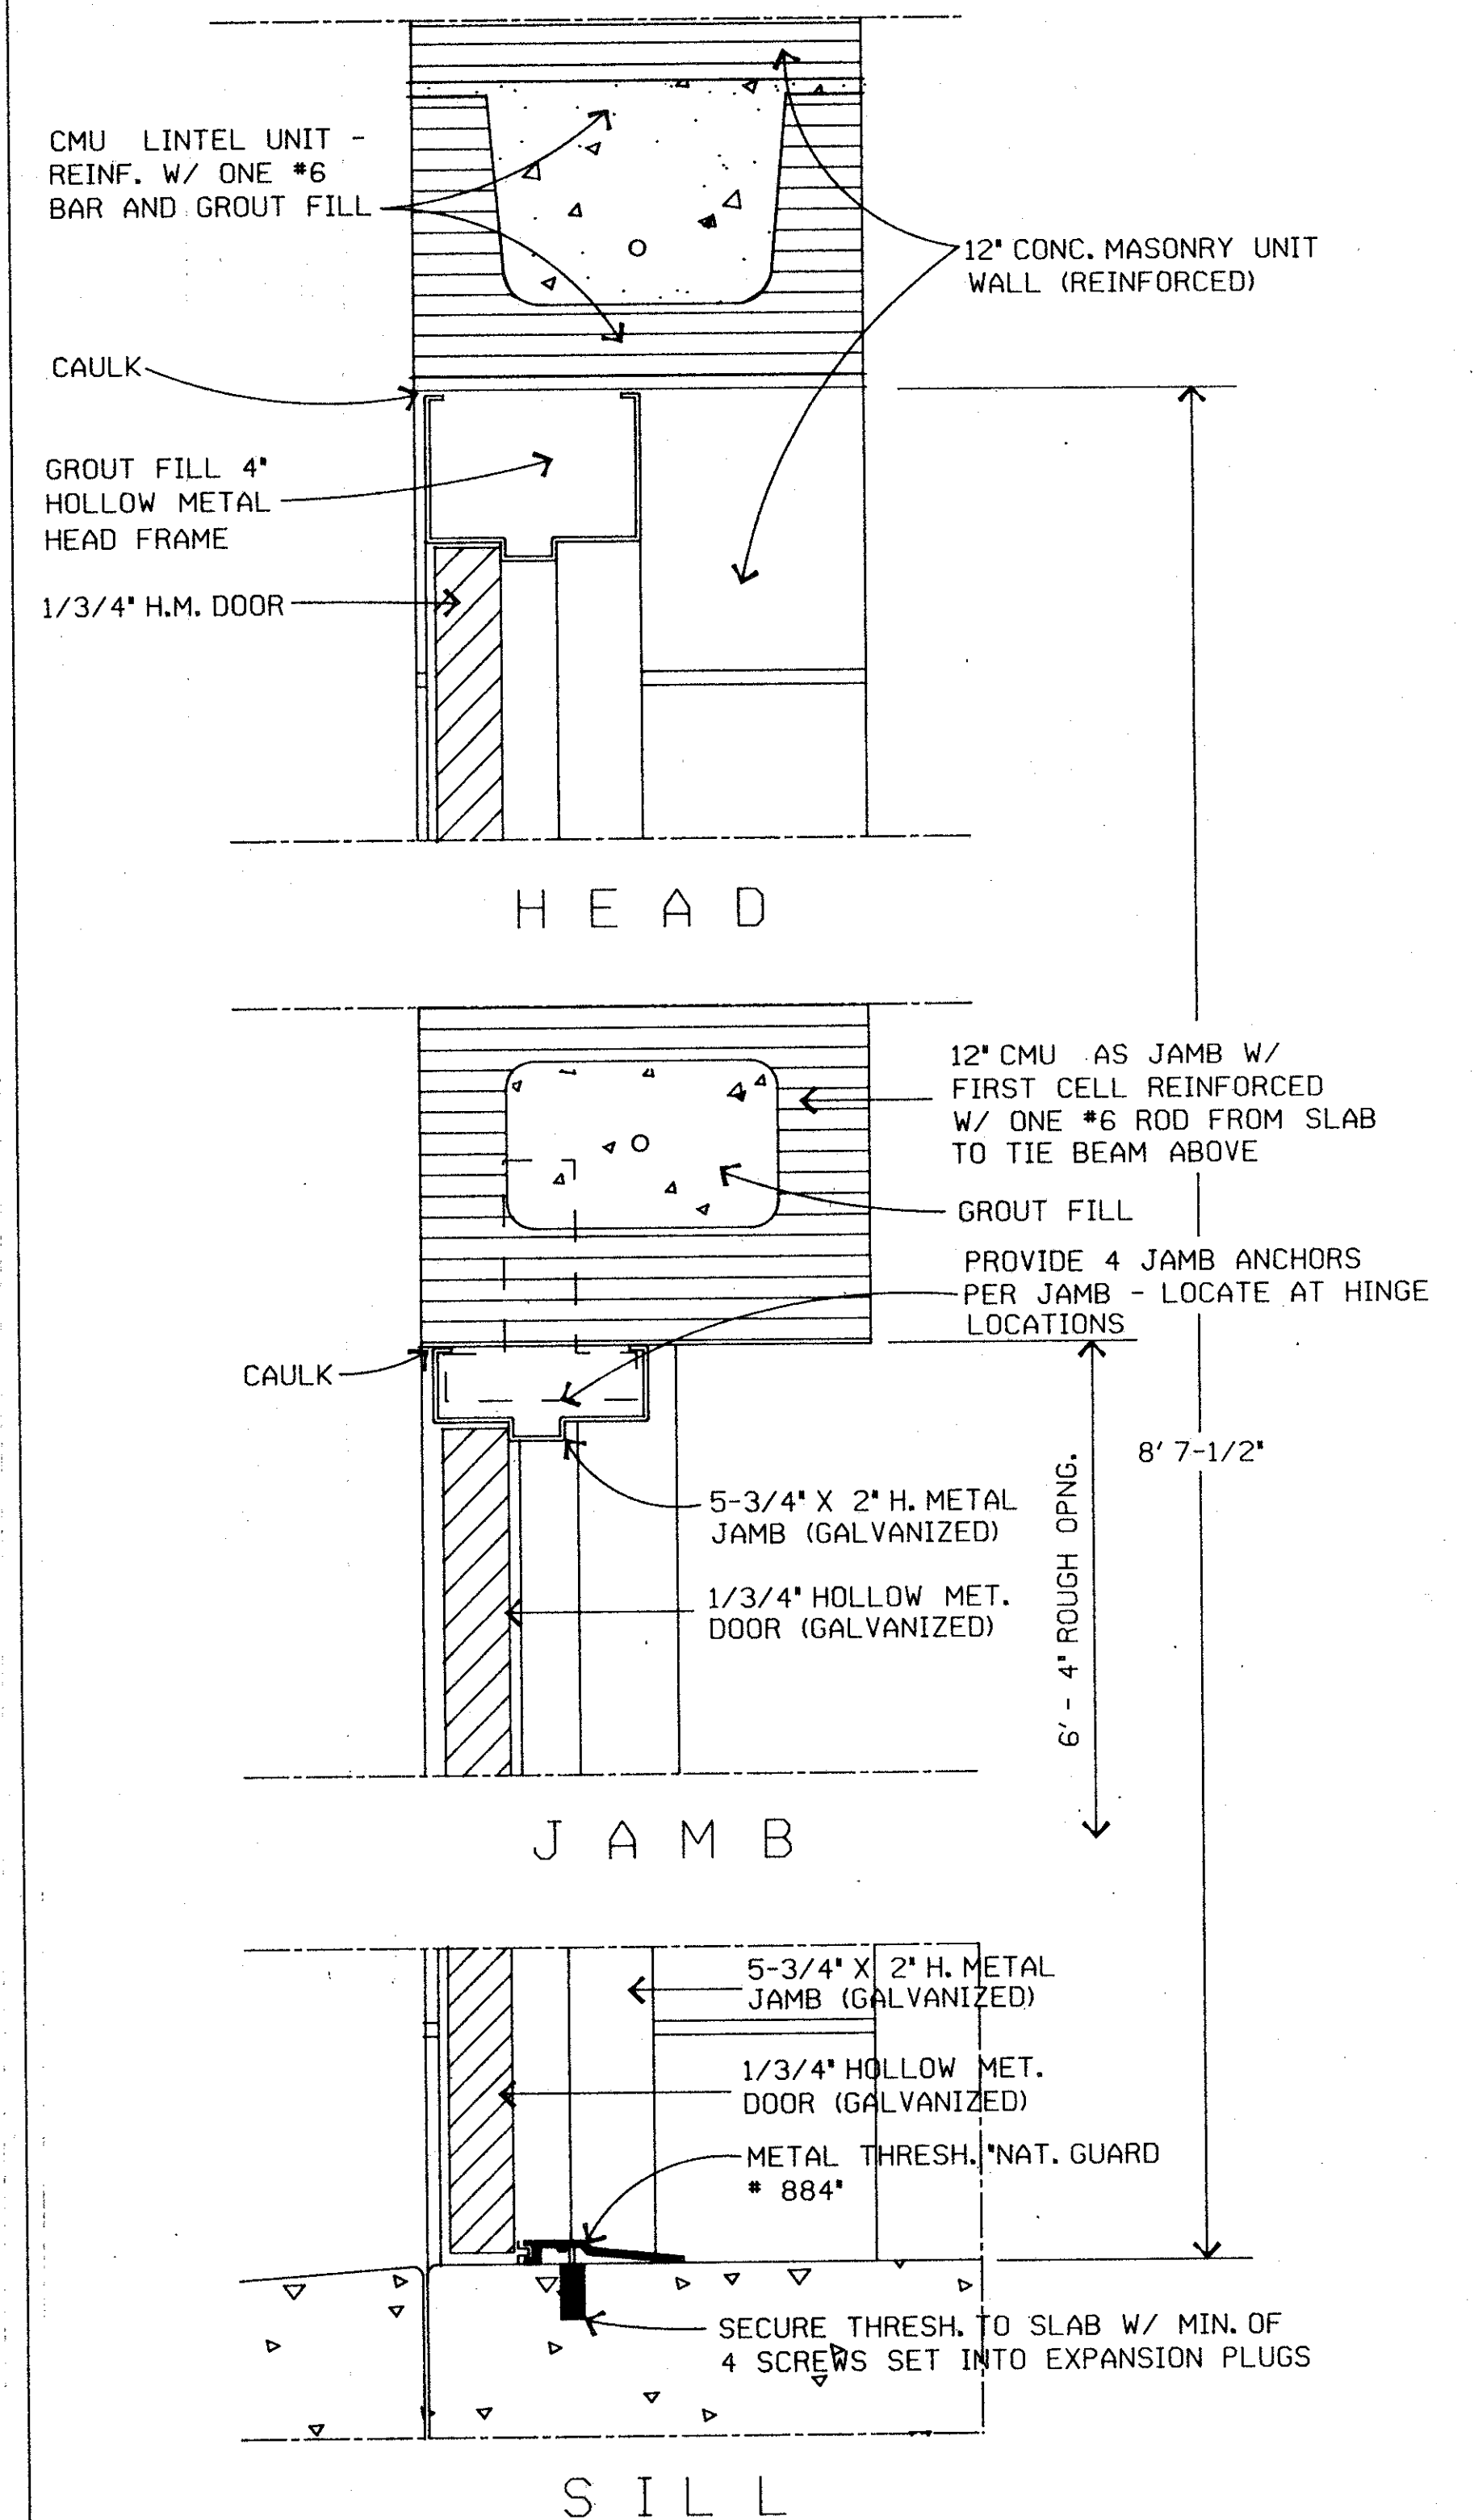


DOOR DETAILS
SCALE : 3" = 1'

• DOOR HARDWARE SCHEDULE : (1 PR. H.M. DOORS)

1.	4 PR. BUTTS	A8111	4-1/2 X 4-1/2	626
2.	1 EA. LOCKSET	SERIES 1000	GRADE 1, F04	
3.	2 EA. FLUSH BOLTS	L04081		626
4.	2 EA. OVERHEAD STOPS	C08511		
5.	1 SET WEATHERSTRIP		NAT. GUARD # 160A	
6.	1 EA. THRESHOLD		NAT. GUARD # 884	

AS BUILT

NOV 10 1993

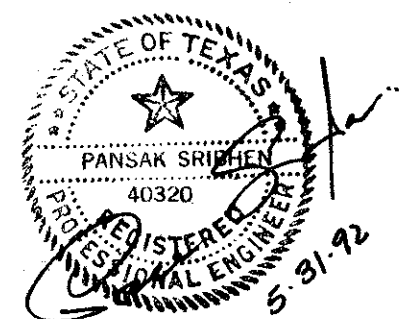

LV - 1

C:\DGN\ADS\ADSBORDE.DGN

DESIGN: PSA ENGINEERING	A.I.P. NO. 3-48-0063-04-92		
DRAWN: PSA ENGINEERING	BID NO. 92-29		
CHECKED: P. SRIBHEN	JOB NO. PSA 9205	Date	Revisions
SCALE:		By	

Greiner Fort Worth, Texas
Engineers, Architects
and Planners

In Association With
ASA ENGINEERING DALLAS, TEXAS



ADDISON AIRPORT

AIRFIELD LIGHTING IMPROVEMENTS
ELECTRICAL VAULT ELEVATIONS

SHEET 32
DATE: JUNE, 1992