
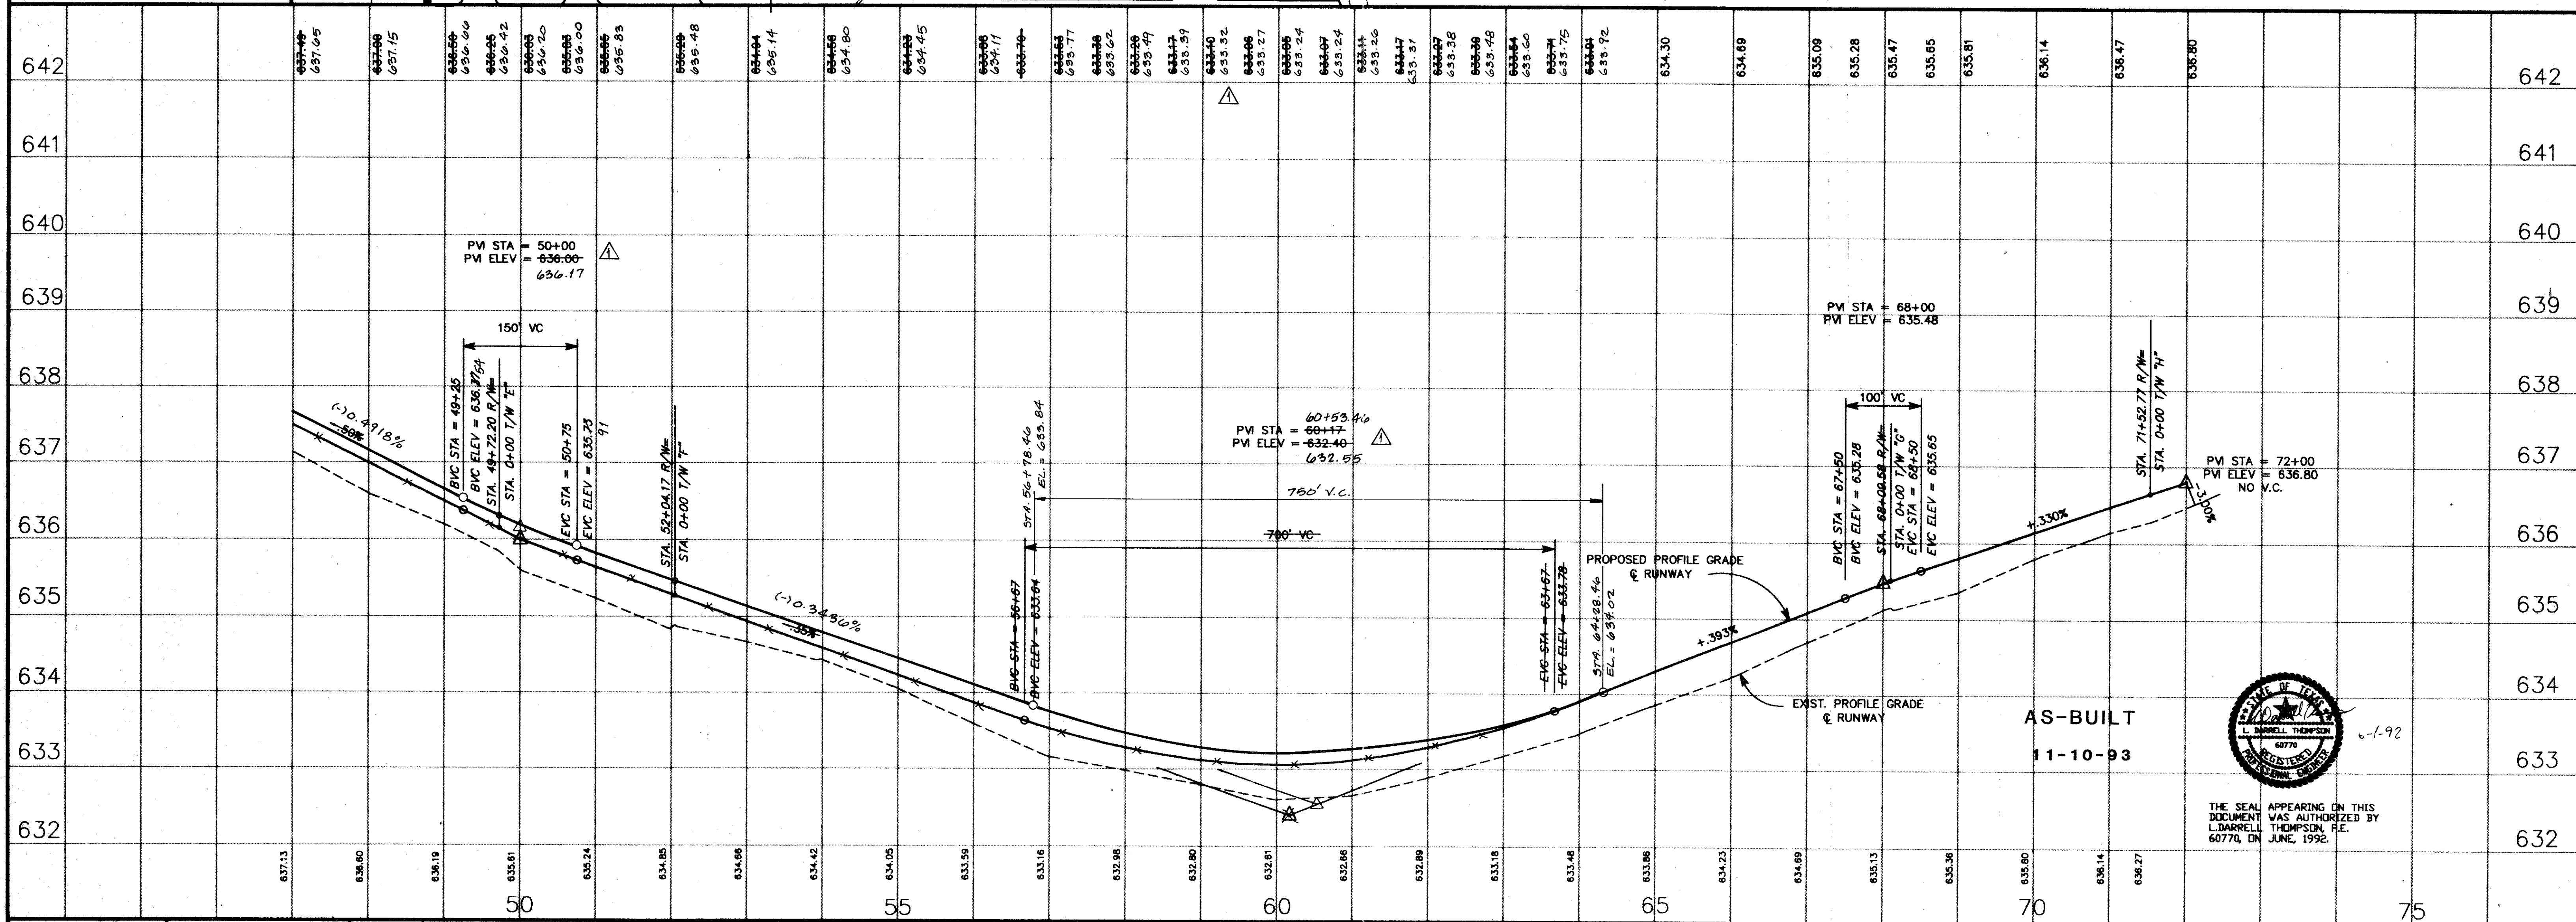


LEGEND

- EXIST. R/W LIGHTS
- - - EXIST. CONTOURS
- PROP. CONTOURS

MATCH LINE STA. 47 + 00

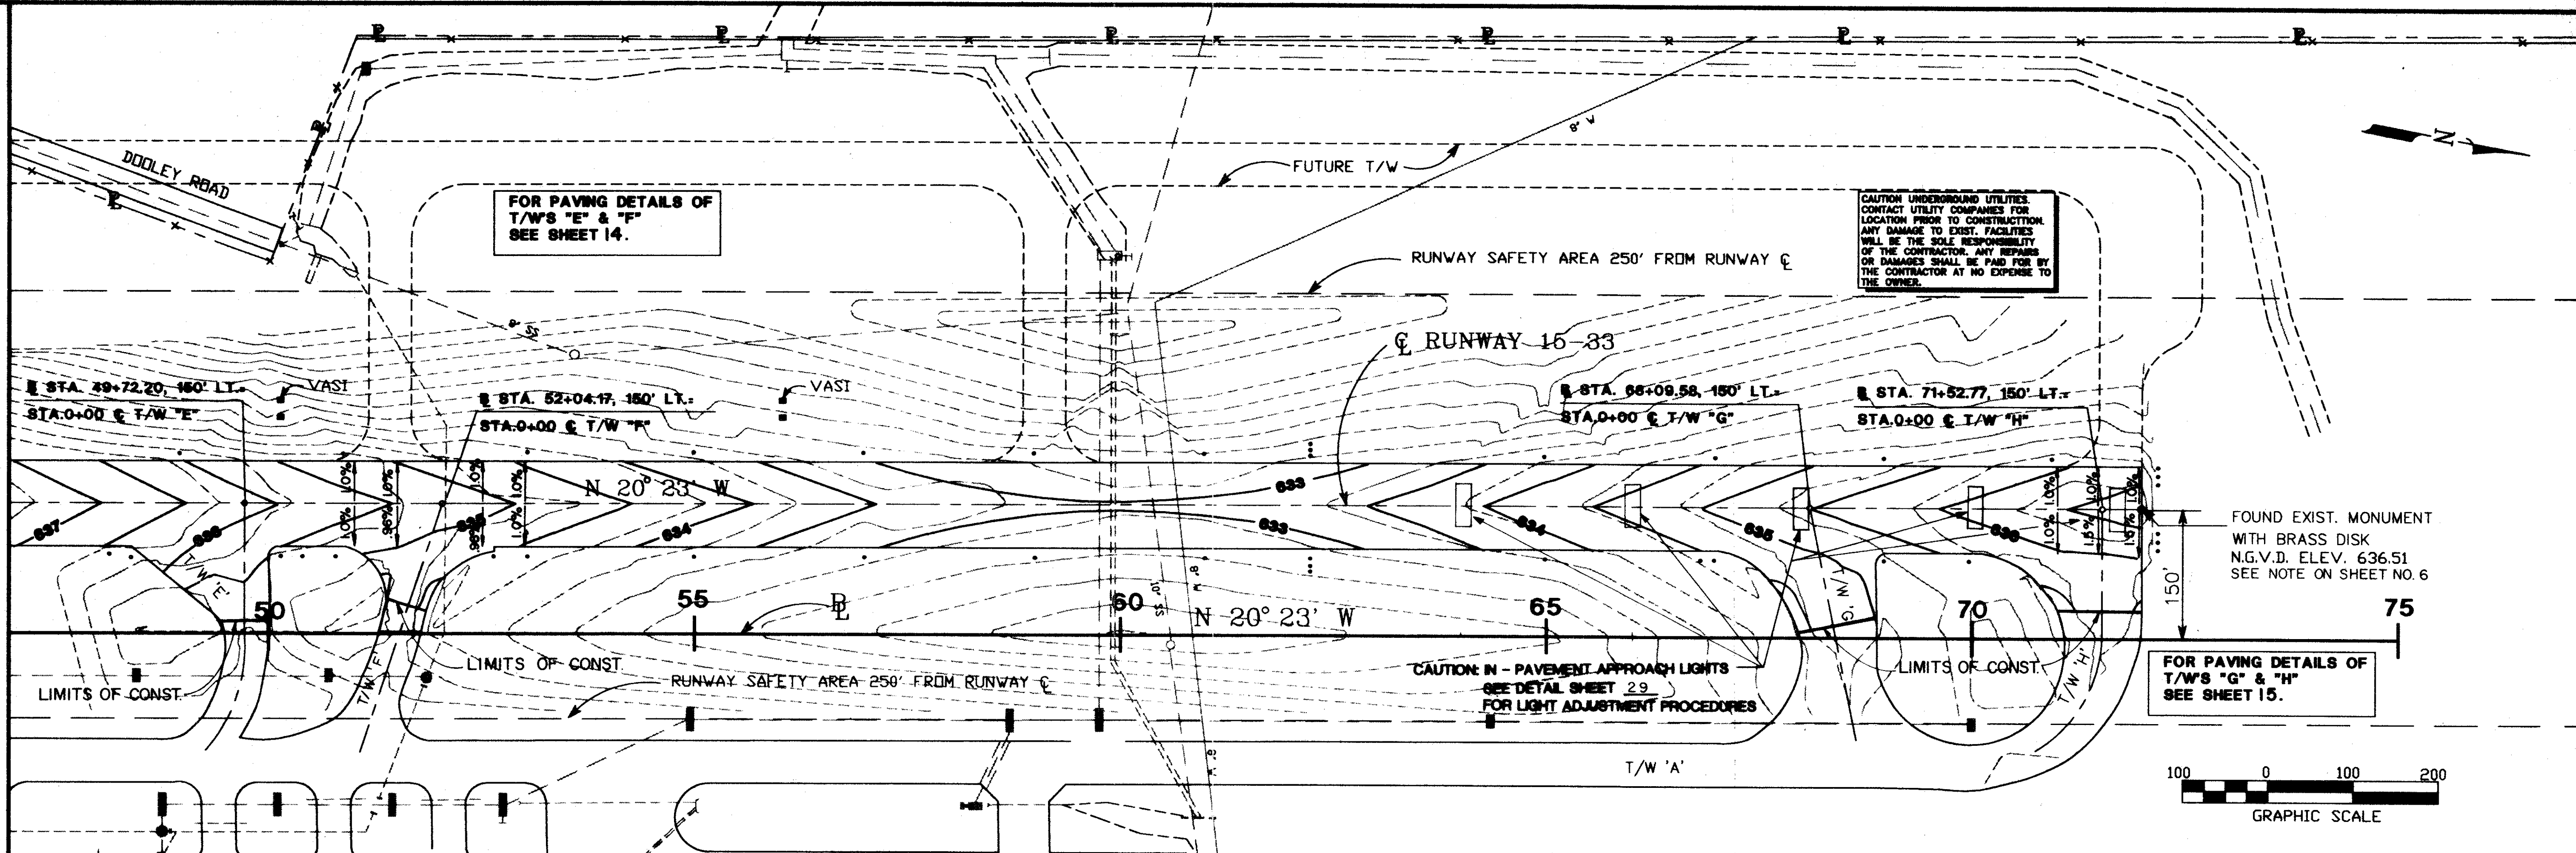

DESIGN: J.C. DRAWN: M.G. CHECKED: D.T. SCALE: 1" = 100' HORIZ. 1" = 1' VERT.	A.I.P. NO. 3-48-0063-04-92 BID NO. 92-25 JOB NO. Y8024.30	9-10-92 FIELD CHANGE #1 Date: _____ Revisions: _____ By: _____	Greiner Engineers, Architects and Planners Fort Worth, Texas	<h1 style="margin: 0;">ADDISON AIRPORT</h1>	<h2 style="margin: 0;">RUNWAY REHABILITATION</h2> <h3 style="margin: 0;">PAVING PLAN</h3> <p style="margin: 0;">PAVING PLAN AND PROFILES—STA. 47+00 TO STA. 72+00</p>	SHEET 8 <small>DATE: 09/11/98</small>
--	---	--	--	---	---	--