




RECONSTRUCTED WITH PROJECT A.I.P. 3-48-0063-05

LEGEND

EXIST. PAVEMENT TO BE MILLED

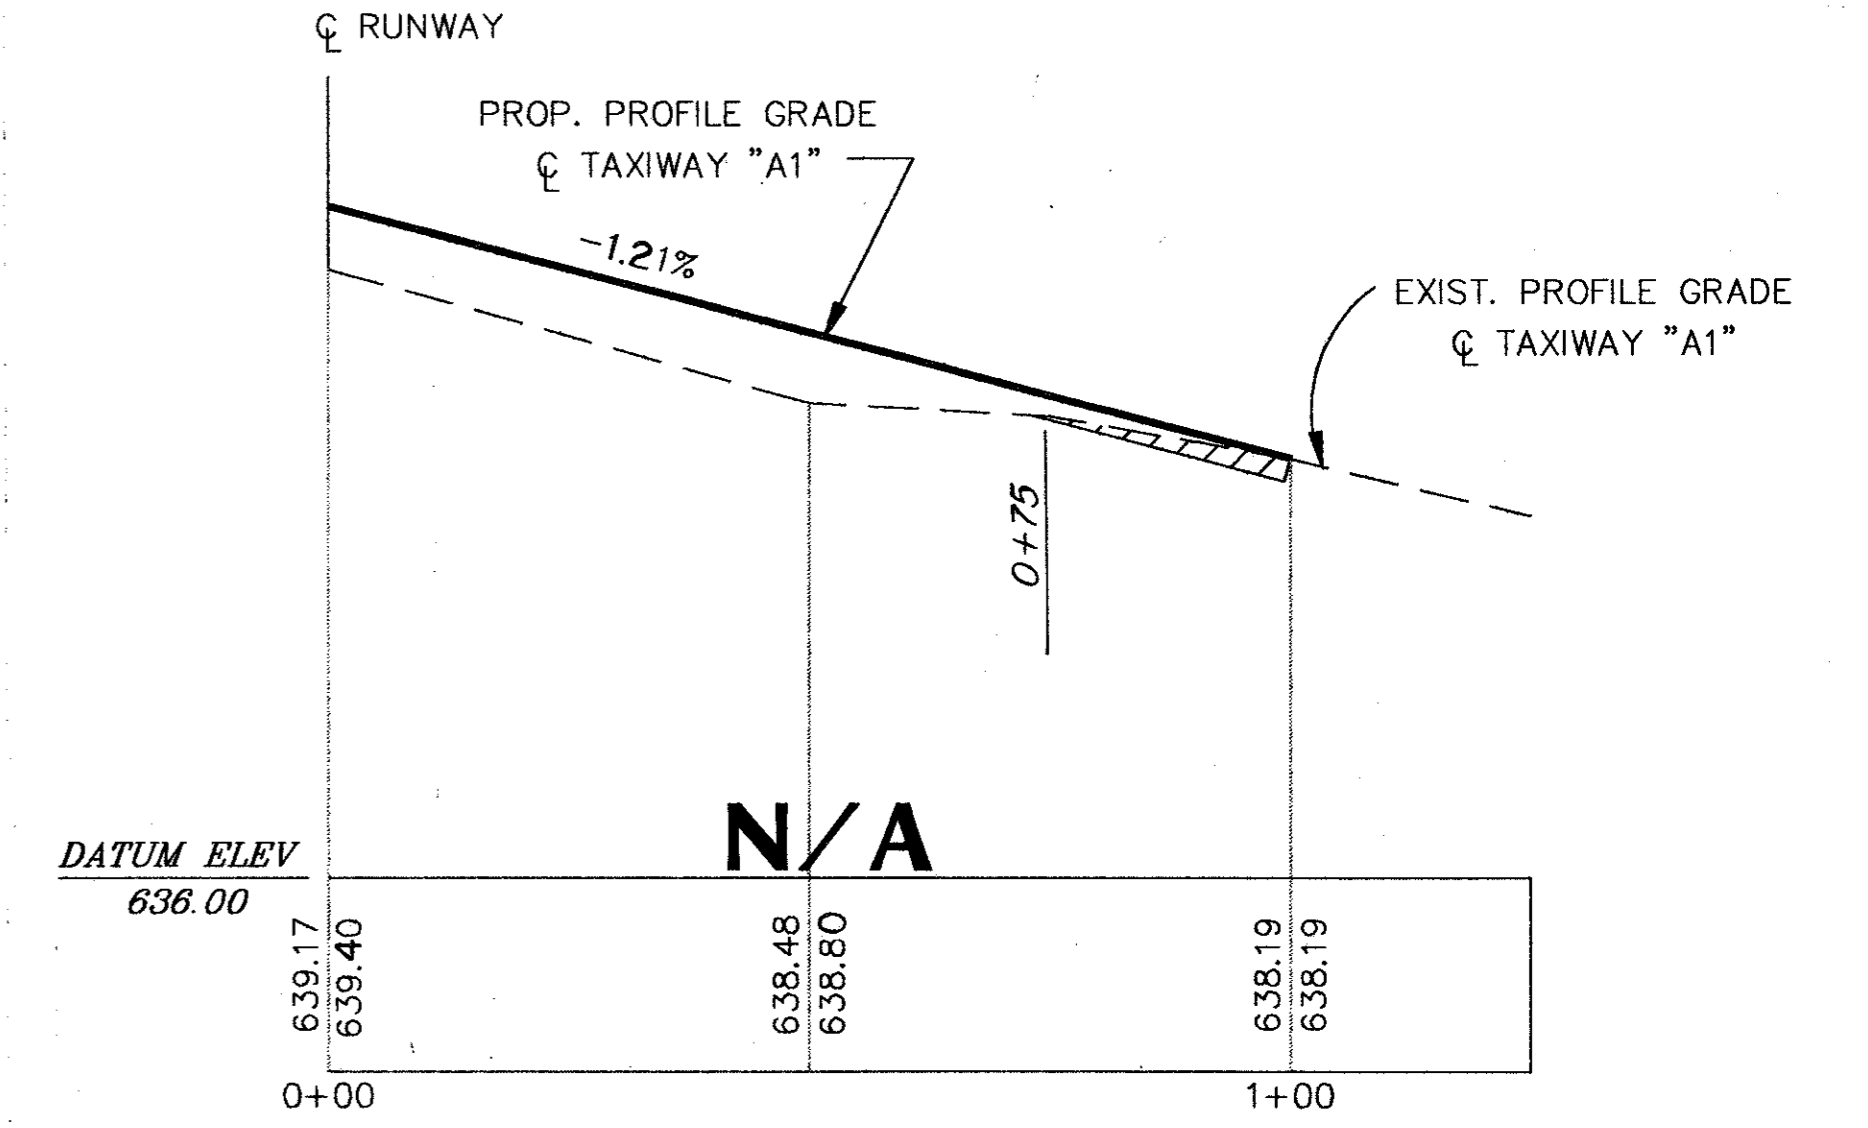


RECONSTRUCTED WITH PROJECT A.I.P. 3-48-0063-05

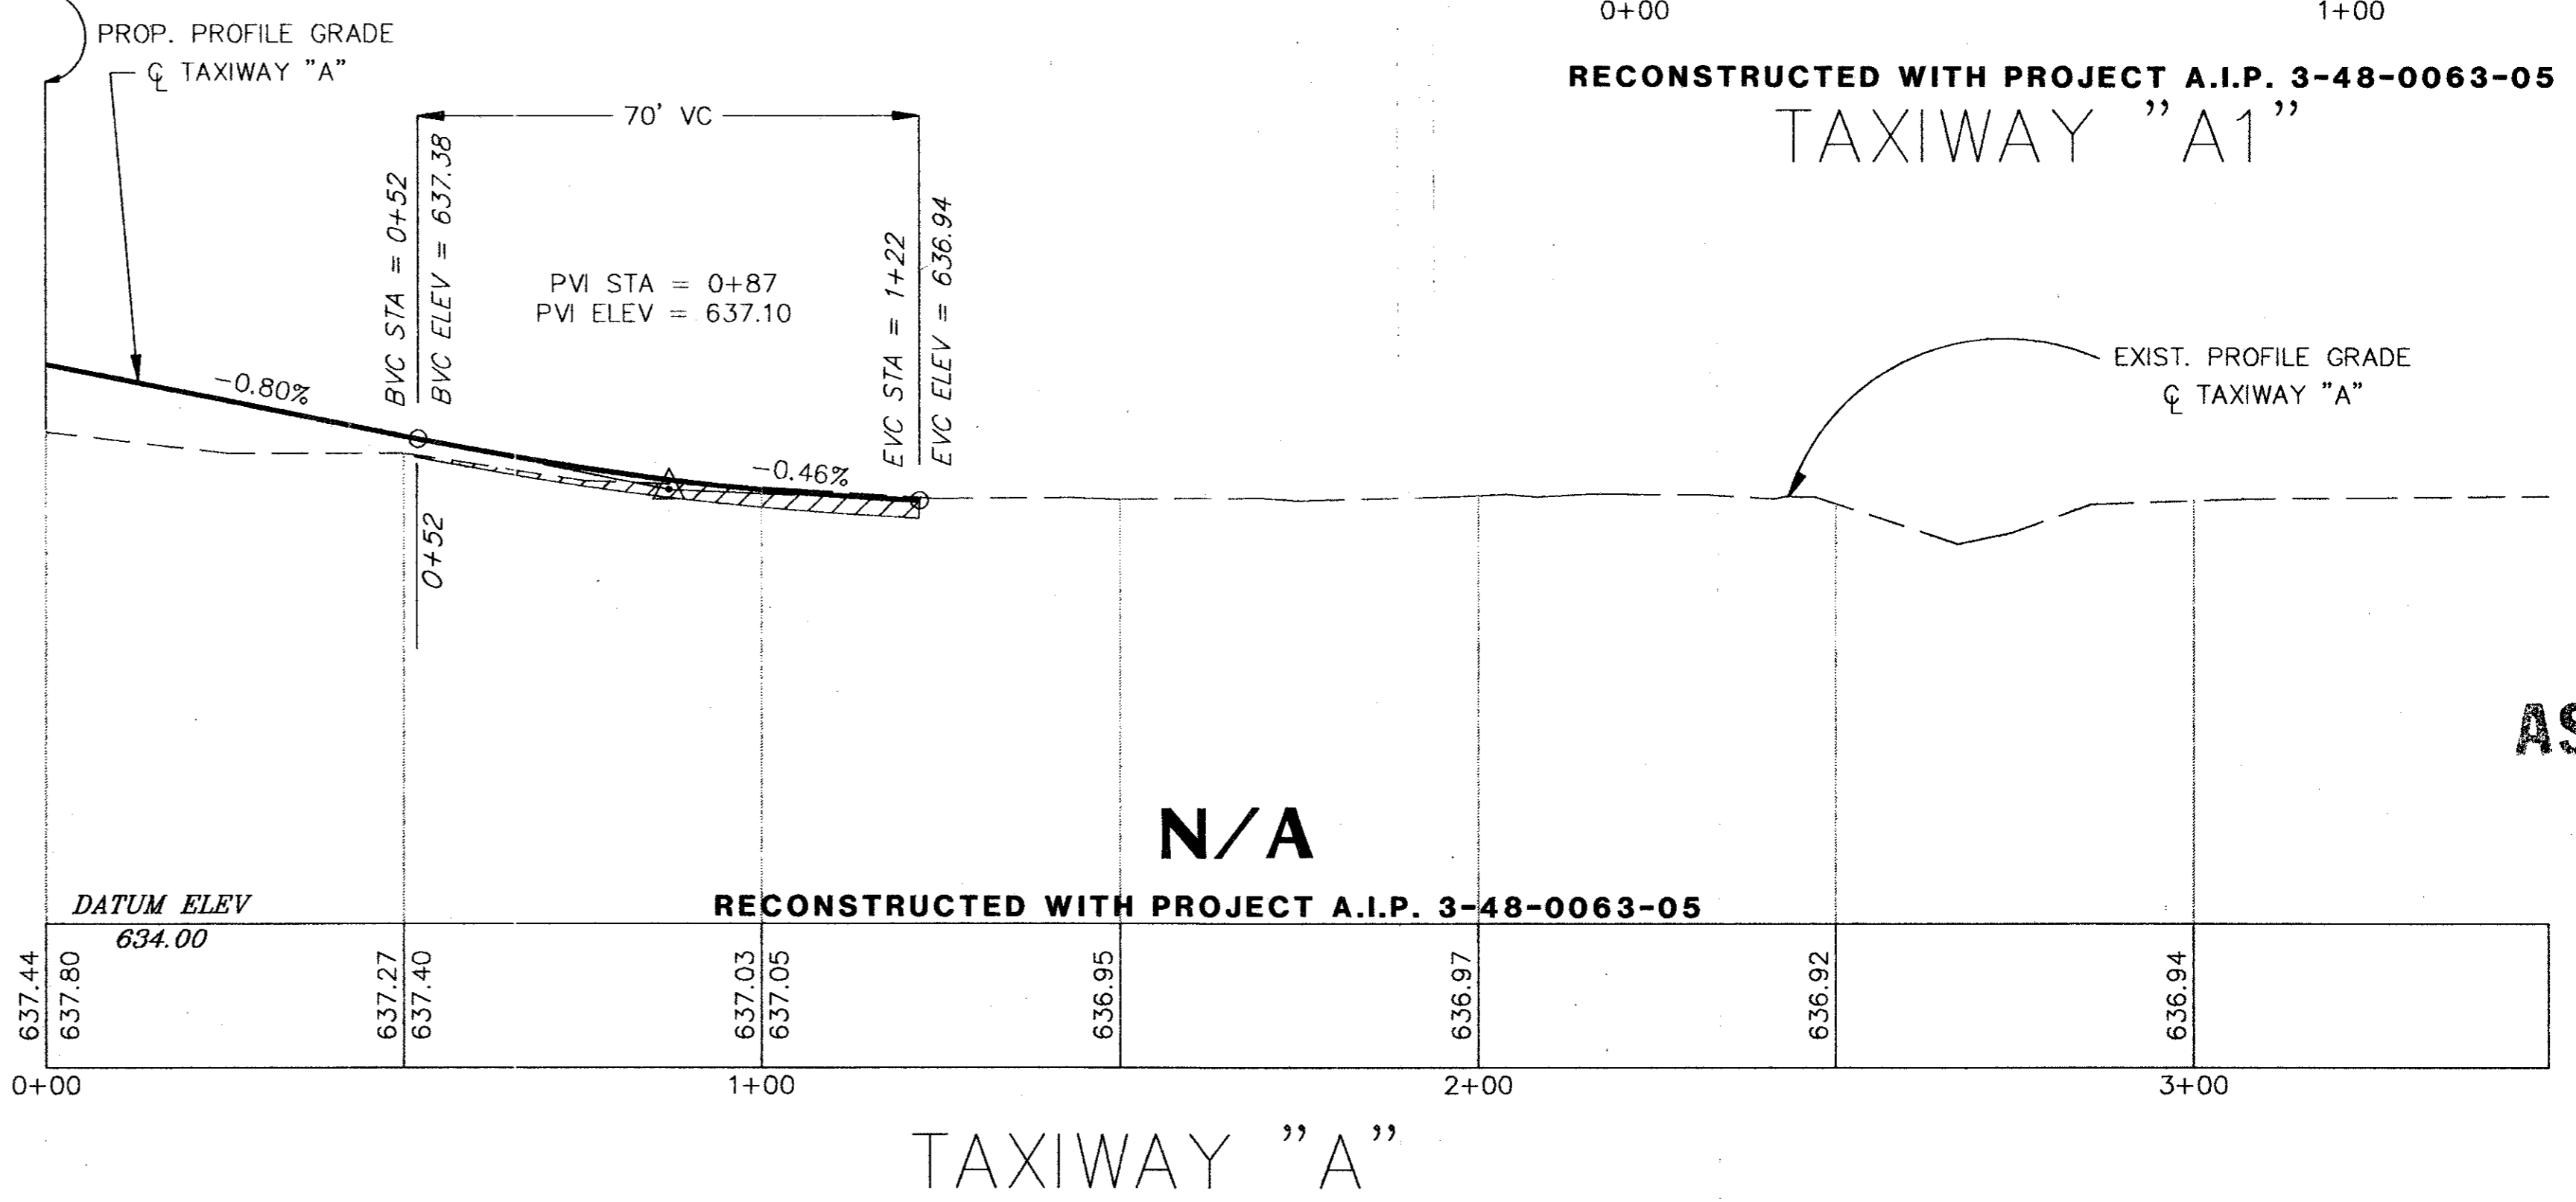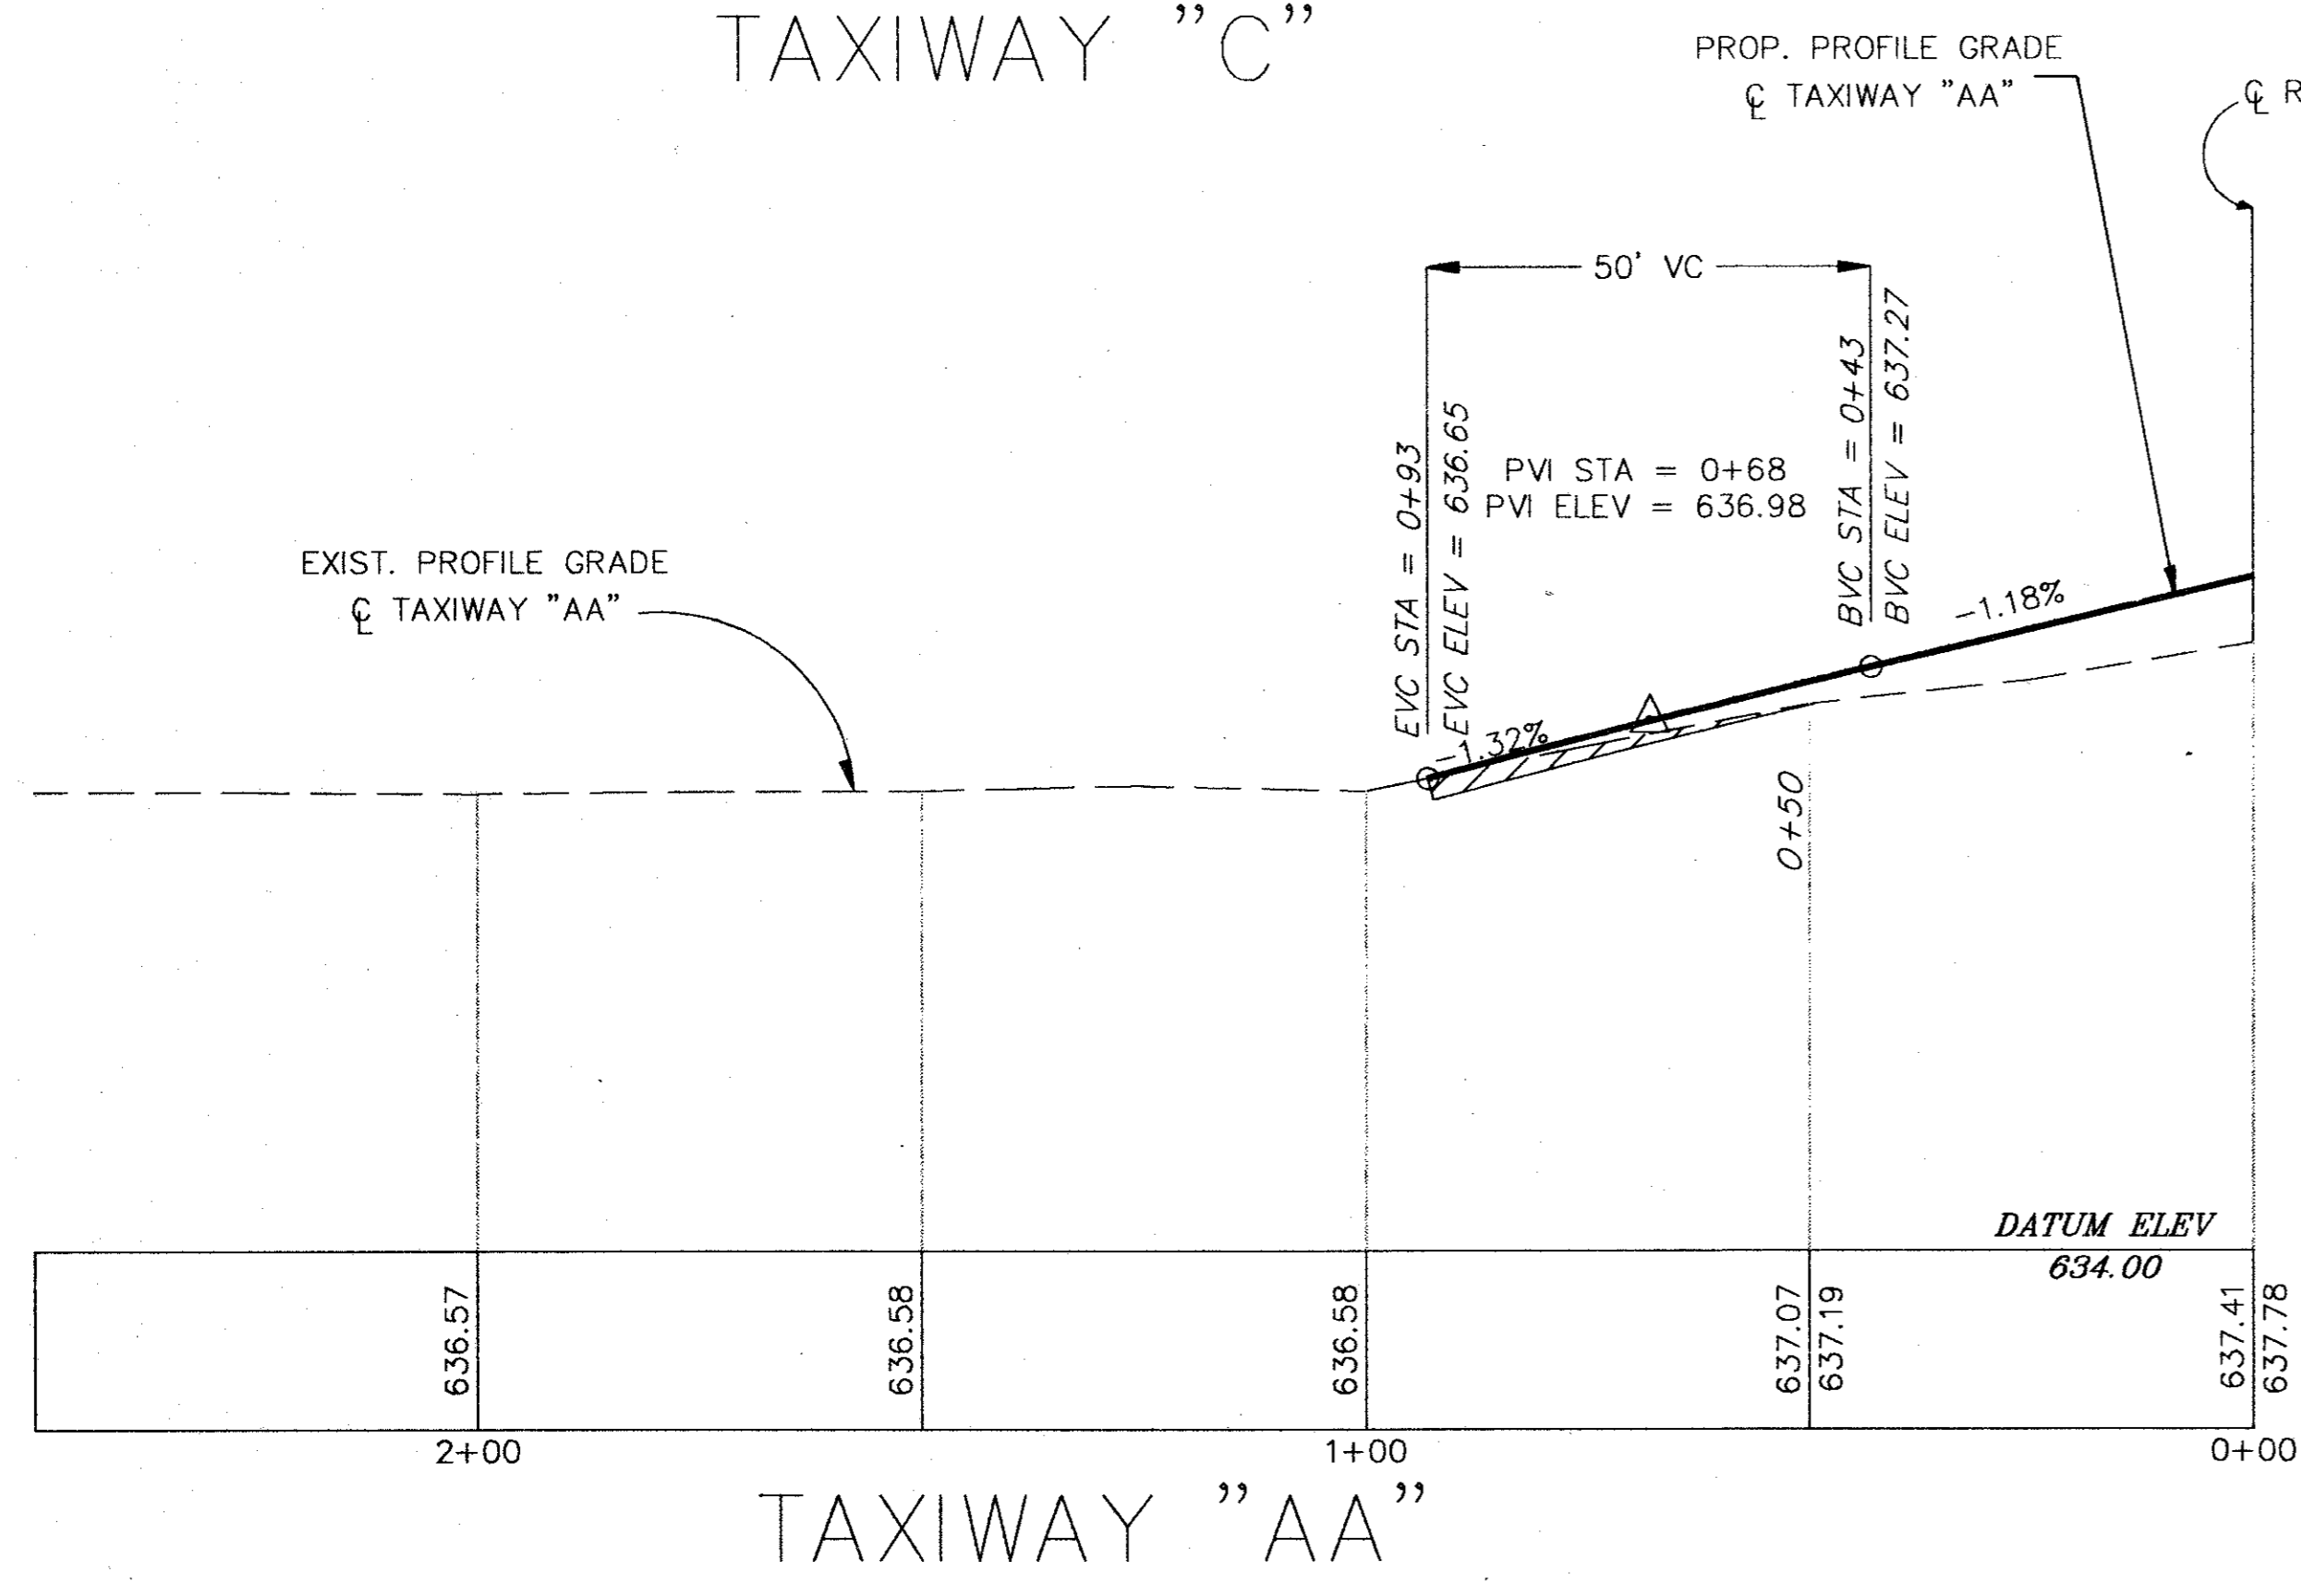

AS BUILT

NOV 10 1993

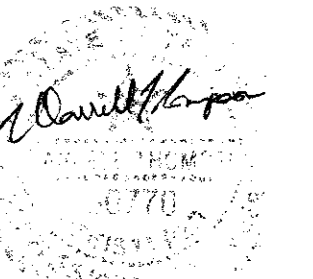

DESIGN	J.C.
DRAWN	M.C.
CHECKED	D.T.
SCALE	1" = 20' HORIZ. 1" = 1' VERT.
A.I.P. NO.	3-48-0063-04-92
BID NO.	92-29
JOB NO.	Y8024.30
Date	
Revisions	
By	

Greiner
Greiner, Inc.
Fort Worth, Texas

Engineers, Architects
and Planners



ADDISON AIRPORT

**RUNWAY REHABILITATION
TAXIWAY PROFILES**

SHEET
9
DATE: JUNE 1992