



File: L:\2012\12081100 - ADS S-1 Parking Lot\Drawings\ADS_S1P_C105_IP.dwg Last Saved by: Epcichmistelek
 Last Plotted by: Chornistek, Elizabeth G. Plot Date: 6/19/2012 4:58 PM Plotter Used: DWG To PDF.pc3

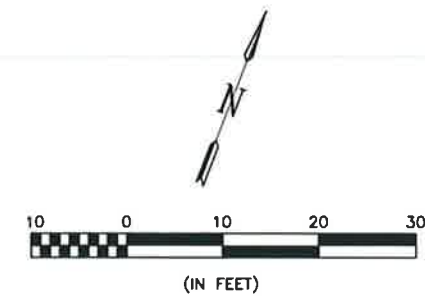

PAVEMENT JOINT LEGEND	
-----	TYPE "A-1" - REINFORCED ISOLATION JOINT
	TYPE "B" - HINGED CONTRACTION JOINT
+	TYPE "C" - DOWELED CONTRACTION JOINT
X	TYPE "E" - DOWELED CONSTRUCTION JOINT

Revised
9/6/12

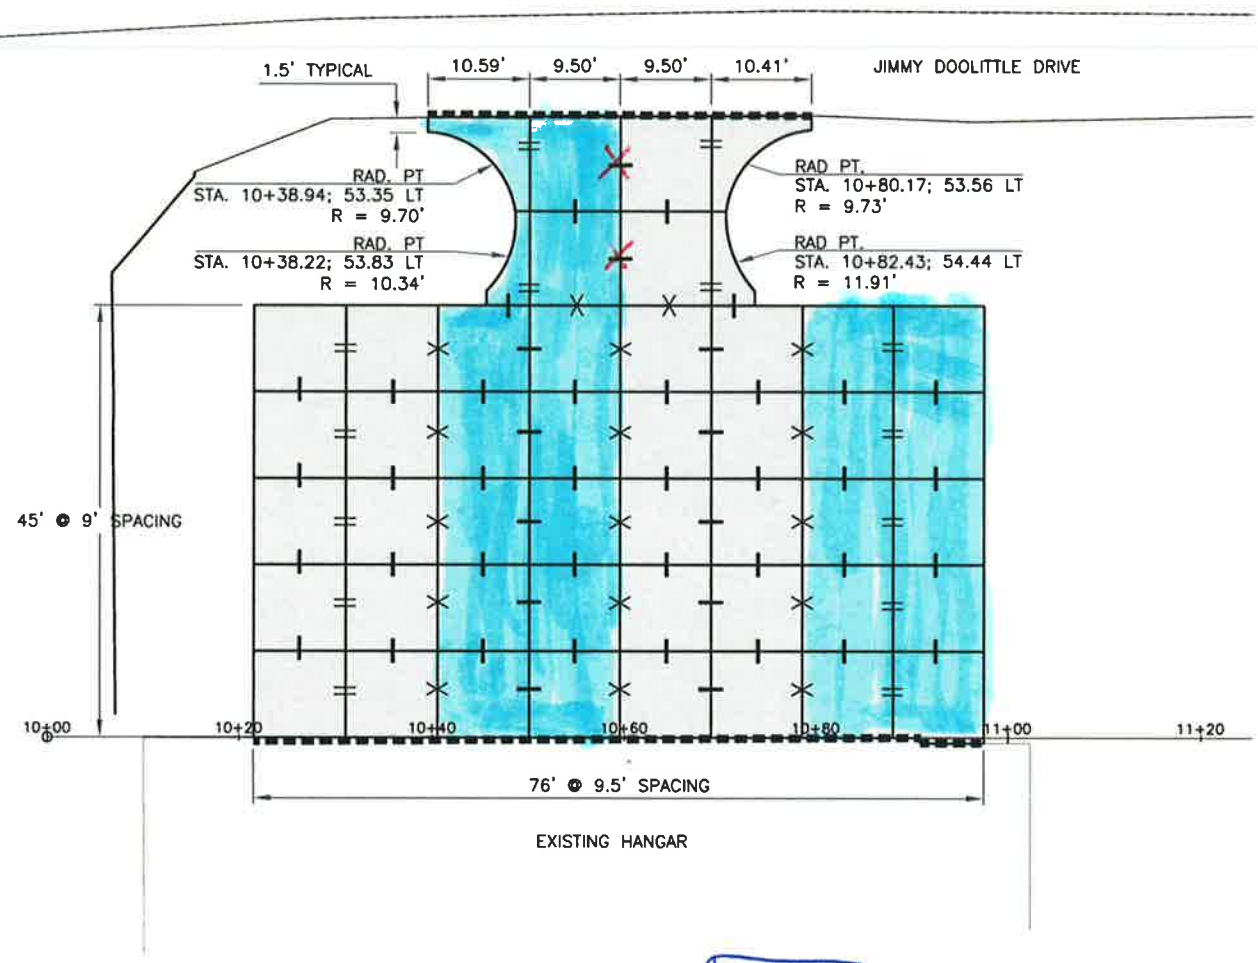

REGISTRATION NO.
F-5713

FINAL PLANS
 THIS DOCUMENT IS RELEASED FOR THE PURPOSE OF INTERIM REVIEW UNDER THE AUTHORITY OF FRANK O. MCILLWAIN, P.E. 93229 ON 06/20/2012. IT IS NOT TO BE USED FOR CONSTRUCTION, BIDDING, OR PERMIT PURPOSES.

REV.	DATE	DESCRIPTION	BY

ADDISON AIRPORT
 ADDISON, TX
 S-1 PARKING LOT IMPROVEMENTS

JOINT LAYOUT PLAN

JOB NO.: 12081100
 DATE: JUNE, 2012
 DESIGNED BY: MRM
 DRAWN BY: EGC

BAR IS ONE INCH ON ORIGINAL DRAWING
 0 1"
 IF NOT ONE INCH ON THIS SHEET, ADJUST SCALES ACCORDINGLY.

SHEET NUMBER
C-105