

# SEQ AREA BUILDING, PAVEMENT, AND UTILITY DEMOLITION


## ADDISON AIRPORT

### ADDISON, TEXAS



REGISTRATION NO.  
F-5713

**RECORD DRAWINGS**  
(JUNE 2018)

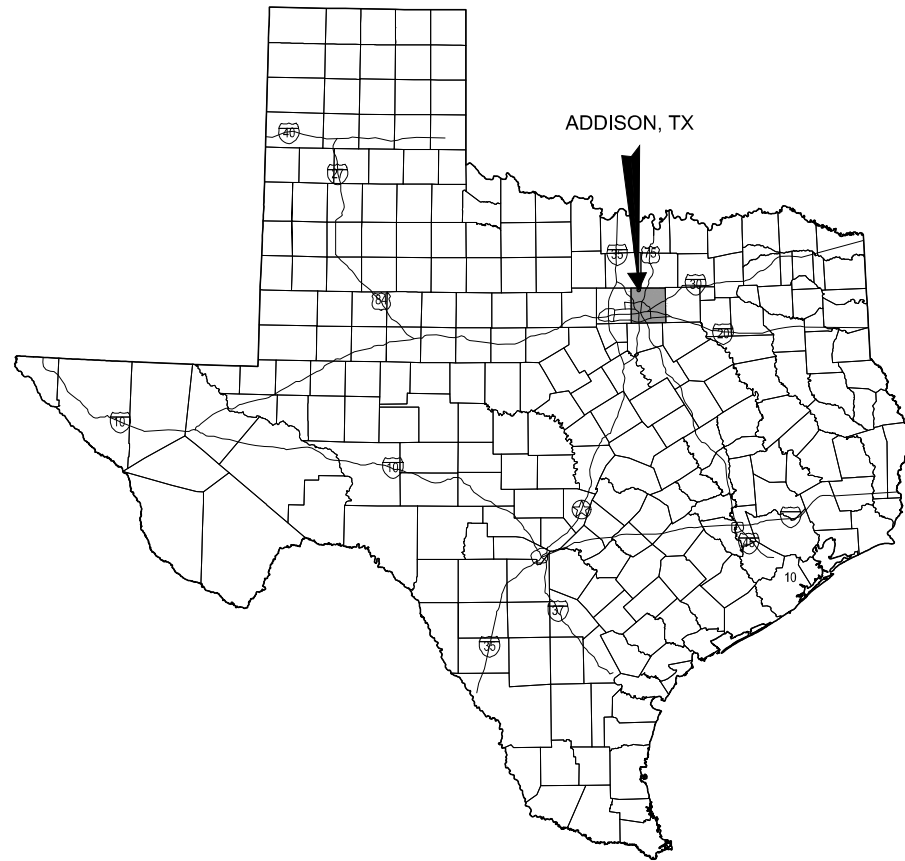

LOCATION MAP



SHEET LIST TABLE		
SHEET NUMBER	DRAWING NUMBER	SHEET TABLE
GENERAL		
1	G-101	COVER SHEET
2	G-102	GENERAL NOTES
3	G-103	PROJECT LAYOUT PLAN
4	G-201	SWPPP LAYOUT PLAN
5	G-202	SWPPP NOTES
6	G-203	SWPPP DETAILS I
7	G-204	SWPPP DETAILS II
CIVIL		
8	C-001	MISCELLANEOUS DETAILS I
9	C-100	PAVEMENT AND HANGAR DEMOLITION PLAN - SCHEDULE 1
10	C-101	PAVEMENT AND HANGAR DEMOLITION PLAN - SCHEDULE 2
11	C-102	UTILITY DEMOLITION PLAN I - SCHEDULE 1
12	C-103	UTILITY DEMOLITION PLAN II - SCHEDULE 1
13	C-104	UTILITY DEMOLITION PLAN I - SCHEDULE 2
14	C-105	UTILITY DEMOLITION PLAN II - SCHEDULE 2

REV.	DATE	DESCRIPTION	BY



ADDISON AIRPORT  
ADDISON, TEXAS

SEQ AREA BUILDING,  
PAVEMENT, AND UTILITY DEMOLITION

TOWN OF ADDISON BID NO. 17-185  
GARVER PROJECT NO. 17081100  
JUNE 2017



3010 Gaylord Parkway  
Suite 190  
Frisco, TX 75034  
(972) 377-7480

**RECORD DRAWINGS**  
06/08/2018

*To the best knowledge of the Engineer, these drawings have been generally conformed to the construction of the improvements based on information supplied by the owner, contractor and/or resident project representative. The accuracy of the information contained within these record drawings is not guaranteed.*

Brandon C. Beville, P.E.  
Date: 06/08/2018

COVER SHEET

JOB NO.: 17081100  
DATE: JUNE, 2017  
DESIGNED BY: KKR  
DRAWN BY: KKR

BAR IS ONE INCH ON ORIGINAL DRAWING  
IF NOT ONE INCH ON THIS SHEET, ADJUST SCALES ACCORDINGLY.

DRAWING NUMBER  
**G-101**

SHEET NUMBER  
**1**

File: I:\2018\17081100 - ads on call services\Drawings\RECORD\SEQ\Drawings\seq-full.dwg - ssm - standard\ADS-SEQ-G101-CO-DEMO.dwg Last Save: 6/8/2018 9:04 AM Last saved by: MSLang  
Last plotted by: Lang, Madison S. Plot Style: AECmonochrome.ctb Plot Date: 6/8/2018 11:20 AM Plotter Used: None