


ITEMS OF WORK

BASE BID SCHEDULE 1	<ol style="list-style-type: none"> REMOVE THE THREE T-HANGARS, THE AXIS HANGAR AND THE BATHROOM BUILDING. REMOVE APPROX. 15532 S.Y. OF ASPHALT PAVEMENT. REMOVE THE IDENTIFIED UTILITIES.
BASE BID SCHEDULE 2	<ol style="list-style-type: none"> REMOVE THE THREE T-HANGARS. REMOVE APPROX. 9042 S.Y. OF ASPHALT PAVEMENT. REMOVE THE IDENTIFIED UTILITIES.

NOTE: EITHER BASE BID SCHEDULE 1 OR BASE BID SCHEDULE 2 WILL BE AWARDED.

CONTRACT TIME

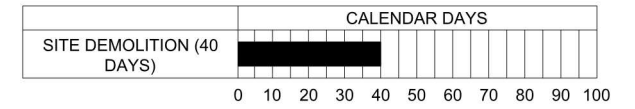

CONTRACT TIME NOTES:

- CONTRACT TIME IS THE SAME REGARDLESS OF AWARDED SCHEDULE.
- FENCE INSTALLATION AND UTILITY RELOCATION WORK IS BEING PERFORMED UNDER SEPARATE CONTRACTS. THE DEMO WORK UNDER THIS CONTRACT CAN NOT BEGIN UNTIL THE FENCE & UTILITY RELOCATION WORK IS COMPLETE.



REGISTRATION NO. F-5713

RECORD DRAWINGS
(JUNE 2018)

REV.	DATE	DESCRIPTION	BY



ADDISON AIRPORT
ADDISON, TEXAS

SEQ AREA BUILDING,
PAVEMENT, AND UTILITY DEMOLITION

PROJECT LAYOUT
PLAN


JOB NO.: 17081100
DATE: JUNE, 2017
DESIGNED BY: KKR
DRAWN BY: KKR

BAR IS ONE INCH ON ORIGINAL DRAWING
IF NOT ONE INCH ON THIS SHEET, ADJUST SCALES ACCORDINGLY.

DRAWING NUMBER
G-103

SHEET NUMBER
3

File: I:\2018\18081100 - ads on call services\Drawings\RECORD\SEQ\Demolition\seq-full.dwg, Last Save: 6/5/2018 2:19 PM, Last saved by: RVDaniels, Last plotted by: Lang, Madison S. Plot Style: AECmonochrome.ctb Plot Scale: 1:1 Plot Date: 6/8/2018 11:21 AM Plotter used: _AutoCAD PDF (General Documentation).ps3

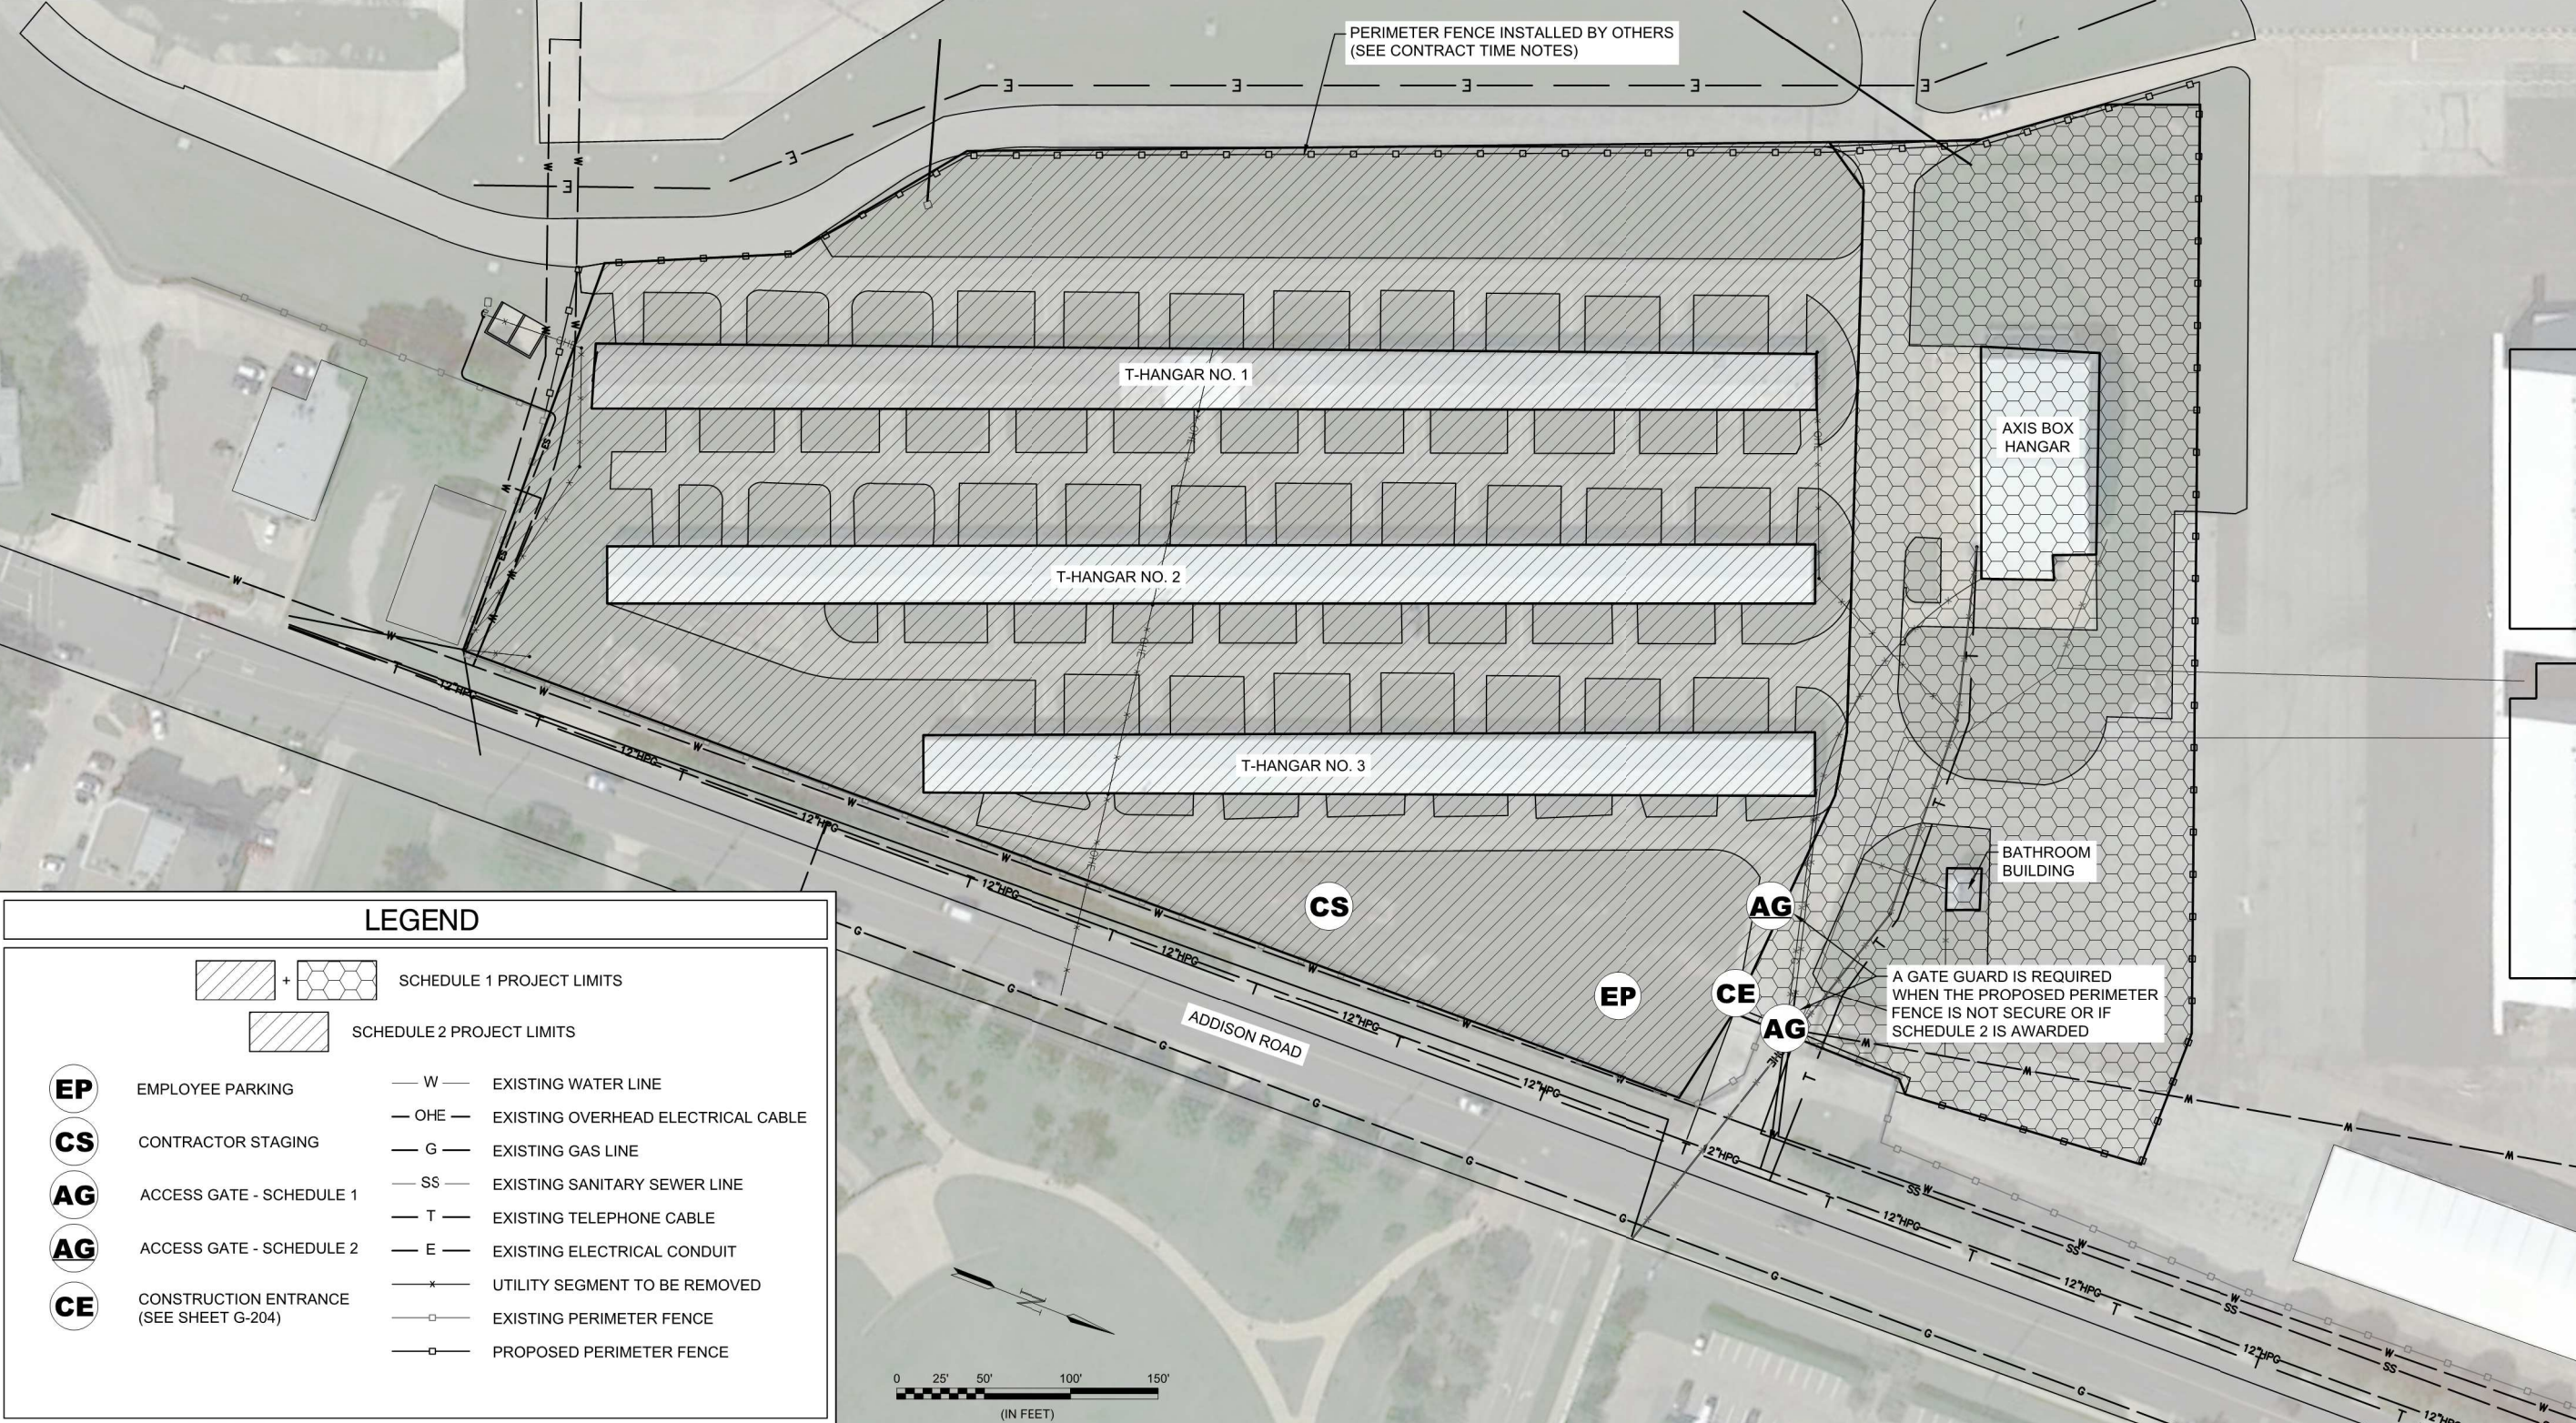

LEGEND

	SCHEDULE 1 PROJECT LIMITS		W	EXISTING WATER LINE
	SCHEDULE 2 PROJECT LIMITS		OHE	EXISTING OVERHEAD ELECTRICAL CABLE
	EMPLOYEE PARKING		G	EXISTING GAS LINE
	CONTRACTOR STAGING		SS	EXISTING SANITARY SEWER LINE
	ACCESS GATE - SCHEDULE 1		T	EXISTING TELEPHONE CABLE
	ACCESS GATE - SCHEDULE 2		E	EXISTING ELECTRICAL CONDUIT
	CONSTRUCTION ENTRANCE (SEE SHEET G-204)		*	UTILITY SEGMENT TO BE REMOVED
				EXISTING PERIMETER FENCE
				PROPOSED PERIMETER FENCE

