



REGISTRATION NO.
F-5713

RECORD DRAWINGS
(JUNE 2018)

REV.	DATE	DESCRIPTION	BY



ADDISON AIRPORT
ADDISON, TEXAS

SEQ AREA BUILDING,
PAVEMENT, AND UTILITY DEMOLITION


SWPPP LAYOUT PLAN

JOB NO.: 17081100
DATE: JUNE, 2017
DESIGNED BY: KKR
DRAWN BY: KKR

BAR IS ONE INCH ON ORIGINAL DRAWING
IF NOT ONE INCH ON THIS SHEET, ADJUST SCALES ACCORDINGLY.

DRAWING NUMBER
G-201

SHEET NUMBER
4

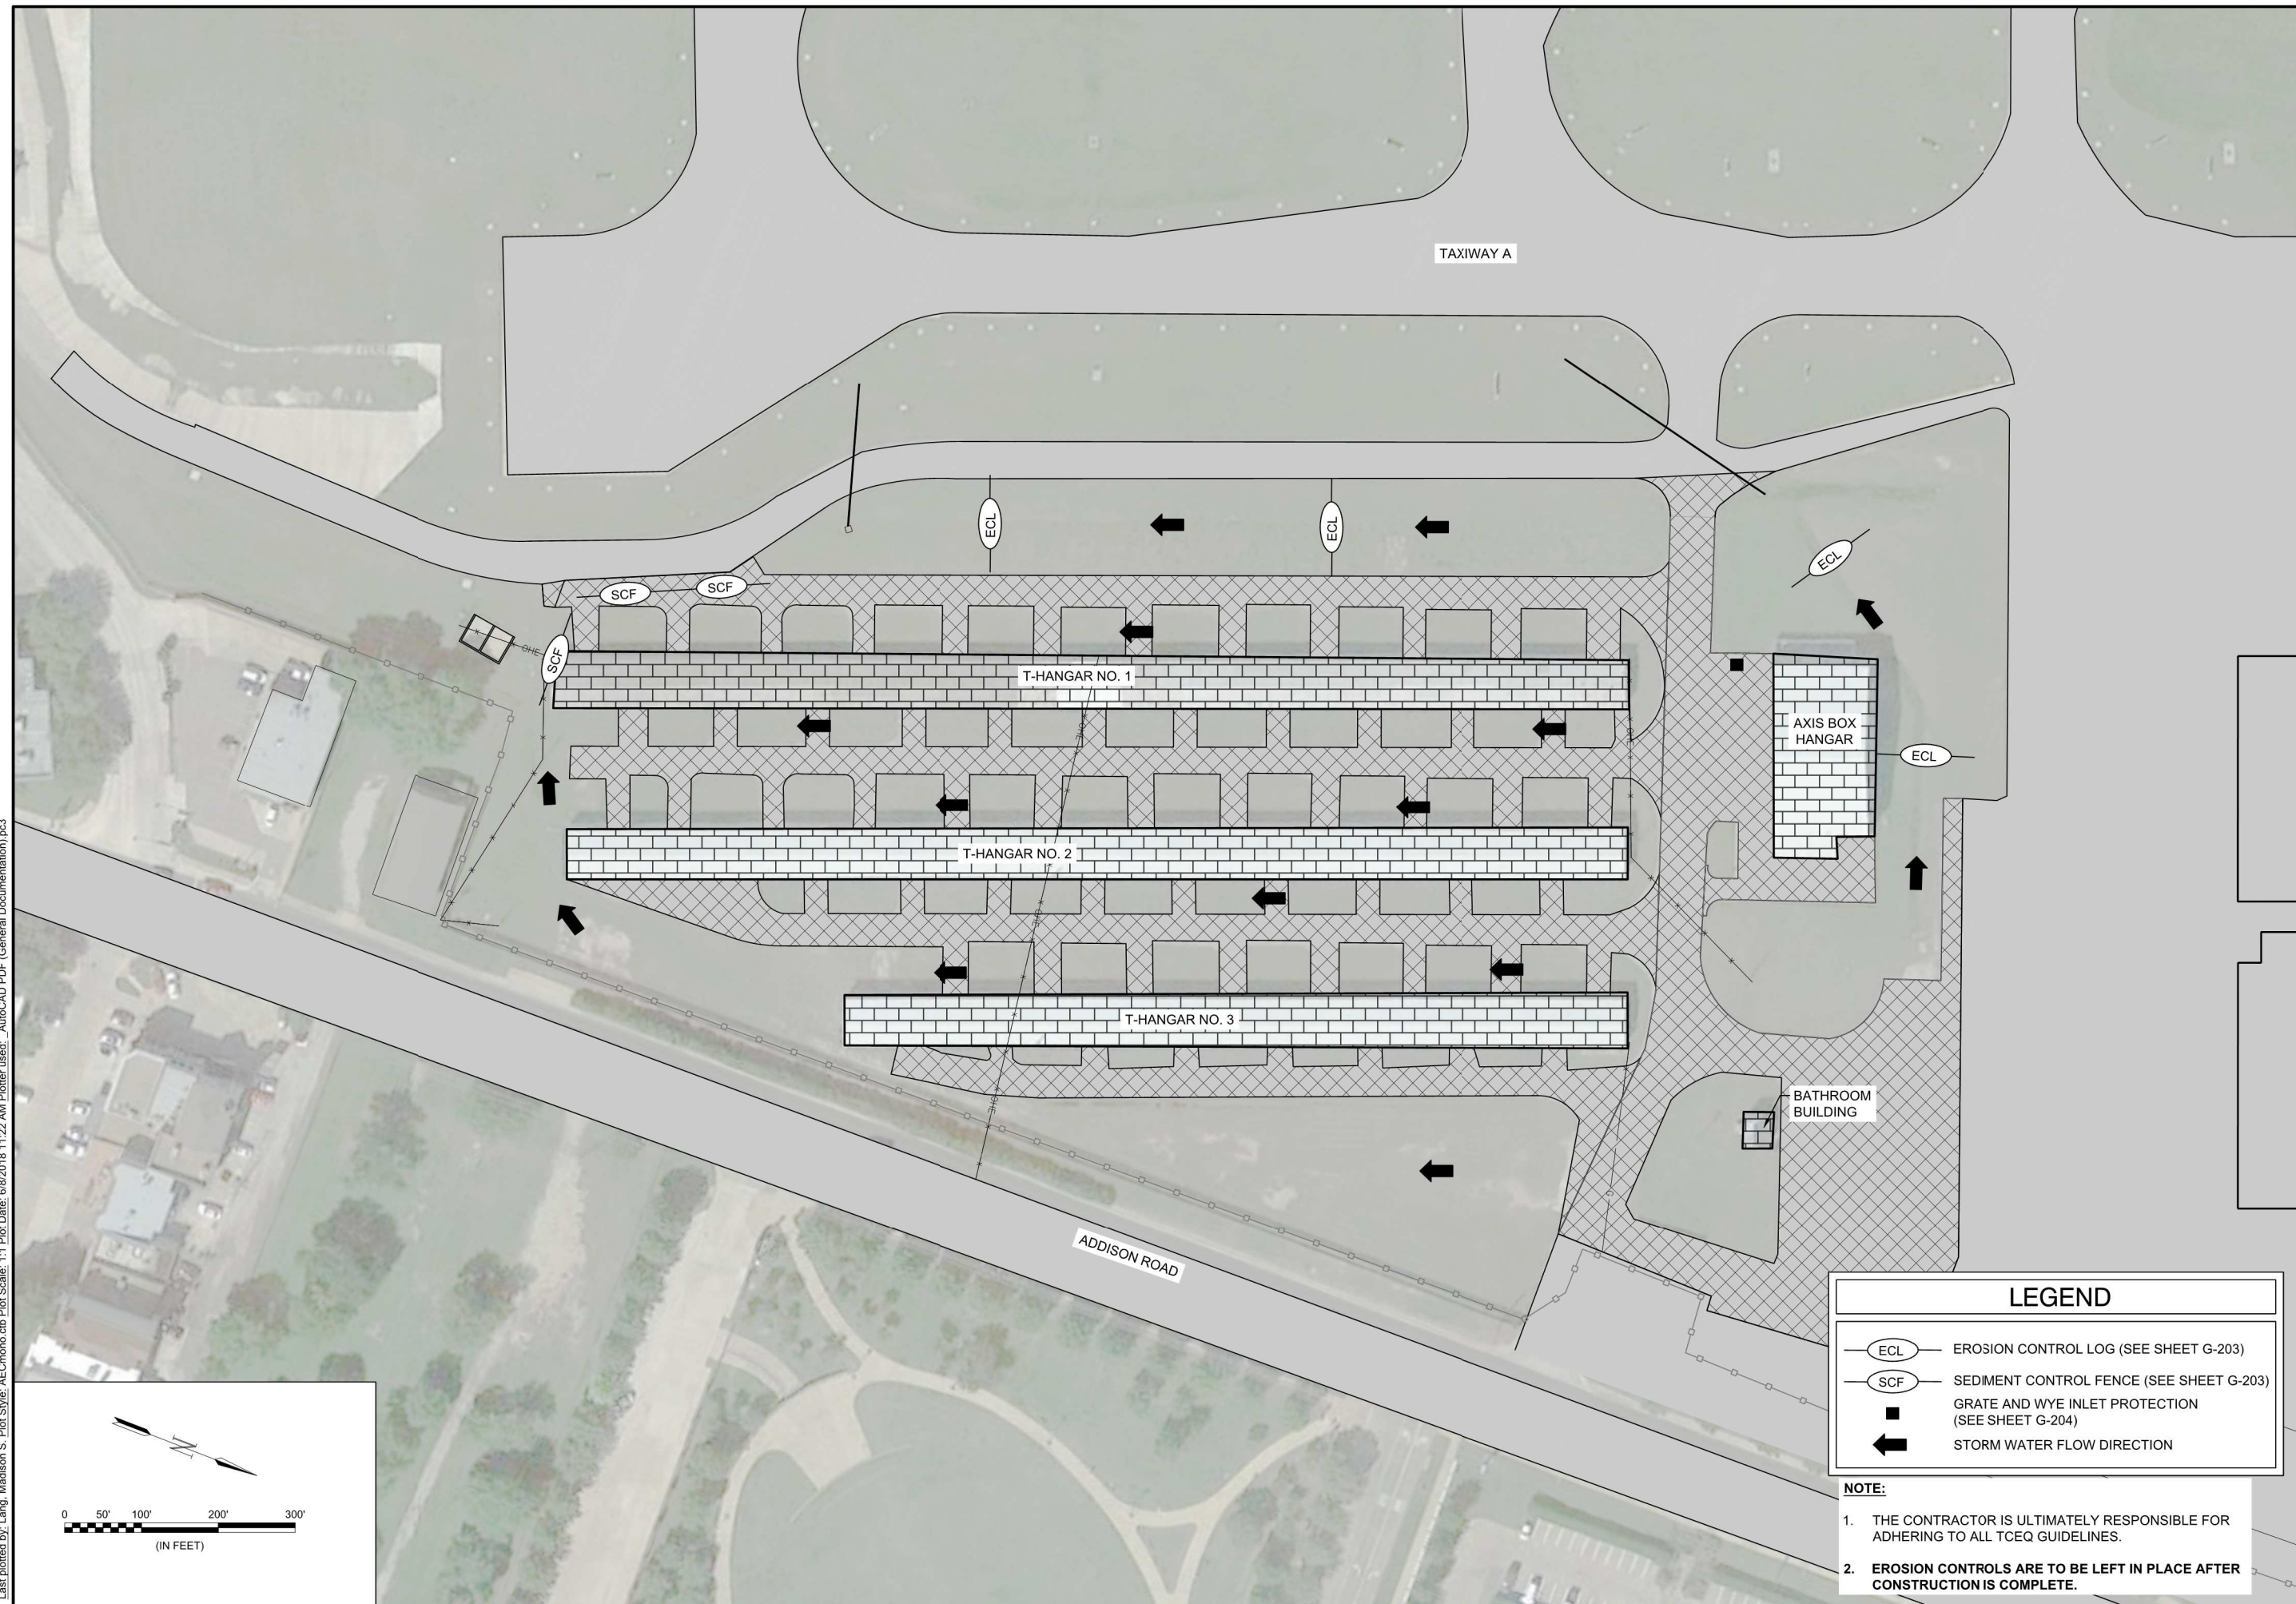


LEGEND

- EROSION CONTROL LOG (SEE SHEET G-203)
- SEDIMENT CONTROL FENCE (SEE SHEET G-203)
- GRATE AND WYE INLET PROTECTION (SEE SHEET G-204)
- STORM WATER FLOW DIRECTION

NOTE:

- THE CONTRACTOR IS ULTIMATELY RESPONSIBLE FOR ADHERING TO ALL TCEQ GUIDELINES.
- EROSION CONTROLS ARE TO BE LEFT IN PLACE AFTER CONSTRUCTION IS COMPLETE.

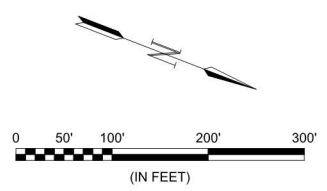

File: I:\2018\18081100 - ads on call services\Drawings\RECORD\SEQ Demol\ads-see-full demo_ ssm - standard\ADS-SEQ-G201-SI-DEMO.dwg Last Save: 6/5/2018 2:20 PM Last saved by: RVDaniels
 Last plotted by: Lang, Madison S. Plot Style: AECmonochrome.ctb Plot Scale: 1:1 Plot Date: 6/8/2018 11:22 AM Plotter used: _AutoCAD PDF (General Documentation).pc3