



File: I:\2018\18081100 - ads on call services\Drawings\RECORD\SEC\Demolition\SD-DEM.dwg, Last Save: 6/5/2018, 2:20 PM, Last saved by: RVDaniels
 Last plotted by: Lang, Madison S, Plot Style: AECmonochrome.ctb, Scale: 1:1, Plot Date: 6/6/2018, 11:23 AM, Printer used: _AutoCAD PDF (General Documentation).ps3

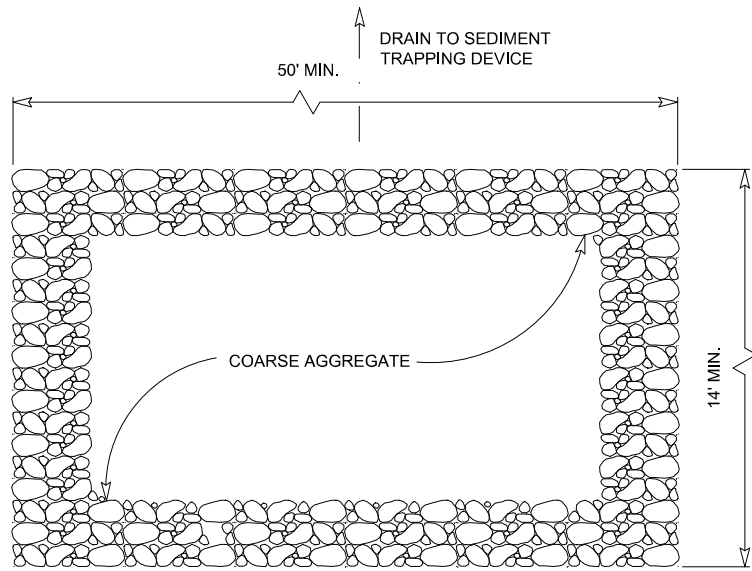

CONSTRUCTION ENTRANCE/EXIT NOTES:

1. THE LENGTH OF THE TYPE 1 CONSTRUCTION EXIT SHALL BE AS INDICATED ON THE PLANS, BUT NOT LESS THAN 50'.
2. THE COARSE AGGREGATE SHOULD BE OPEN GRADED WITH A SIZE OF 4" TO 8".
3. THE APPROACH TRANSITIONS SHOULD BE NO STEEPER THAN 6:1 AND CONSTRUCTED AS DIRECTED BY THE ENGINEER.
4. THE CONSTRUCTION EXIT FOUNDATION COURSE SHALL BE FLEXIBLE BASE, BITUMINOUS CONCRETE, PORTLAND CEMENT CONCRETE OR OTHER MATERIAL AS APPROVED BY THE ENGINEER.
5. THE CONSTRUCTION EXIT SHALL BE GRADED TO ALLOW DRAINAGE TO A SEDIMENT TRAPPING DEVICE.

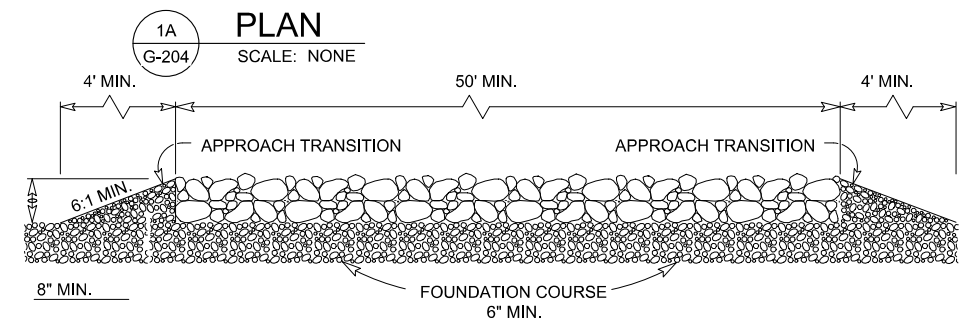


1A PLAN
G-204 SCALE: NONE




1B PROFILE
G-204 SCALE: NONE


1 CONSTRUCTION ENTRANCE/EXIT (TYPE 1)
G-204 SCALE: NONE

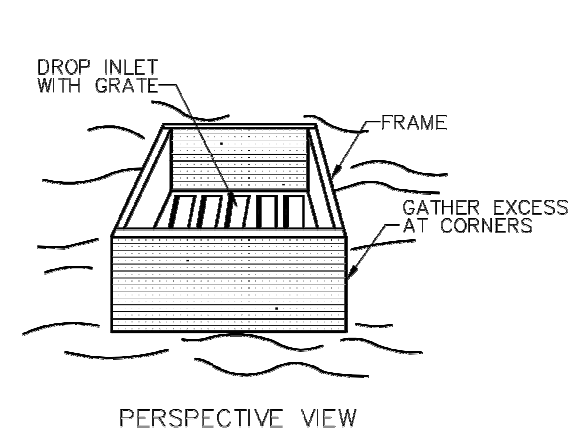


PERSPECTIVE VIEW

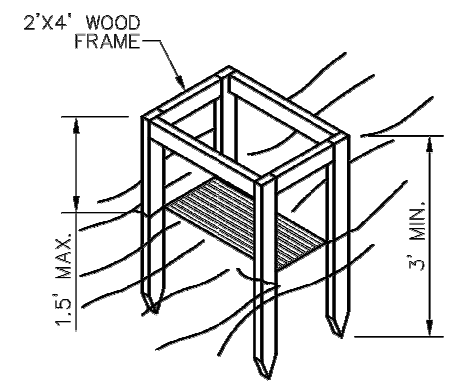

PERSPECTIVE VIEW

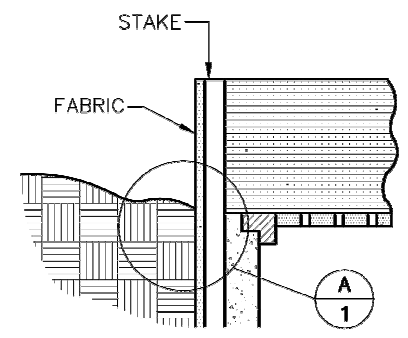

ELEVATION OR STAKE AND FABRIC ORIENTATION

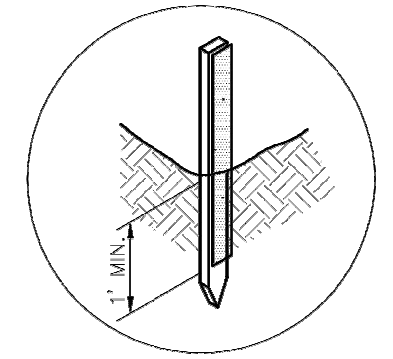

DETAIL 'A'

SPECIFIC APPLICATION
 THIS METHOD OF INLET PROTECTION IS APPLICABLE WHERE THE INLET DRAINS A RELATIVELY FLAT AREA (SLOPE NO GREATER THAN 5%) WHERE THE INLET SHEET OR OVER-LAND FLOWS (NOT TO EXCEED 1 C.F.S.) ARE TYPICAL. THE METHOD SHALL NOT APPLY TO INLETS RECEIVING CONCENTRATED FLOWS SUCH AS IN STREETS OR HIGHWAY MEDIANS.

 PUBLIC WORKS DEPARTMENT	GRATE AND WYE INLET PROTECTION		STANDARD CONSTRUCTION DETAILS EROSION CONTROL	
	DATE: AUGUST, 2010	REV DATE: -	SHEET : SD-EC04	

2 GRATE AND WHY INLET PROTECTION
G-204 SCALE: NONE



REGISTRATION NO.
F-5713

RECORD DRAWINGS
 (JUNE 2018)

REV.	DATE	DESCRIPTION

ADDISON AIRPORT
 ADDISON, TEXAS
 SEQ AREA BUILDING,
 PAVEMENT, AND UTILITY DEMOLITION

SWPPP DETAILS II

JOB NO.: 17081100
 DATE: JUNE, 2017
 DESIGNED BY: KKR
 DRAWN BY: KKR
BAR IS ONE INCH ON ORIGINAL DRAWING
IF NOT ONE INCH ON THIS SHEET, ADJUST SCALES ACCORDINGLY.
 DRAWING NUMBER
G-204
 SHEET NUMBER
7