

# SCHEDULE 1 - BASE BID

## DEMOLITION NOTES:

- HANGARS: THE HANGARS TO BE REMOVED UNDER SCHEDULE 1 AND SCHEDULE 2 ARE IDENTIFIED ON SHEETS C-100 AND C-101 RESPECTIVELY. THE CONTRACTOR SHALL REMOVE ALL ABOVE GROUND INFRASTRUCTURE PERTAINING TO THE IDENTIFIED HANGAR REGARDLESS OF MATERIAL TYPE, AND SIZE. THE CONTRACTOR SHALL ALSO BE RESPONSIBLE FOR THE REMOVAL OF ALL ITEMS INSIDE THE HANGARS. FURTHERMORE, THE CONTRACTOR SHALL REMOVE THE HANGAR FOUNDATION AND OTHER UNDERGROUND STRUCTURAL COMPONENT OF THE HANGAR.
- PAVEMENT: PAVEMENT TO BE REMOVED UNDER SCHEDULE 1 AND SCHEDULE 2 IS IDENTIFIED ON SHEETS C-100 AND C-101 RESPECTIVELY. THE CONTRACTOR SHALL REMOVE THE EXISTING PAVEMENT TO THE DELINEATED LIMITS. SEE DEMOLITION AND DISPOSAL SPECIFICATION FOR MORE DETAILS.
- GRADING AND SEEDING WILL BE PERFORMED BY THE AIRPORT AFTER DEMO WORK IS COMPLETE.
- GUIDELINES ON UTILITY REMOVAL FOR SCHEDULE 1 AND SCHEDULE 2 CAN BE FOUND ON SHEETS C-102 AND C-104 RESPECTIVELY.
- THE MISCELLANEOUS DEMOLITION AND DISPOSAL ITEM INCLUDES ANY ITEM NOT INCLUDED UNDER OTHER PAY ITEMS, THAT IS DEEMED TO BE REMOVED.
- SEE UTILITY NOTE ON SHEET G-102.



REGISTRATION NO.  
F-5713

**RECORD DRAWINGS**  
(JUNE 2018)

REV.	DATE	DESCRIPTION



ADDISON AIRPORT  
ADDISON, TEXAS

SEQ AREA BUILDING,  
PAVEMENT, AND UTILITY DEMOLITION


PAVEMENT AND  
HANGAR DEMOLITION  
PLAN - SCHEDULE 1

JOB NO.: 17081100  
DATE: JUNE, 2017  
DESIGNED BY: KKR  
DRAWN BY: KKR

BAR IS ONE INCH ON  
ORIGINAL DRAWING  
IF NOT ONE INCH ON  
THIS SHEET, ADJUST  
SCALES ACCORDINGLY.

DRAWING NUMBER  
**C-100**


SHEET  
NUMBER **9**

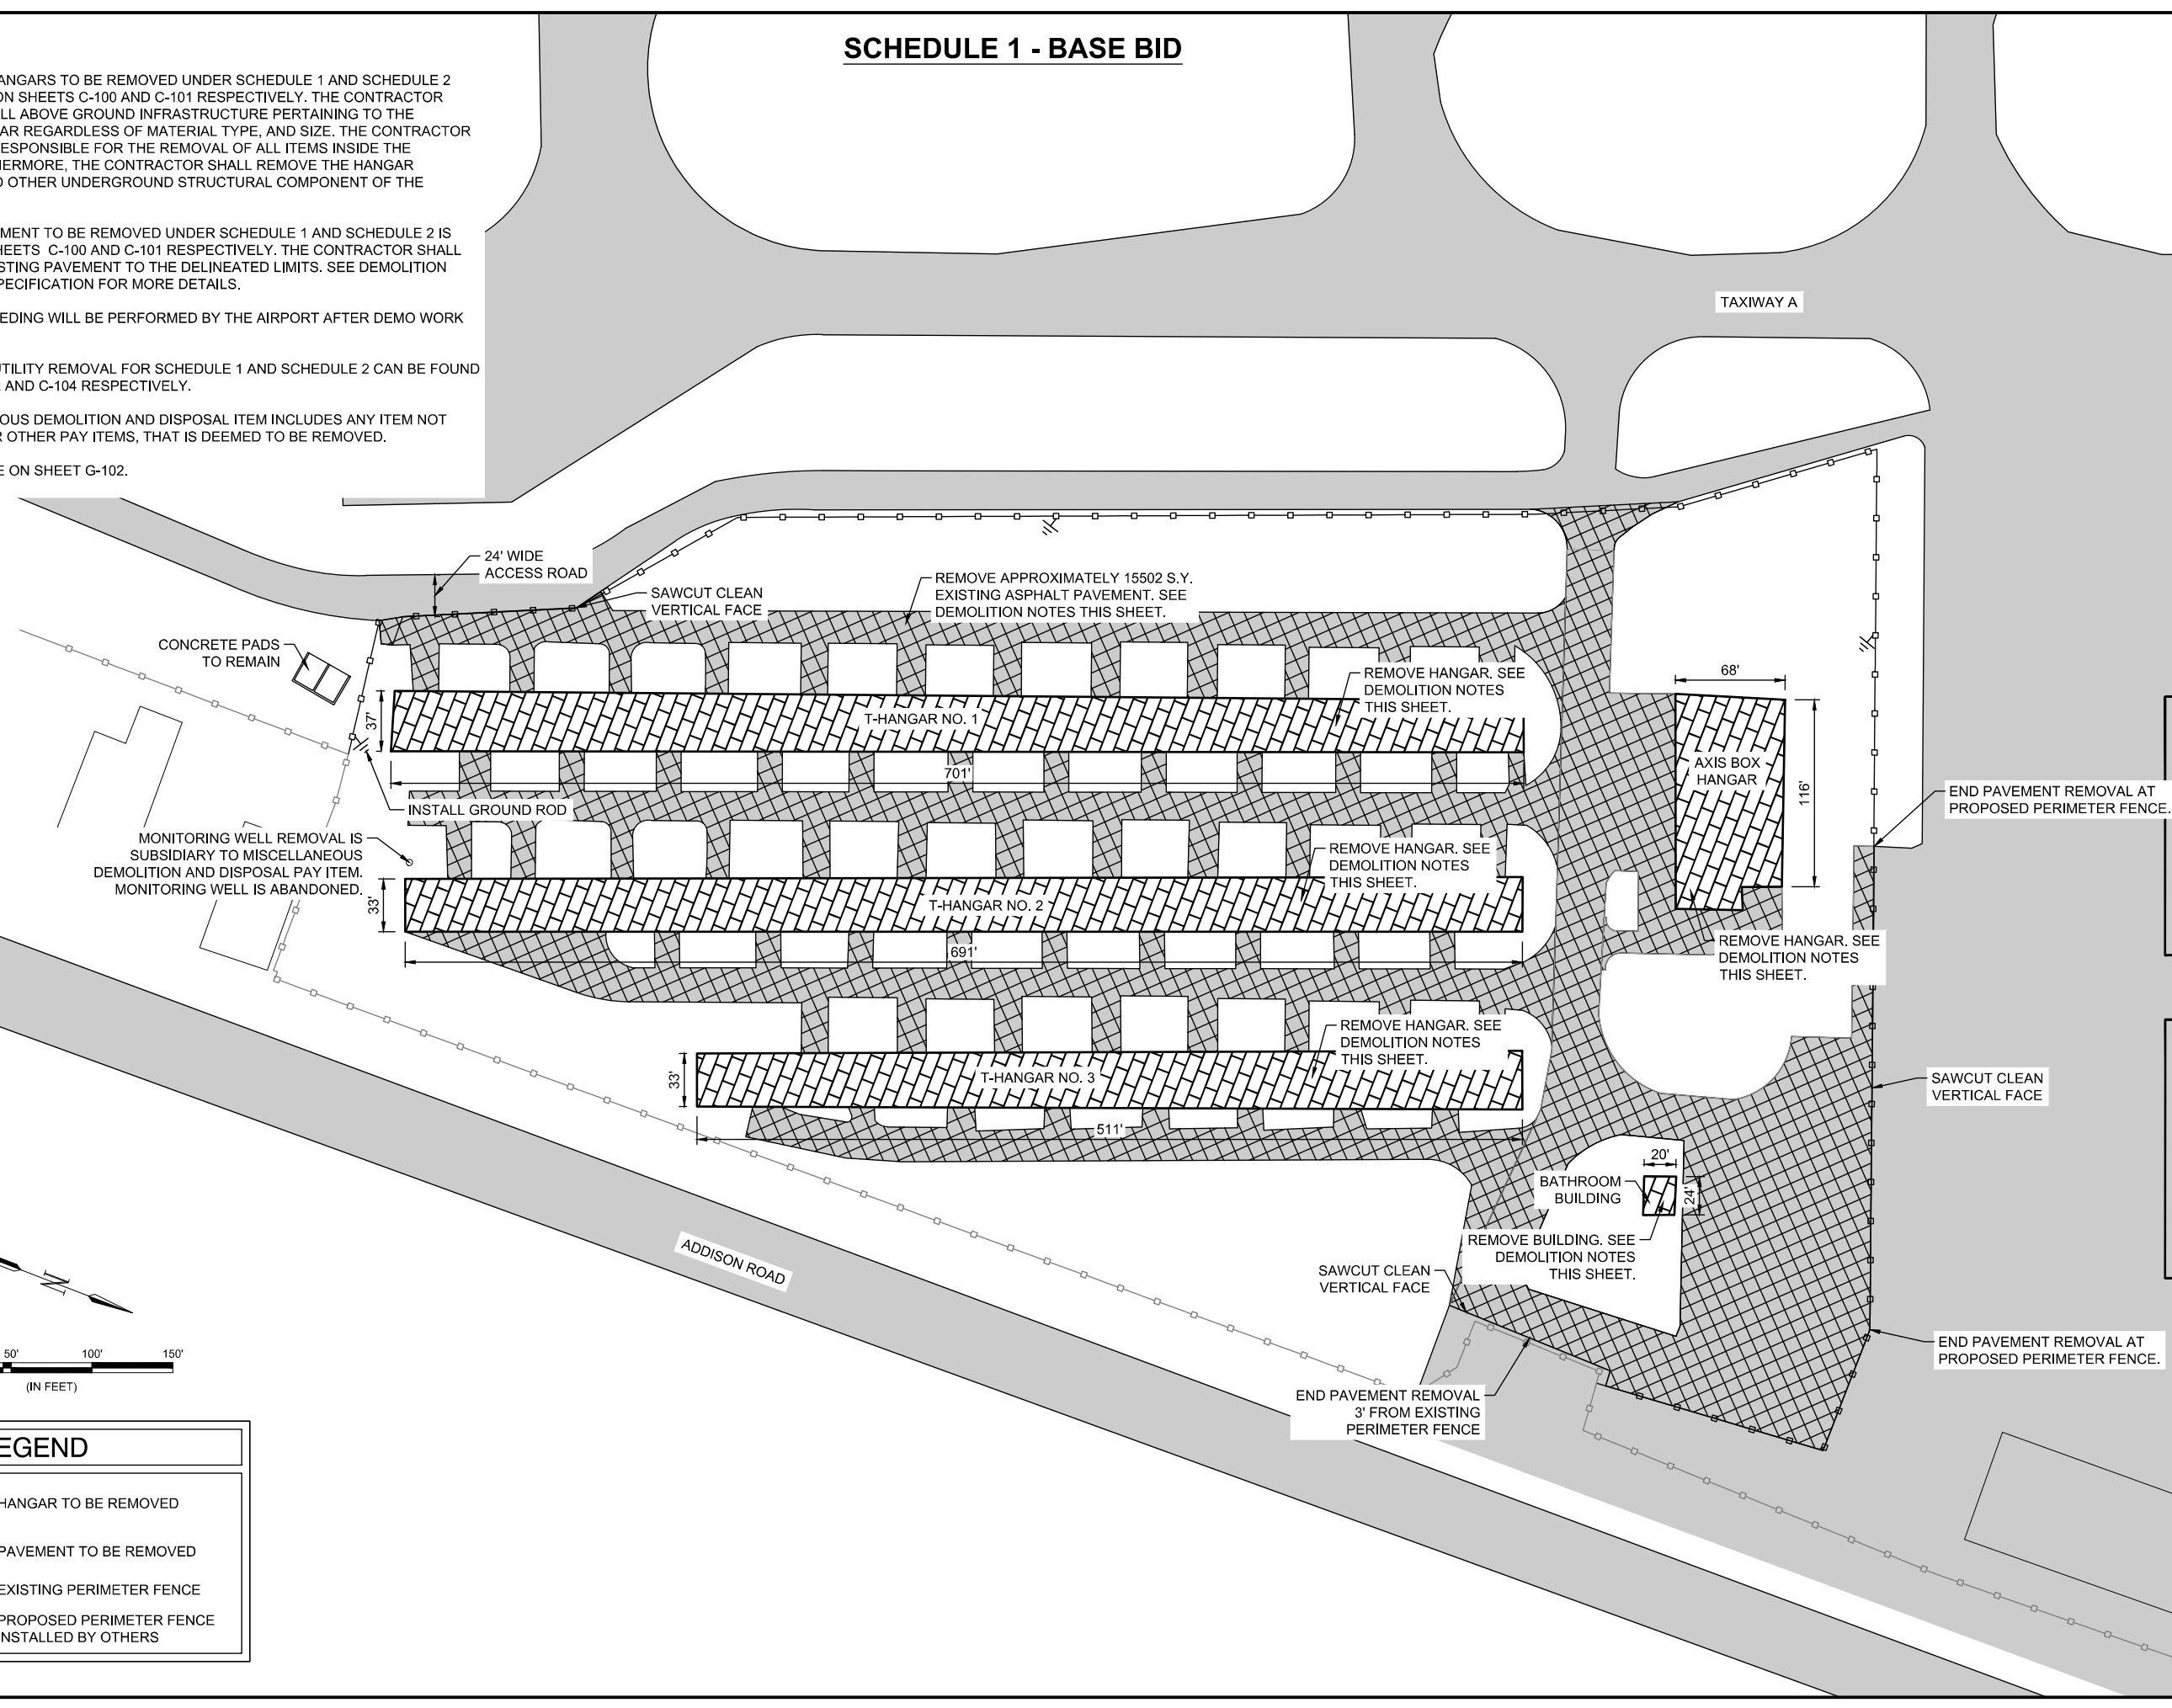

CONCRETE PADS TO REMAIN

INSTALL GROUND ROD

MONITORING WELL REMOVAL IS SUBSIDIARY TO MISCELLANEOUS DEMOLITION AND DISPOSAL PAY ITEM. MONITORING WELL IS ABANDONED.

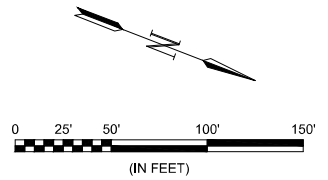

LEGEND	
	HANGAR TO BE REMOVED
	PAVEMENT TO BE REMOVED
	EXISTING PERIMETER FENCE
	PROPOSED PERIMETER FENCE INSTALLED BY OTHERS

File: I:\2018\18081100 - ads on call services\Drawings\RECORD\SEQ Demolition\seq-full demo\_ssm - standard\ADS-SEQ-C100-DP-DEMO.dwg, Last Save: 6/8/2018, 9:30 AM, Last saved by: MSLang  
 Last plotted by: Lang, Madison S. Plot Style: AECmonochrome.ctb, Scale: 1:1, Plot Date: 6/8/2018, 11:23 AM, Printer used: \_AutoCAD PDF (General Documentation).pc3