


PLANS FOR DEMOLITION, GRADING, PAVING, DRAINAGE AND  
STORM WATER POLLUTION PREVENTION

# ADDISON AIRPORT PAVEMENT RECONSTRUCTION OF TAXIWAY SIERRA (APPROXIMATE LENGTH 730 LF)

AS BUILT PLANS



THIS SEAL APPEARING ON THIS DOCUMENT  
WAS AUTHORIZED BY J.S. NICWANDER ON  
OCTOBER 26, 2007

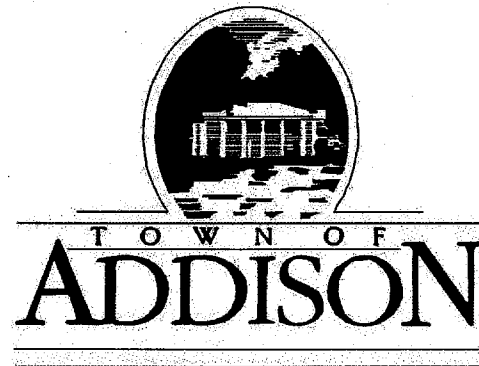


<b>JOE CHOW</b> MAYOR	
TOM BRAUN MAYOR PRO TEMPORE	ROGER S. MELLOW DEPUTY MAYOR PRO TEMPORE
GREGORY S. HIRSCH DENNIS KRAFT	TODD MEIER JIMMY NIEMANN
COUNCIL MEMBERS	
RON WHITEHEAD CITY MANAGER	
NANCY CLINE, P.E. DIRECTOR OF PUBLIC WORKS	
MARK ACEVEDO DIRECTOR OF GENERAL SERVICES	

OWNER:


TOWN OF ADDISON  
DEP. OF PUBLIC WORKS  
16801 WESTGROVE  
P.O. BOX 9010  
ADDISON, TX 75001-9010  
(972) 450-2871

ENGINEER:

HNTB CORPORATION  
5910 W. PLANO PARKWAY, STE 200  
DALLAS, TX 75093  
(972) 661-5626

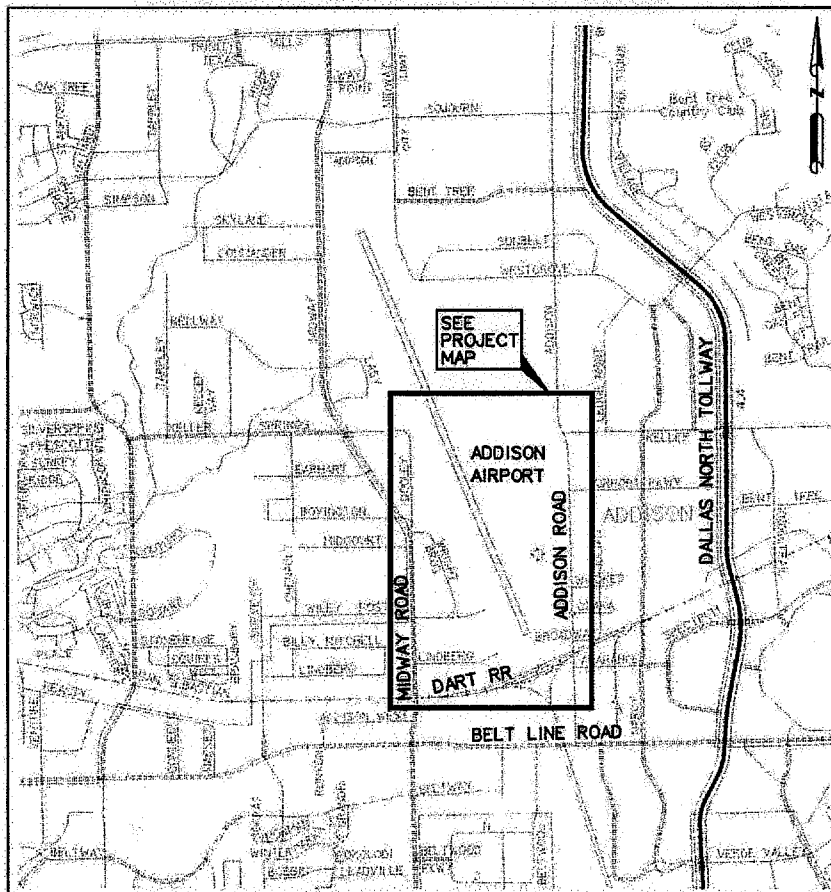

LOCATION MAP  
NOT TO SCALE

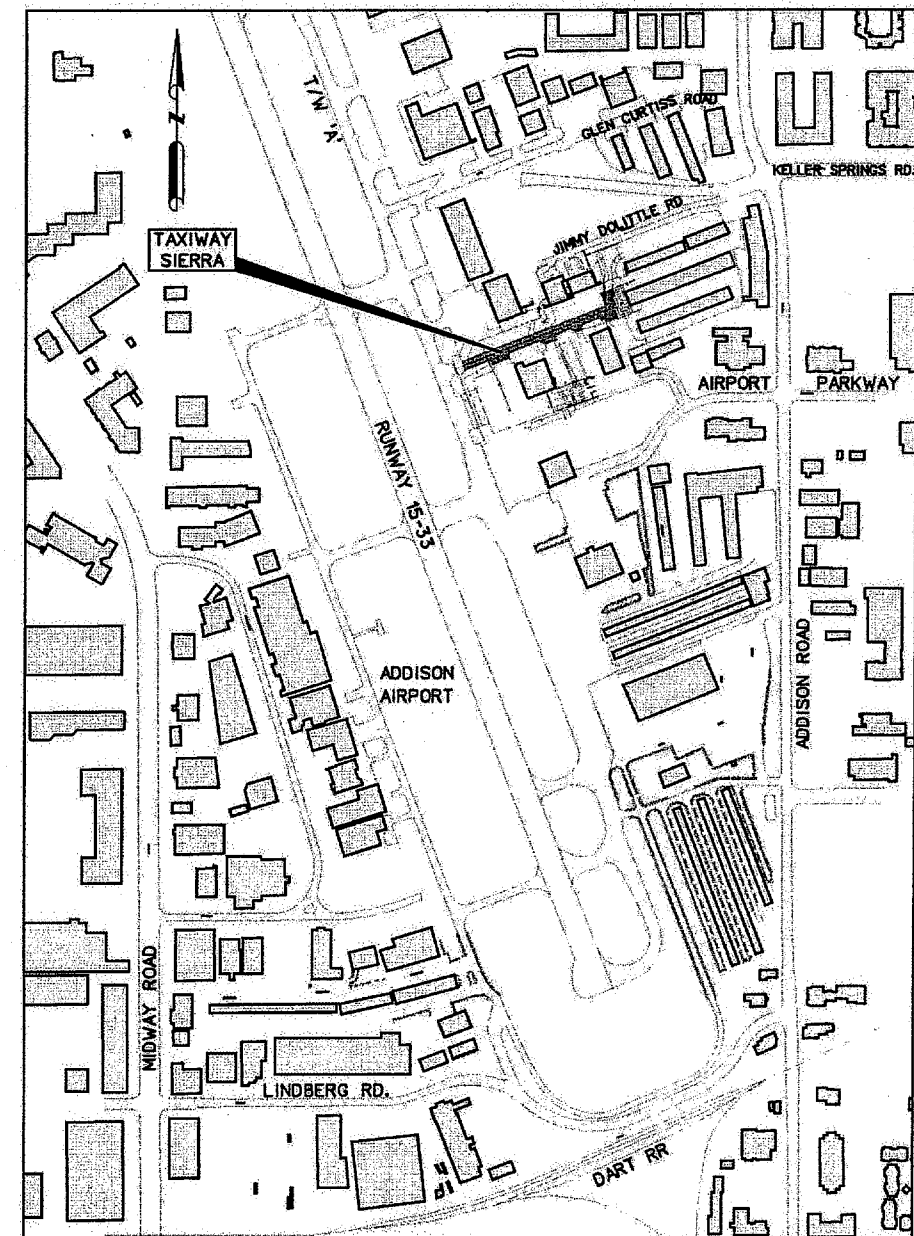

PROJECT MAP  
NOT TO SCALE