


SW3P LEGEND



	SILT FENCE
	COMPOST MULCH SOCK

NOTE:
CONTRACTOR IS RESPONSIBLE FOR UTILITY LOCATION PRIOR TO CONSTRUCTION.

MATCH LINE STA 4+00.00

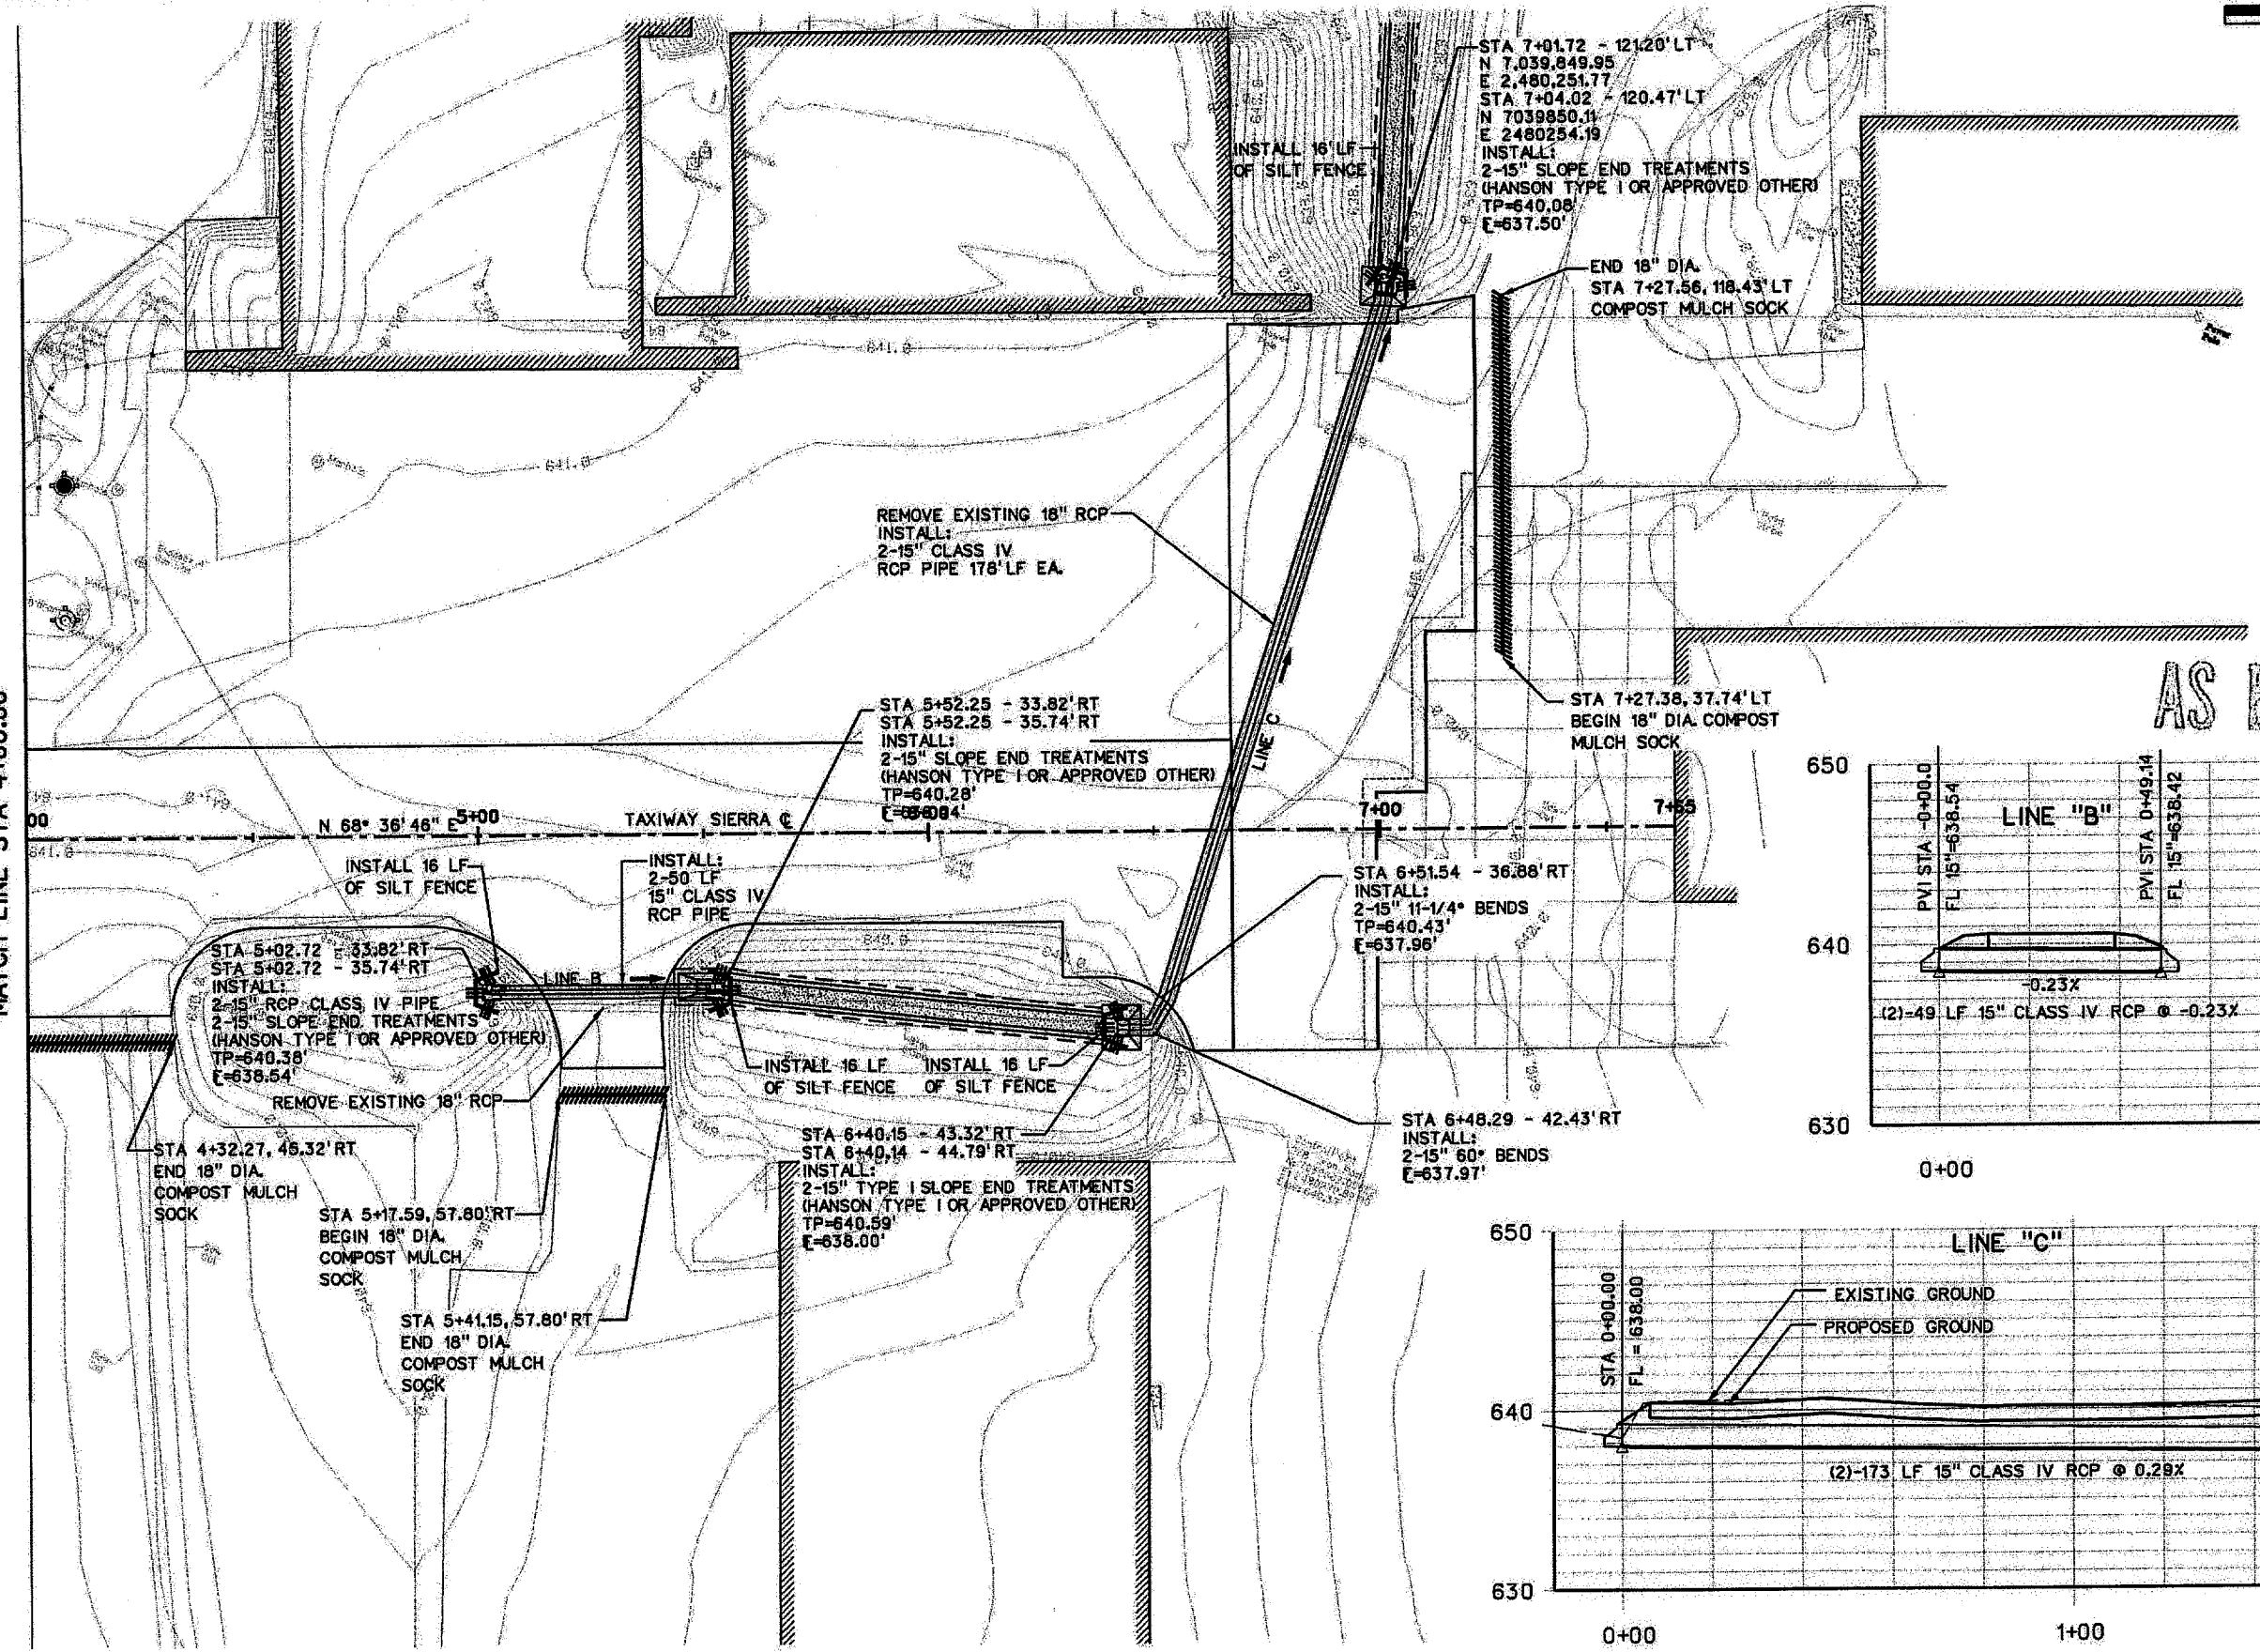

AS BUILT PLANS

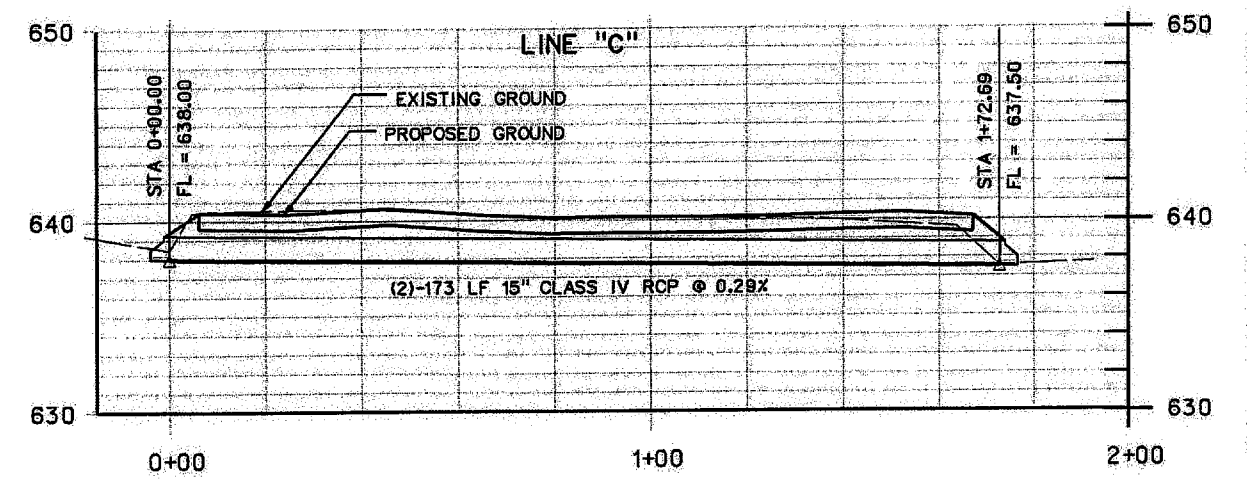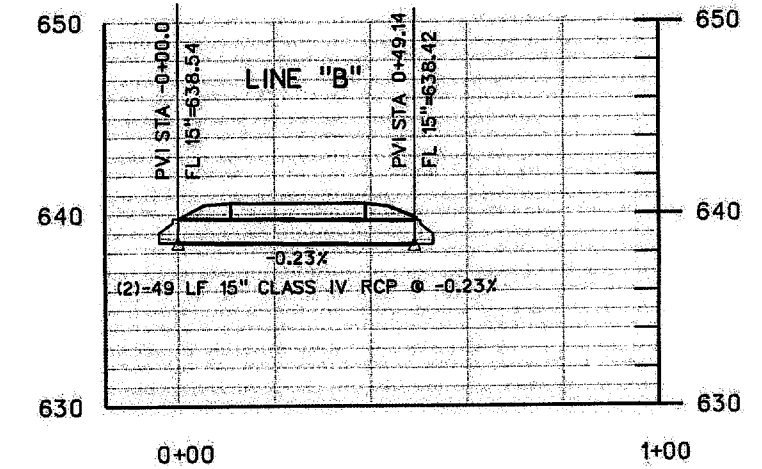

13-JUN-2008 10:53
G:\15601\Cad\Sheets\twsdp02.dgn

NO.	DATE	REVISION	APPROV.	NO.	DATE	REVISION	APPROV.

THE SEAL APPEARING ON THIS DOCUMENT WAS AUTHORIZED BY J.S. NICEWANDER, P.E. 87843 ON OCTOBER 26, 2007.



HNTB
 HNTB Corporation
 The HNTB Companies
 Engineers, Architects, Planners

DESIGN CHECK: JEN MAH
 DRAWN CHECK: CCH MAH
 DATE: SEPTEMBER 2007
 SCALE:

PROJECT NO. 45601



TOWN OF ADDISON		SHEET 19 OF 28
TAXIWAY SIERRA		
DRAINAGE AND SW3P PLAN		
TOWN OF ADDISON, TEXAS		19
TOWN OF ADDISON, TEXAS		DP-2