



DOWEL BAR ASSEMBLY
NOT TO SCALE

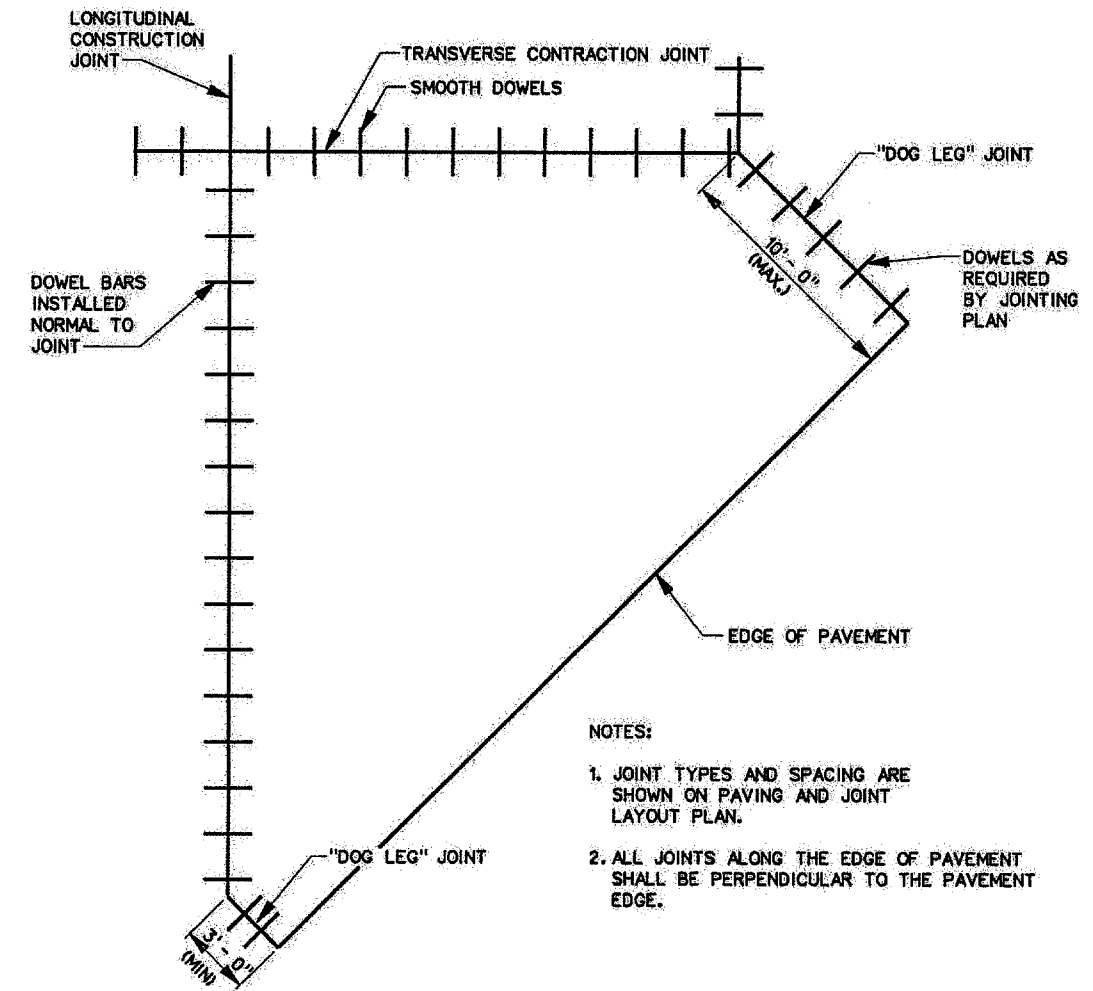

TYPICAL FILLET DETAIL
NOT TO SCALE

- NOTES:
1. JOINT TYPES AND SPACING ARE SHOWN ON PAVING AND JOINT LAYOUT PLAN.
 2. ALL JOINTS ALONG THE EDGE OF PAVEMENT SHALL BE PERPENDICULAR TO THE PAVEMENT EDGE.

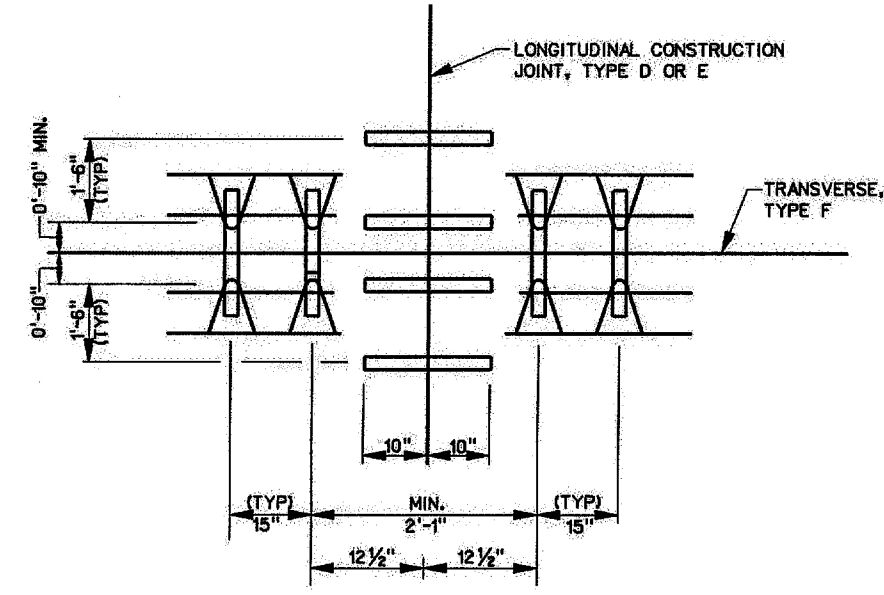

TYPICAL DOWEL BAR SPACING AT JOINT INTERSECTION
NOT TO SCALE

AS BUILT PLANS

13-JUN-2008 10:54
Gr: V45601.LC00\Sherry's\wst102.dgn

NO.	DATE	REVISION	APPROV.	NO.	DATE	REVISION	APPROV.

THE SEAL APPEARING ON THIS DOCUMENT WAS AUTHORIZED BY J.S. NICEWANDER, P.E. 87845 ON OCTOBER 26, 2007.



HNTB		HNTB Corporation The HNTB Companies Engineers, Architects, Planners
DESIGN CHECK	JSN	PROJECT NO. 45601
DRAWN CHECK	MAH	
CHECK	CCH	
DATE	SEPTEMBER 2007	
SCALE		



TOWN OF ADDISON	SHEET
TAXIWAY SIERRA	23 OF 28
PAVING DETAILS	23
TOWN OF ADDISON, TEXAS	DT-2