

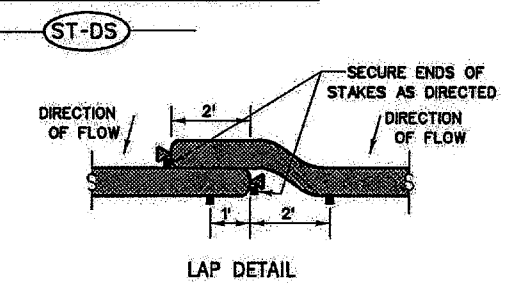
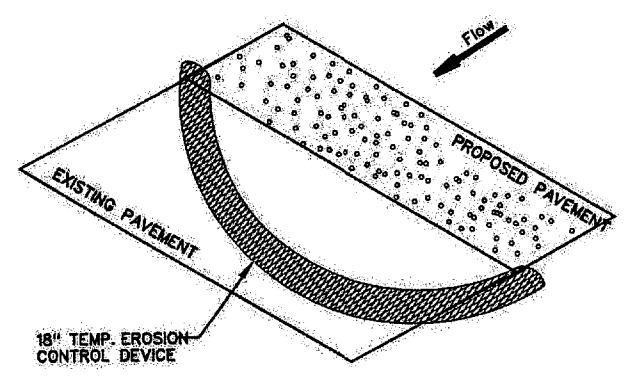


DOWN STREAM SEDIMENT TRAP

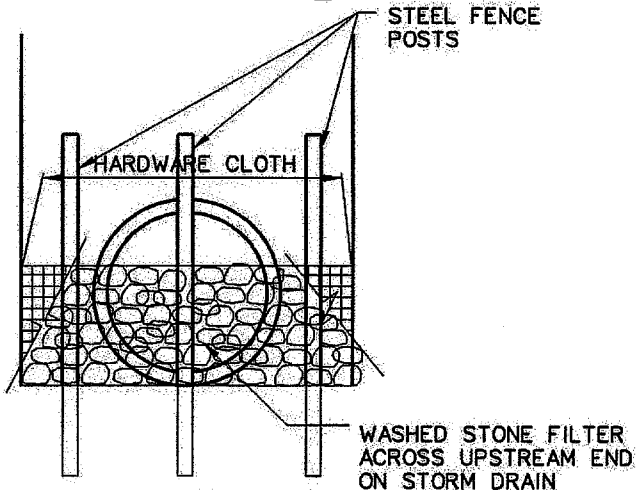

BLOCK/GRAVEL DROP INLET PROTECTION

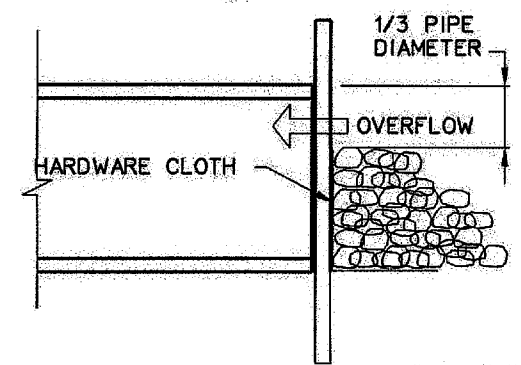

COMPOST MULCH SOCK SEDIMENT TRAP DETAIL

STANDARD GENERAL NOTES:

1. THE STORM WATER POLLUTION PREVENTION PLAN MUST BE IMPLEMENTED BY THE CONTRACTOR.
2. A CONSTRUCTION SITE NOTICE MUST BE FILLED OUT BY THE CONTRACTOR AND POSTED ON SITE. THE CONTRACTOR MUST PROVIDE A COPY OF THE CONSTRUCTION SITE NOTICE TO THE CITY.
3. THE CITY AND THE CONTRACTOR ARE EACH REQUIRED TO COMPLETE EROSION CONTROL INSPECTION REPORTS:
 - A) EVERY 2 WEEKS AND WITHIN 24 HOURS OF RAINFALL EVENTS OR
 - B) ONCE A WEEK ON A SPECIFIC DAY OF THE WEEK DESIGNATED BY THE SWPPP.
4. THE CONTRACTOR'S REPORTS MUST BE KEPT BY THE CONTRACTOR ON SITE WITH THE UP-TO-DATE SWPPP. THE CONTRACTOR MUST AUTHORIZE AN APPROPRIATE PERSON IN THEIR FIRM TO CERTIFY THESE REPORTS.
5. EROSION CONTROL DEVICES AS SHOWN ON THE EROSION CONTROL PLAN FOR THE PROJECT SHALL BE INSTALLED PRIOR TO THE START OF LAND DISTURBING ACTIVITIES ON THE PROJECT.
6. ALL EROSION CONTROL DEVICES ARE TO BE INSTALLED IN ACCORDANCE WITH THE APPROVED PLANS AND SPECIFICATIONS FOR THE PROJECT. CHANGES ARE TO BE APPROVED BEFORE CONSTRUCTION BY THE DESIGN ENGINEER AND THE TOWN OF ADDISON ENGINEERING DIVISION.
7. IF THE EROSION CONTROL PLAN CANNOT CONTROL EROSION AND OFF-SITE SEDIMENTATION FROM THE PROJECT THE EROSION CONTROL PLAN WILL BE REQUIRED TO BE REVISED AND/OR ADDITIONAL EROSION CONTROL DEVICES WILL BE REQUIRED ON SITE.
8. THE CONTRACTOR IS RESPONSIBLE FOR MAINTAINING SURFACE DRAINAGE AND EROSION CONTROL FACILITIES ON SITE DURING CONSTRUCTION.
9. THE CONTRACTOR IS RESPONSIBLE FOR KEEPING SIDEWALKS ADJACENT TO THE PROJECT FREE OF DIRT, MUD AND DEBRIS FROM THE CONSTRUCTION AT ALL TIMES.

AS BUILT PLANS

SEDIMENT BASIN & TRAP USAGE GUIDELINES

A sediment trap may be used to precipitate sediment out of runoff draining from an unstabilized area.

Traps: The drainage area for a sediment trap should not exceed 5 acres. The trap capacity should be 1800 CF/Acre (0.5" over the drainage area).

Sediment traps should be placed in the following locations:

1. Within drainage ditches spaced @ 500' on center
2. Immediately preceding ditch inlets
3. Just before the drainage enters a water course
4. Just before the drainage leaves the right of way

The trap should be cleaned when the capacity has been reduced by 1/2" or the sediment has accumulated to a depth of 1", whichever is less.

Cleaning and removal of accumulated sediment deposits is incidental and will not be paid for separately.

13-JUN-2006 10:54
G:\45601\Cad\Sheets\fwsw3p02.dgn

NO.	DATE	REVISION	APPROV.	NO.	DATE	REVISION	APPROV.

THE SEAL APPEARING ON THIS DOCUMENT WAS AUTHORIZED BY J.S. NICEWANDER, P.E., 87843 ON OCTOBER 26, 2007.



HNTB Corporation
The HNTB Companies
Engineers, Architects, Planners

DESIGN CHECK: JSN, MAH
DRAWN CHECK: CCH, MAH
DATE: SEPTEMBER 2007
SCALE:

PROJECT NO. 45601



TOWN OF ADDISON
TAXIWAY SIERRA

STORM WATER POLLUTION PREVENTION PLAN DETAILS

TOWN OF ADDISON, TEXAS

SHEET 28 OF 28
28
SW3P-2