

KELLER SPRINGS ROAD

CONSTRUCTION ENTRANCE FOR LIGHT TRUCKS ONLY

NOTES:

WORK IN PHASE I WILL BEGIN ON THE DATE SPECIFIED IN THE NOTICE TO PROCEED (NTP). CONTRACTOR MAY NOT PROCEED TO THE NEXT PHASE OF WORK UNTIL THE PREVIOUS PHASE HAS BEEN COMPLETED TO THE SATISFACTION OF ADDISON AIRPORT. THIS INCLUDES BUT IS NOT LIMITED TO SITE CLEAN UP, REMOVAL OF BARRICADES AND TEMPORARY PAVEMENT MARKING INSTALLATION AND REMOVAL.

THE CONTRACTOR WILL BE REQUIRED TO NOTIFY MR. JOEL JENKINSON, 972-392-4861, ADDISON AIRPORT OPERATIONS 14 DAYS PRIOR TO CONSTRUCTION TO ALLOW THE AIRPORT TO RELOCATE ANY AIRPLANES NECESSARY PRIOR TO CONSTRUCTION. CONTRACTOR WILL COORDINATE WITH THE ADDISON AIRPORT CONCERNING THE TEMPORARY RELOCATION OF AIRPLANES PARKED IN AFFECTED AREAS.

CONTRACTOR TO VERIFY LIMITS OF THE STAGING AREA WITH THE ADDISON AIRPORT AT THE PRE-CONSTRUCTION MEETING.

NIGHT WORK HOURS ARE BETWEEN 10:00 PM AND 6:00 AM. LIGHTED BARRICADES ARE REQUIRED TO BE INSTALLED AND MAINTAINED ALONG TAXIWAYS AND ADJACENT TO WORK AREAS.






AIRPORT PARKWAY


CONSTRUCTION ENTRANCE FOR HEAVY EQUIPMENT

ADDISON ROAD

AS BUILT PLANS

LEGEND


-  NIGHT WORK
-  PHASE I
-  PHASE II
-  STAGING AREA
-  CONTRACTOR HAUL ROUTE

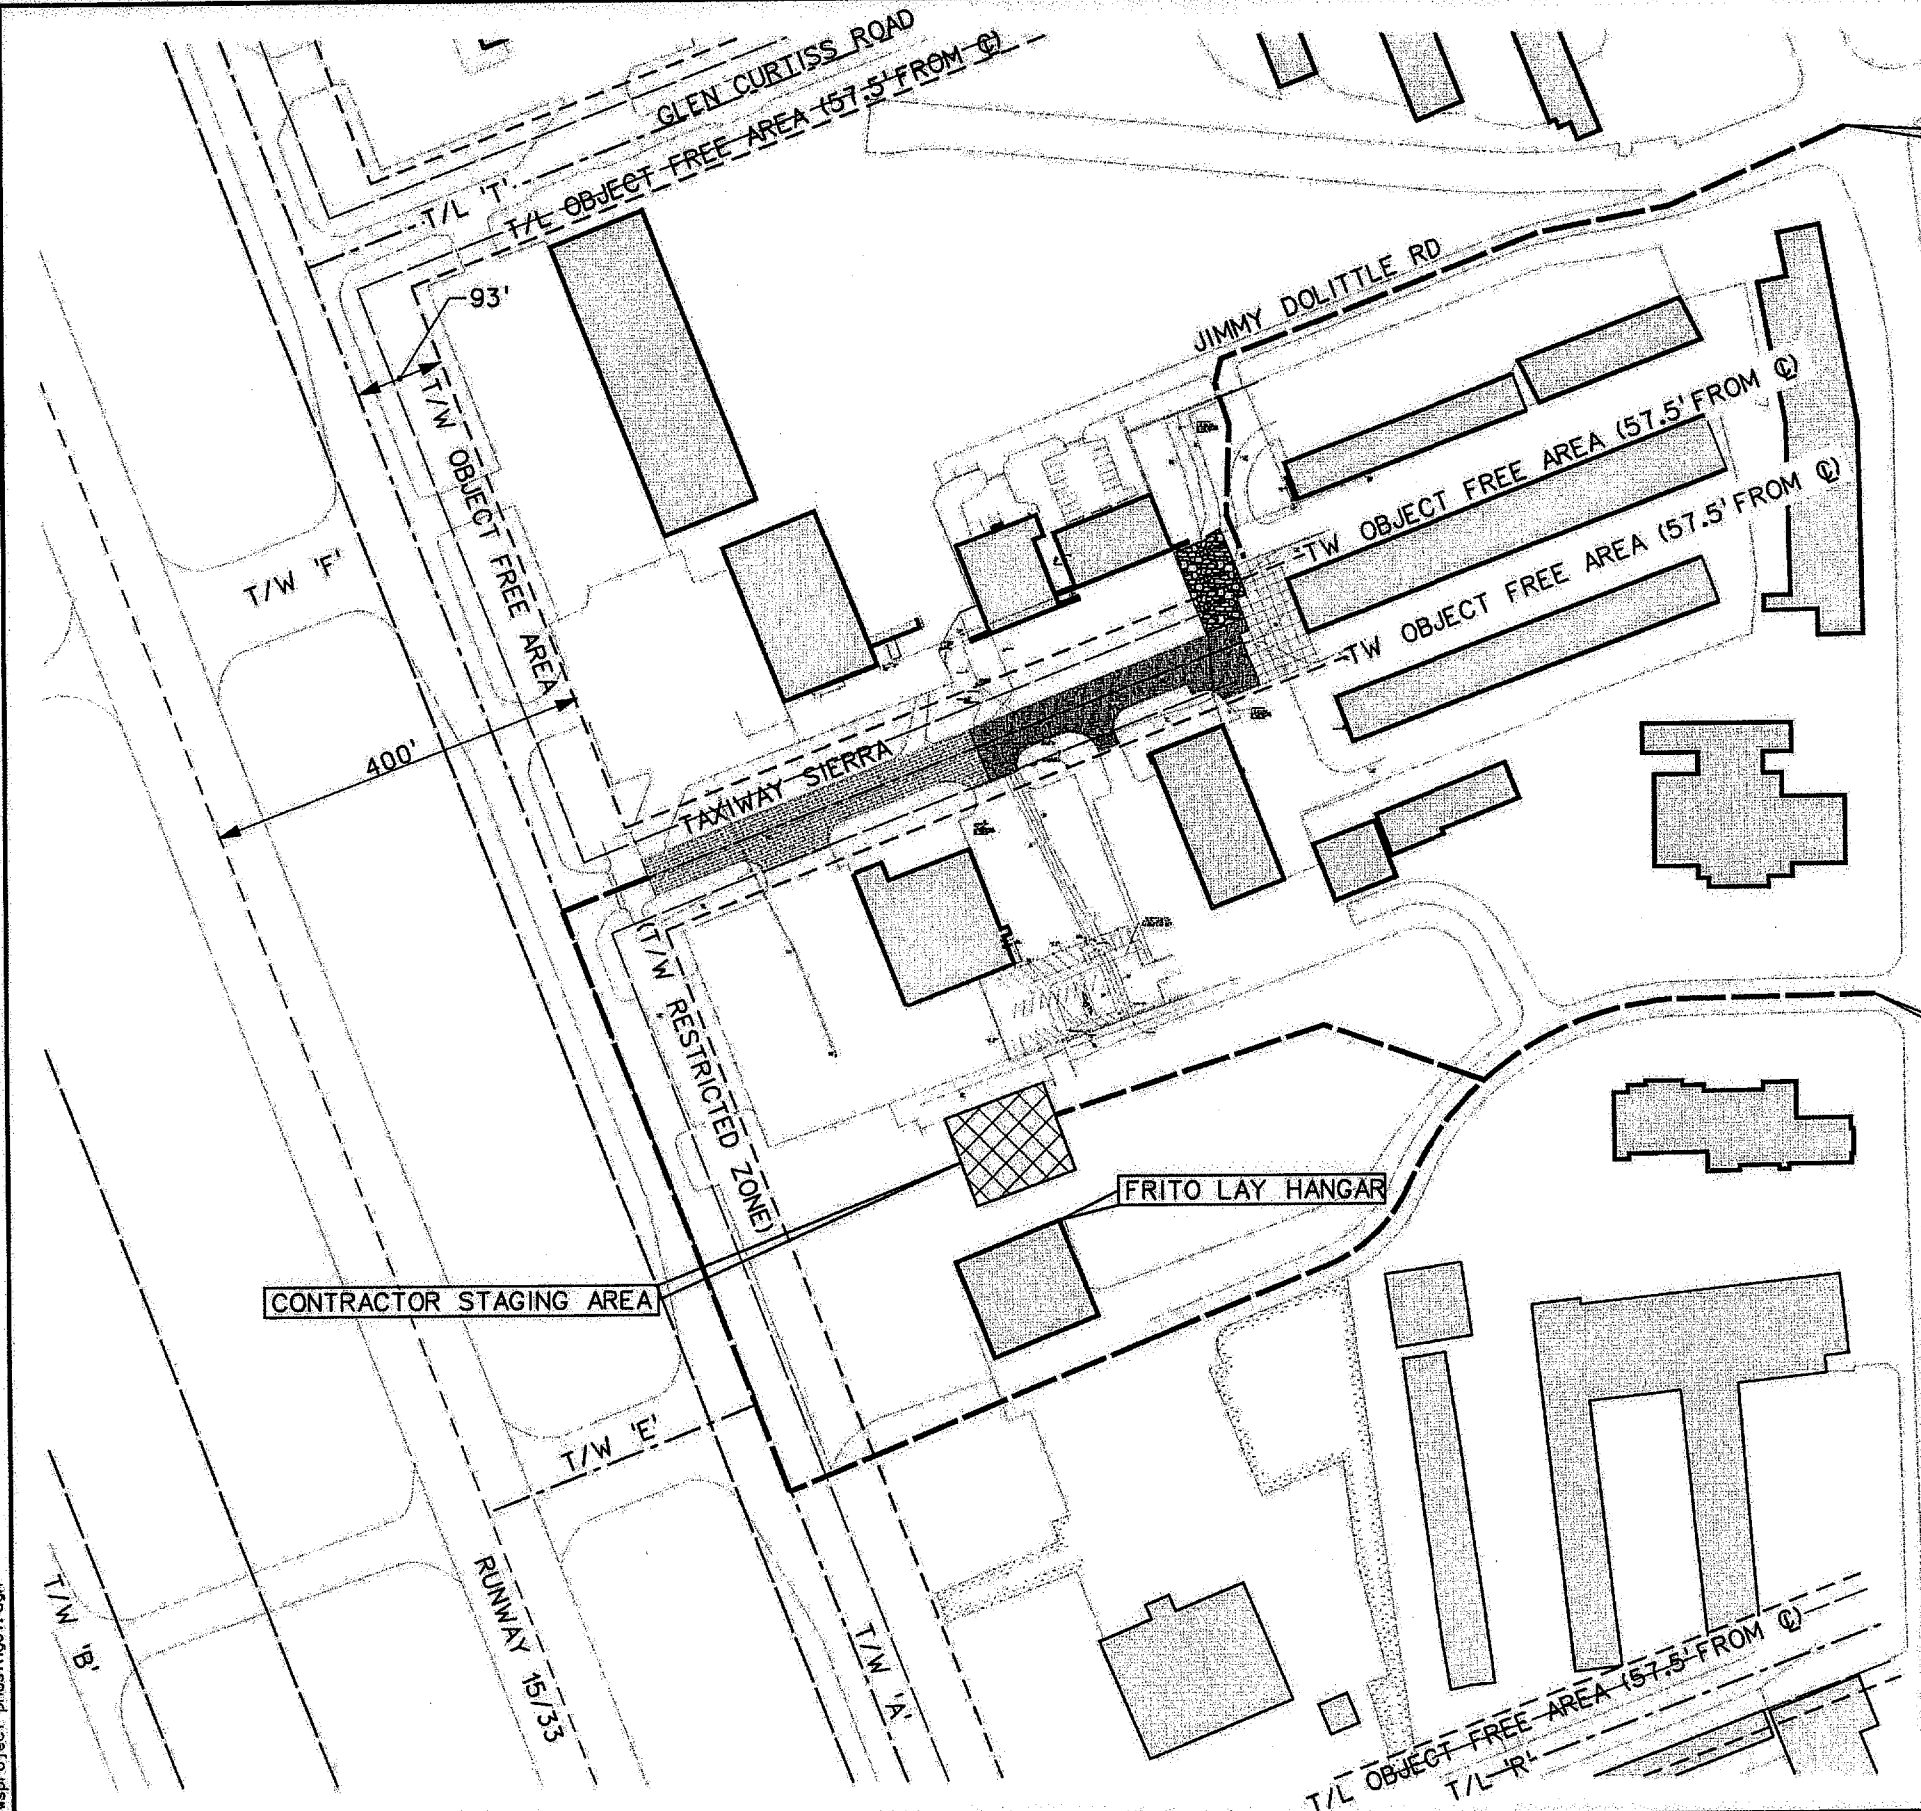

13-JUN-2008 10:52 G:\45601\Cad\Sheets\Twp\project_phasing01.dgn

NO.	DATE	REVISION	APPROV.	NO.	DATE	REVISION	APPROV.

THE SEAL APPEARING ON THIS DOCUMENT WAS AUTHORIZED BY J.S. NICEWANDER, P.E. 87843 ON OCTOBER 28, 2007.



HNTB
HNTB Corporation
The HNTB Companies
Engineers Architects Planners

DESIGN CHECK: JSN MAH
 DRAWN CHECK: CCH MAH
 DATE: SEPTEMBER 2007
 SCALE: 1"=400'

PROJECT NO. 45601



TOWN OF ADDISON		SHEET 6 OF 28
TAXIWAY SIERRA		
PROJECT PHASING PLAN		6
TOWN OF ADDISON, TEXAS		PH-1