

ADDISON MUNICIPAL AIRPORT ADDITION

BLOCK 1



LOT 1

EXISTING

PROPOSED

AIRPORT SOUTH MAIN RUNWAY

SOUTH WATER MATCH LINE STA. 5+00
N 9087.2003, E 9231.1936

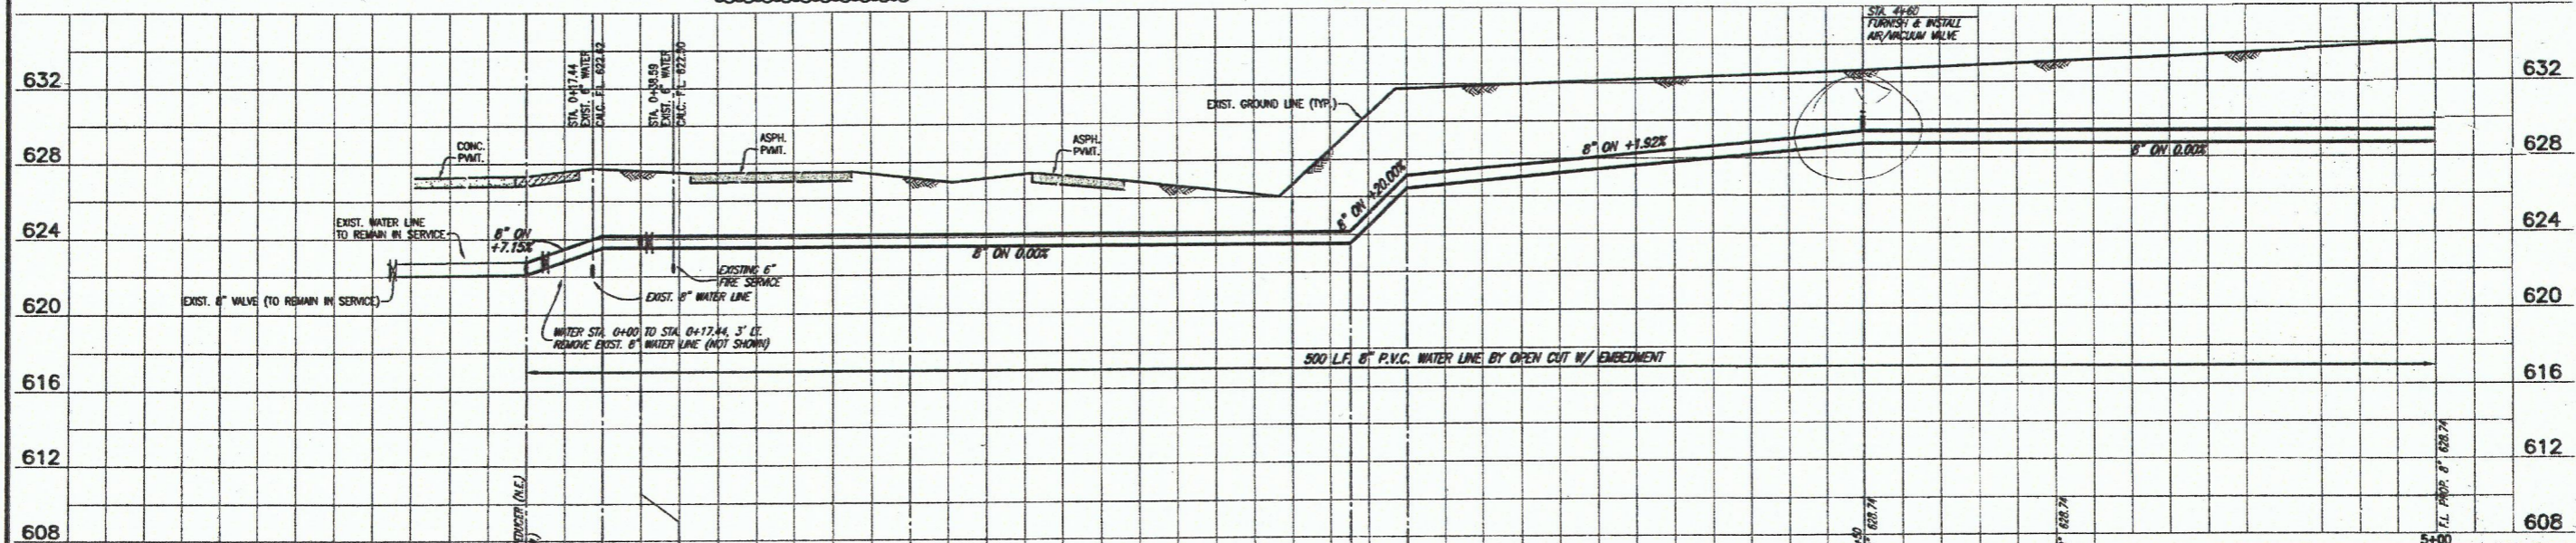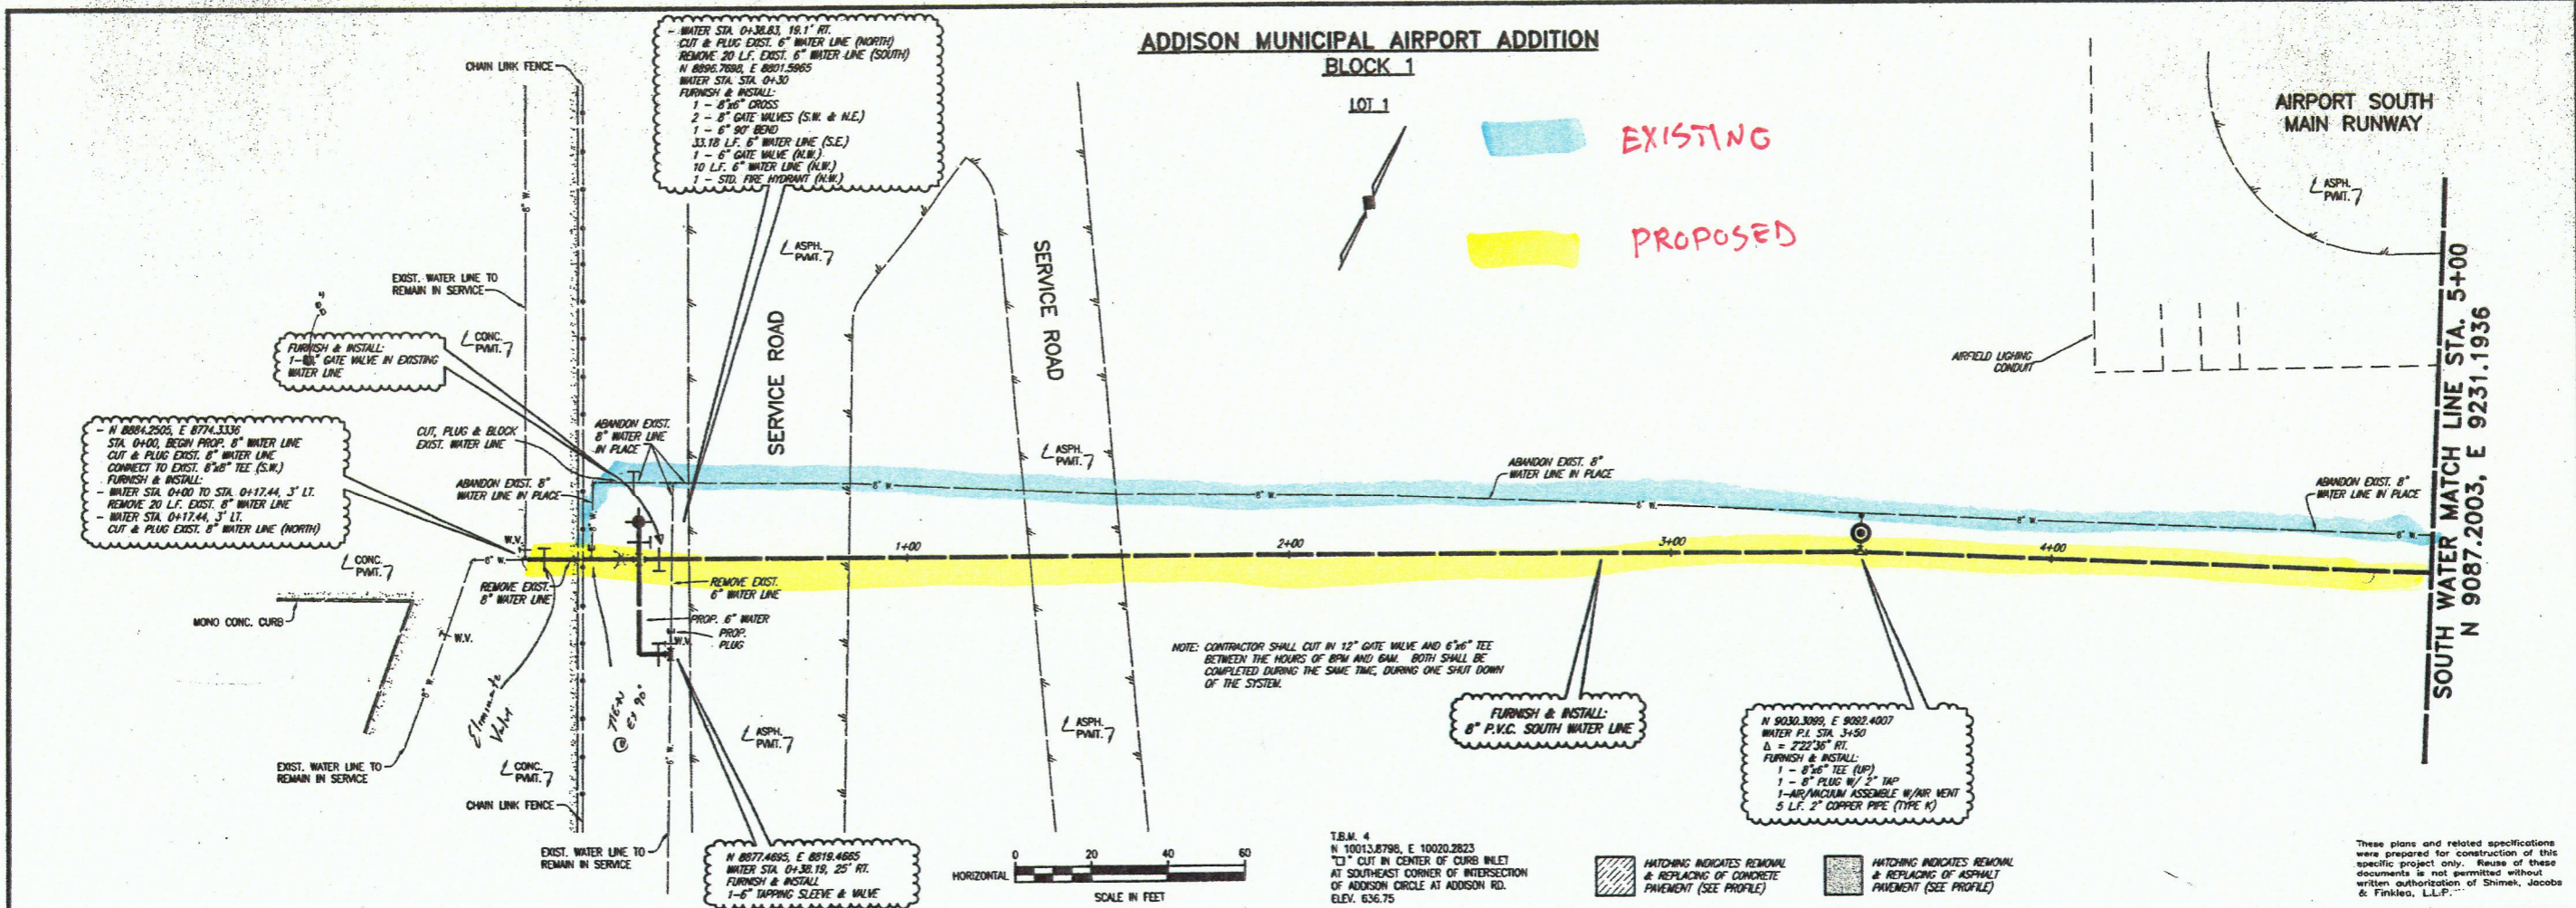

TOWN OF ADDISON, TEXAS

ADDISON AIRPORT SANITARY SEWER & WATER MAIN REPLACEMENT

SOUTH AIRPORT WATER LINE PLAN - PROFILE

STA. 0+00 TO STA. 5+00

SHIMEK, JACOBS & FINKLEA, L.L.P.
CONSULTING ENGINEERS
Dallas, Texas

DESIGNED BY: J.W.B. PROJECT: 96 169 SHEET NO. 18
DRAWN BY: S.J. & F. DATE: FEBRUARY 1997 OF 24 SHEETS

THESE DOCUMENTS ARE FOR BIDDING, CONSTRUCTION, AND PERMIT PURPOSES.
DATE: 2/5/97

STATE OF TEXAS
JOHN B. BISHOP
REGISTERED PROFESSIONAL ENGINEER